


**SURVEY OF ACREAGE PARCEL**  
**QUARTER TOWNSHIP 2, SECTION 4,**  
**TOWNSHIP 2, RANGE 16**  
**UNITED STATES MILITARY LANDS**  
**PLAIN TOWNSHIP, FRANKLIN COUNTY, OHIO**

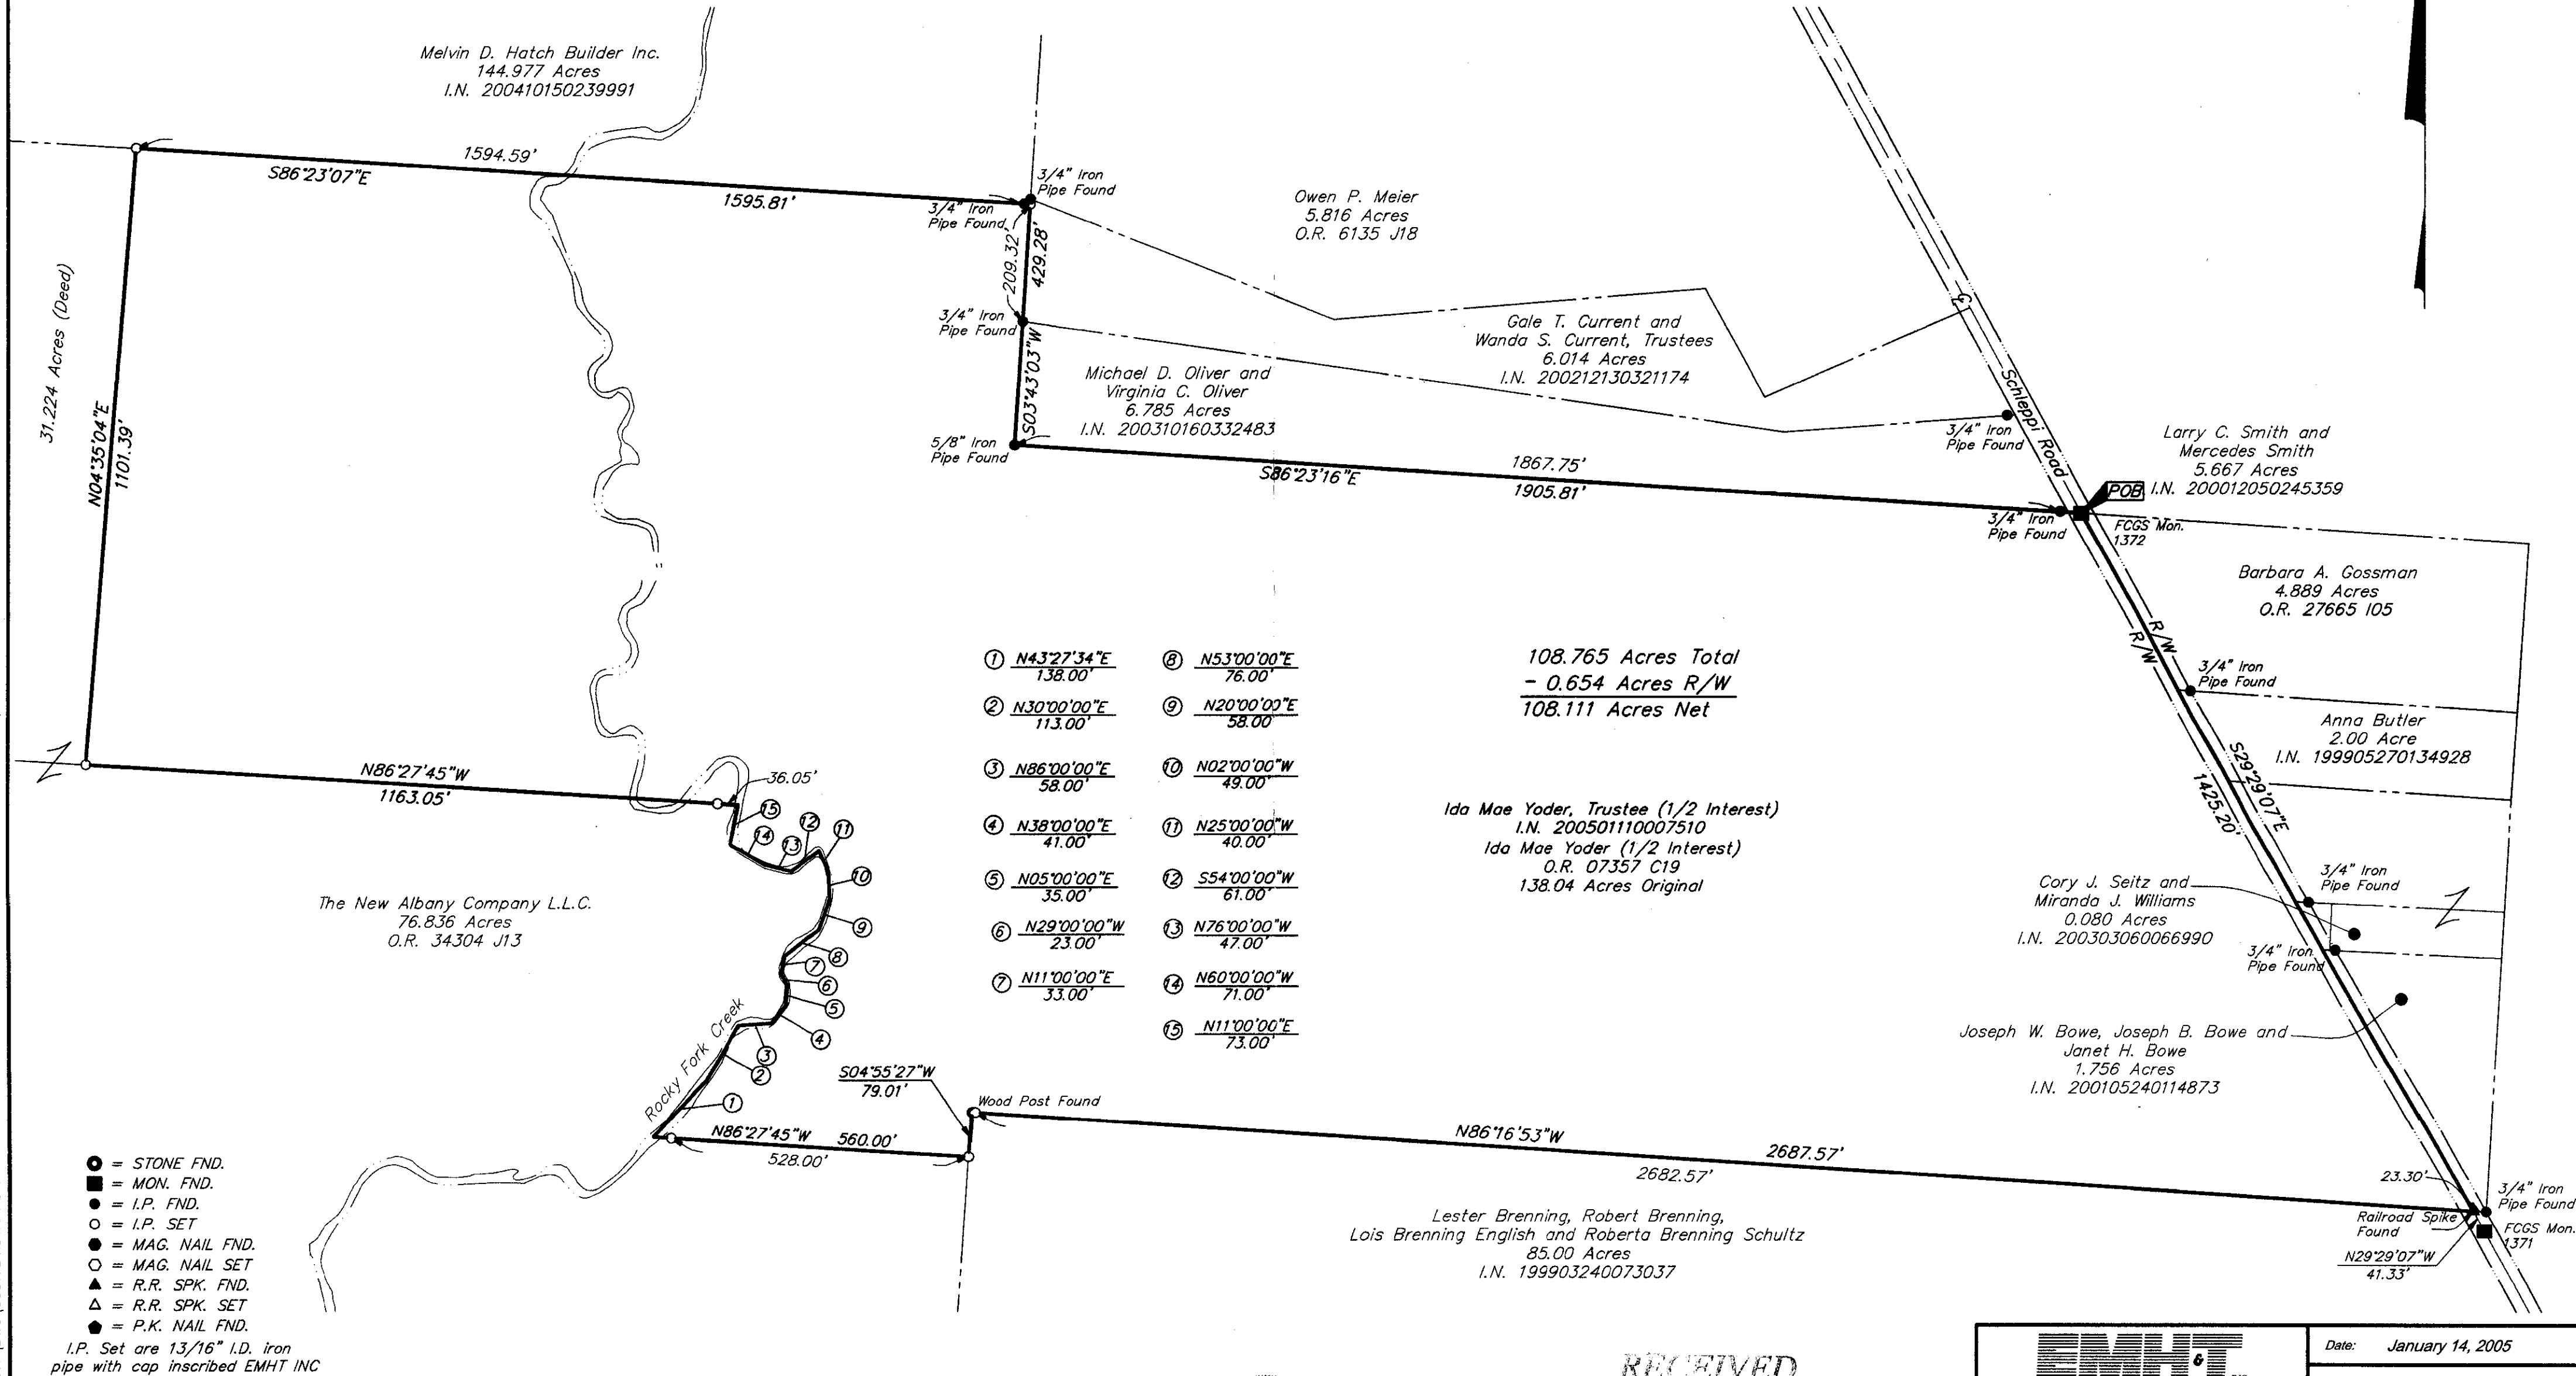

- |                          |                         |
|--------------------------|-------------------------|
| ① N43°27'34"E<br>138.00' | ⑧ N53°00'00"E<br>76.00' |
| ② N30°00'00"E<br>113.00' | ⑨ N20°00'00"E<br>58.00' |
| ③ N86°00'00"E<br>58.00'  | ⑩ N02°00'00"W<br>49.00' |
| ④ N38°00'00"E<br>41.00'  | ⑪ N25°00'00"W<br>40.00' |
| ⑤ N05°00'00"E<br>35.00'  | ⑫ S54°00'00"W<br>61.00' |
| ⑥ N29°00'00"W<br>23.00'  | ⑬ N76°00'00"W<br>47.00' |
| ⑦ N11°00'00"E<br>33.00'  | ⑭ N60°00'00"W<br>71.00' |
|                          | ⑮ N11°00'00"E<br>73.00' |



108.765 Acres Total  
 - 0.654 Acres R/W  
 108.111 Acres Net

Ida Mae Yoder, Trustee (1/2 Interest)  
 I.N. 200501110007510  
 Ida Mae Yoder (1/2 Interest)  
 O.R. 07357 C19  
 138.04 Acres Original

Lester Brenning, Robert Brenning,  
 Lois Brenning English and Roberta Brenning Schultz  
 85.00 Acres  
 I.N. 199903240073037

● = STONE FND.  
 ■ = MON. FND.  
 ○ = I.P. FND.  
 ○ = I.P. SET  
 ● = MAG. NAIL FND.  
 ○ = MAG. NAIL SET  
 ▲ = R.R. SPK. FND.  
 ▲ = R.R. SPK. SET  
 ● = P.K. NAIL FND.  
 I.P. Set are 13/16" I.D. iron pipe with cap inscribed EMHT INC

**BASIS OF BEARINGS:** Bearings are based on the Ohio State Plane Coordinate System as per NAD83. Control for bearings was from coordinates of monuments 183 and F.C.G.S. 3327 established by the Franklin County Engineering Department, using Global Positioning System procedures and equipment in which the bearing between monuments is North 03°07'31" East.

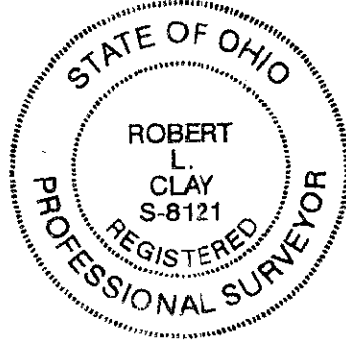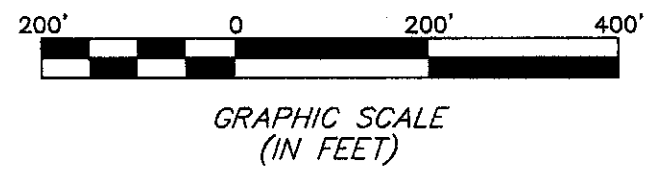

**RECEIVED**  
 JAN 18 2005  
 Franklin County Engineer  
 Dean C. Ringle, P.E., P.S.

By: *Robert L. Clay* January 15, 2005  
 Professional Surveyor No. 8121

 ENGINEERS, SURVEYORS, PLANNERS, SCIENTISTS EVANS, MECHWART, HAMBLETON & TILTON, INC. 170 MILL STREET GAHANNA, OHIO 43230 TELEPHONE (614) 471-5150 FACSIMILE (614) 471-9286		Date: January 14, 2005
		Scale: 1" = 100'
		Job No: 2005-0017
		Sheet: 1 of 1
REVISIONS		
MARK	DATE	DESCRIPTION
JAP	1/14/05	Edits per Franklin County Engineer

I:\CHMDATA\1\SURVEY\PROJECT\20050017\DWG\50017BV.DWG<18x24 LANDSCAPE> - NO XREFS - PLOTTED BY: JPLANTZ - FRIDAY, JAN 14 2005 - 4:39:42 PM