# SURVEY OF ACREAGE PARCEL
## HALF-SECTION 12 OF SECTION 6, QUARTER TOWNSHIP 2, TOWNSHIP 2, RANGE 16
## UNITED STATES MILITARY LANDS
### CITY OF COLUMBUS, FRANKLIN COUNTY, OHIO




- = STONE FND.
- = MON. FND.
- = I.P. FND.
- = I.P. SET
- = MAG. NAIL FND.
- = MAG. NAIL SET
- = R.R. SPK. FND.
- = R.R. SPK. SET
- = P.K. NAIL FND.

I.P. Set are 13/16" I.D. iron pipe with cap inscribed EMHT INC

50' 0 50' 100'

GRAPHIC SCALE (IN FEET)

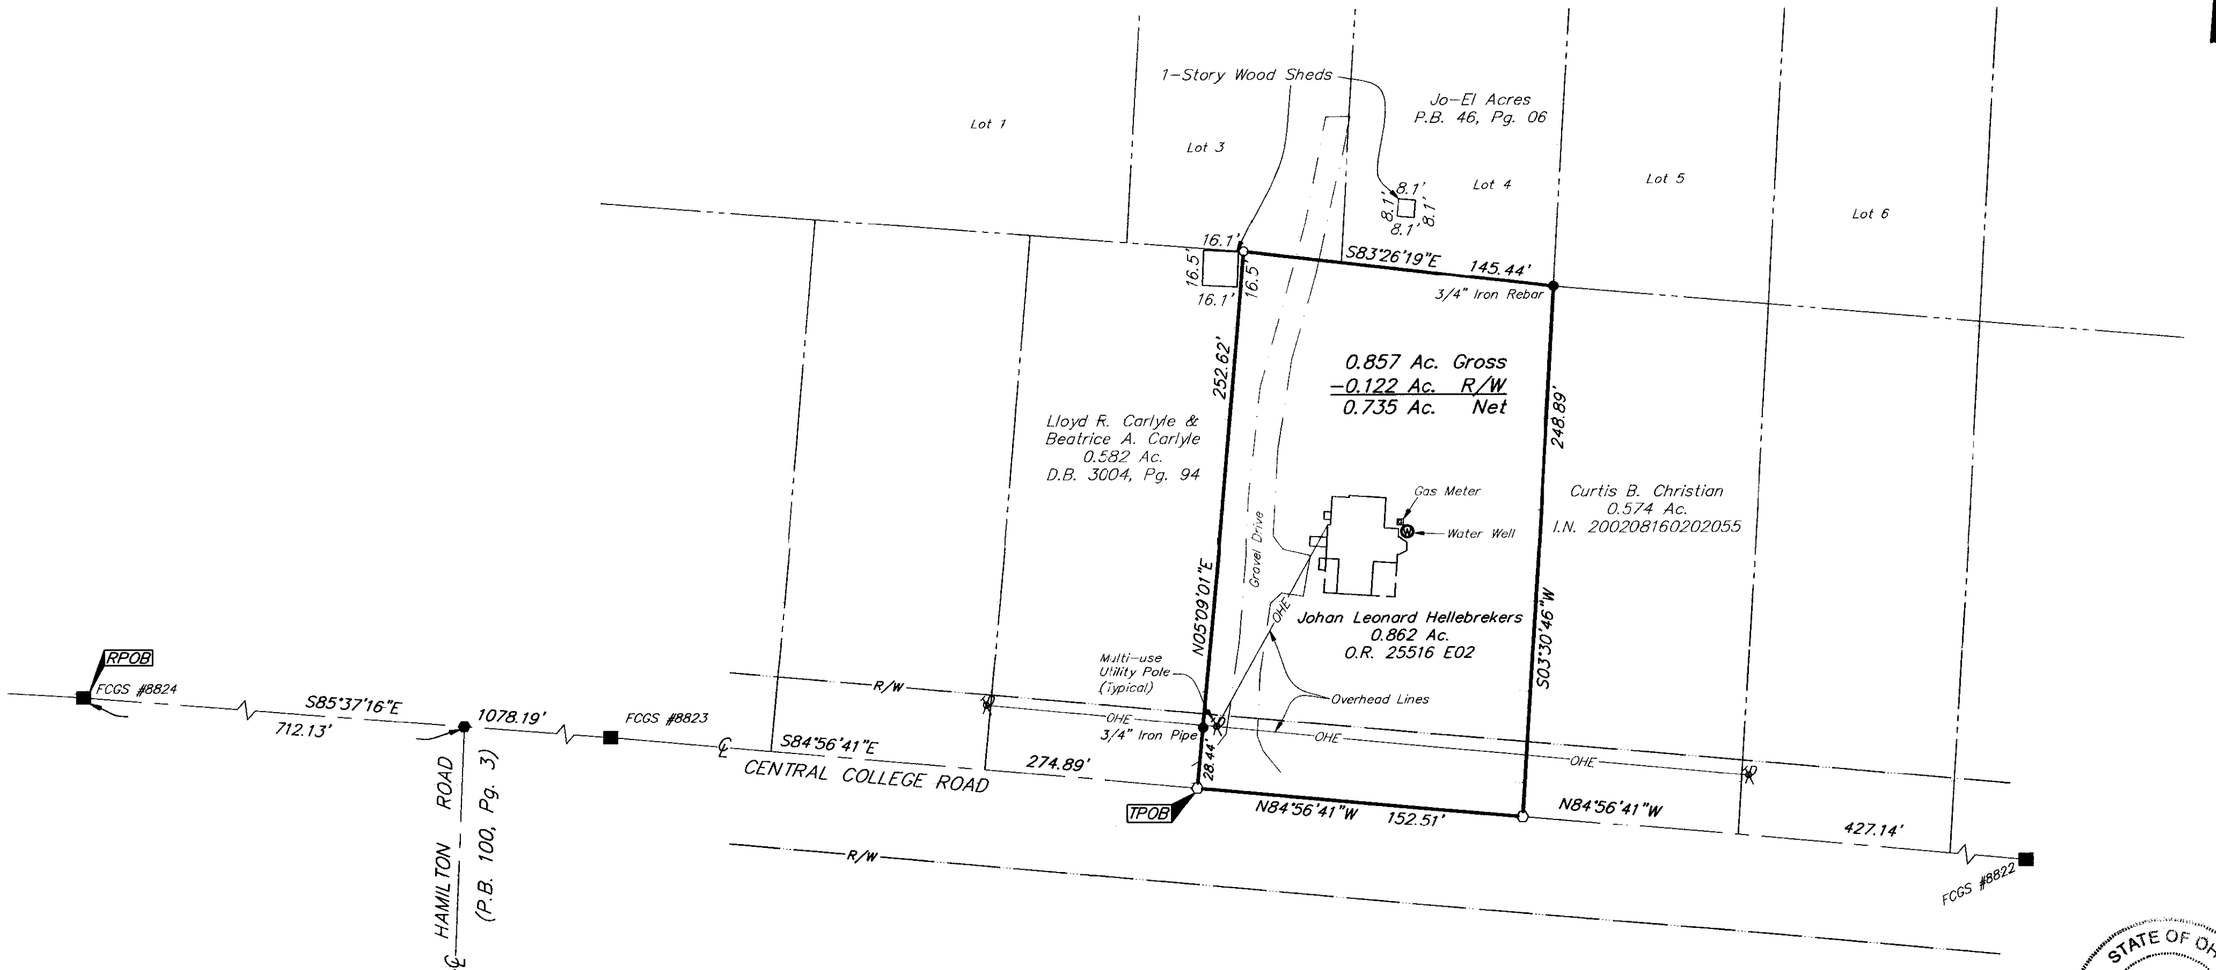


Building Detail
Not to Scale

BASIS OF BEARINGS: Bearings are based on the Ohio State Coordinate System, NAD83 (1986 Adjustment). Control for bearings was derived, using Global Positioning System procedures and equipment, from coordinates for FCGS monuments 8824 & 8825, having a bearing of North 86° 29' 28" West, as established by the Franklin County Engineering Department.

STATE OF OHIO
ROBERT L. CLAY
S-8121
REGISTERED
PROFESSIONAL SURVEYOR

RECEIVED
FEB 25 2005
Franklin County Engineer
Dean C. Bingle, P.E., P.S.

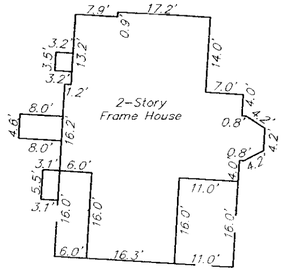By: Robert L. Clay February 24, 2005
Professional Surveyor No. 8121

EMHT INC.
ENGINEERS, SURVEYORS, PLANNERS, SCIENTISTS
EVANS, MECHWART, HAMBLETON & TILTON, INC.
170 MILL STREET
GAHANNA, OHIO 43230
TELEPHONE (614) 471-5150
FACSIMILE (614) 471-9286

| | |
|---|---|
| Date: | February 24, 2005 |
| Scale: | 1" = 50' |
| Job No: | 2005-0366 |
| Sheet: | 1 of 1 |

REVISIONS

| MARK | DATE | DESCRIPTION |
|---|---|---|
| | | |
| | | |
| | | |
| | | |
| | | |
| | | |

Homewood Corp. / Hellebrekers Tract / 2005-0366 / 50366BV

\\CMHDATA1\SURVEY\PROJECT\20050366\DWG\50366BV.DWG<18X24> - NO XREFS - PLOTTED BY: TWEBB - THURSDAY, FEB 24 2005 - 2:38:16 PM