


Hayes Road

Boundary Survey of Remaining Land

Section 3, Township 10 North, Range 21 West of the Buckingham Survey of the Congress Lands

Madison Township, Franklin County, Ohio

RECEIVED
DEC 13 2005
Franklin County Engineer
Dean C. Ringle, P.E., P.S.

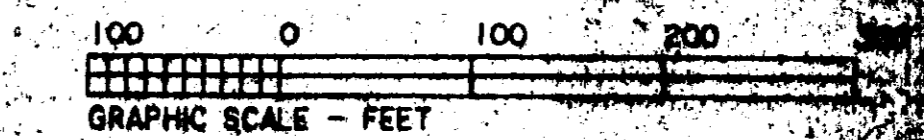

Richardson Road

Top 11.15

106.70'

29.90'

N 00°14'27"E 80.83'

3/4 inch iron pipe

3/4 inch iron pipe

3/4 inch iron pipe

3/4 inch iron pipe

3/4 inch iron pipe

3/4 inch iron pipe

3/4 inch iron pipe

3/4 inch iron pipe

3/4 inch iron pipe

3/4 inch iron pipe

3/4 inch iron pipe

3/4 inch iron pipe

3/4 inch iron pipe

Charles H. III & Marylee L. Bendig
Official Record 16983106

Charles H. III & Marylee L. Bendig
Official Record 16983106

Bradley Timmons
Official Record 9462006

Brandon S. Geary
Instrument Number 200608300178619

John E. & Geraldine L. McDowell
Official Record 9387004

Larry R. & Ava D. Yinger
Instrument Number 200402180034124

Jerry L. & Christina M. Wise
Official Record 17835002


Jerry and Tammy L. Freck
Official Record 26688117

Harvey E. Allensworth et al
Official Record 23139119

Dennis L. & Edna E. Jones
Official Record 133081008

Gary L. & Trena M. England
Instrument Number 200308180183389

Century Acres
Section 2
Plat Book 51, Page 21

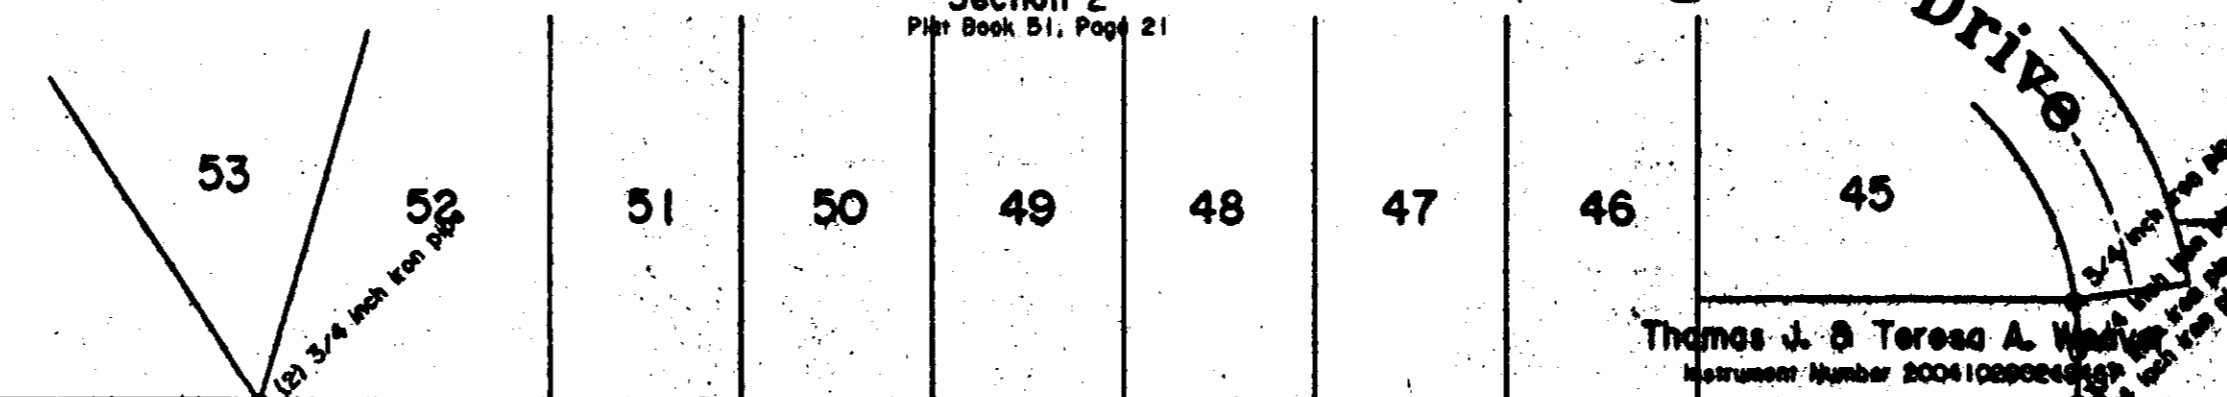

Lot 1
Complete Record 22, Page 71
of Court of Common Pleas of Franklin County, Ohio

Dale N. & Annabel F. Goodman
Deed Book 3731, Page 360

61.2462 Acres

Lot 2
Complete Record 22, Page 71
of Court of Common Pleas of Franklin County, Ohio

Bruce E. & Shayna M. Griffin
Instrument Number 200402110030478

Lot 3
Complete Record 22, Page 71
of Court of Common Pleas of Franklin County, Ohio

- LEGEND**
- Iron Pipe or Bar
 - 3/4 inch iron pipe
 - ▲ Surveyed Iron Pipe
 - ▲ Magnetite Iron Pipe
 - Stone Found
 - ⊙ Concrete Monument with metal cap
 - Drill Hole



AHLERS, MOE & ASSOC. INC.
Engineers & Surveyors
360 West Waterloo Street
Canal Winchester, Ohio 43118
(614) 837-1178