

# EMHT

Evans, Mechwart, Hambleton & Tilton, Inc.  
Engineers • Surveyors • Planners • Scientists  
5500 New Albany Road, Columbus, OH 43054  
Phone: 614.775.4500 Fax: 614.775.4800


## SURVEY OF ACREAGE PARCELS VIRGINIA MILITARY SURVEY NO. 3315

TOWNSHIP OF FRANKLIN & CITY OF COLUMBUS, FRANKLIN COUNTY, OHIO

Date: February 24, 2006

Scale: 1" = 100'


Job No: 2006-0419

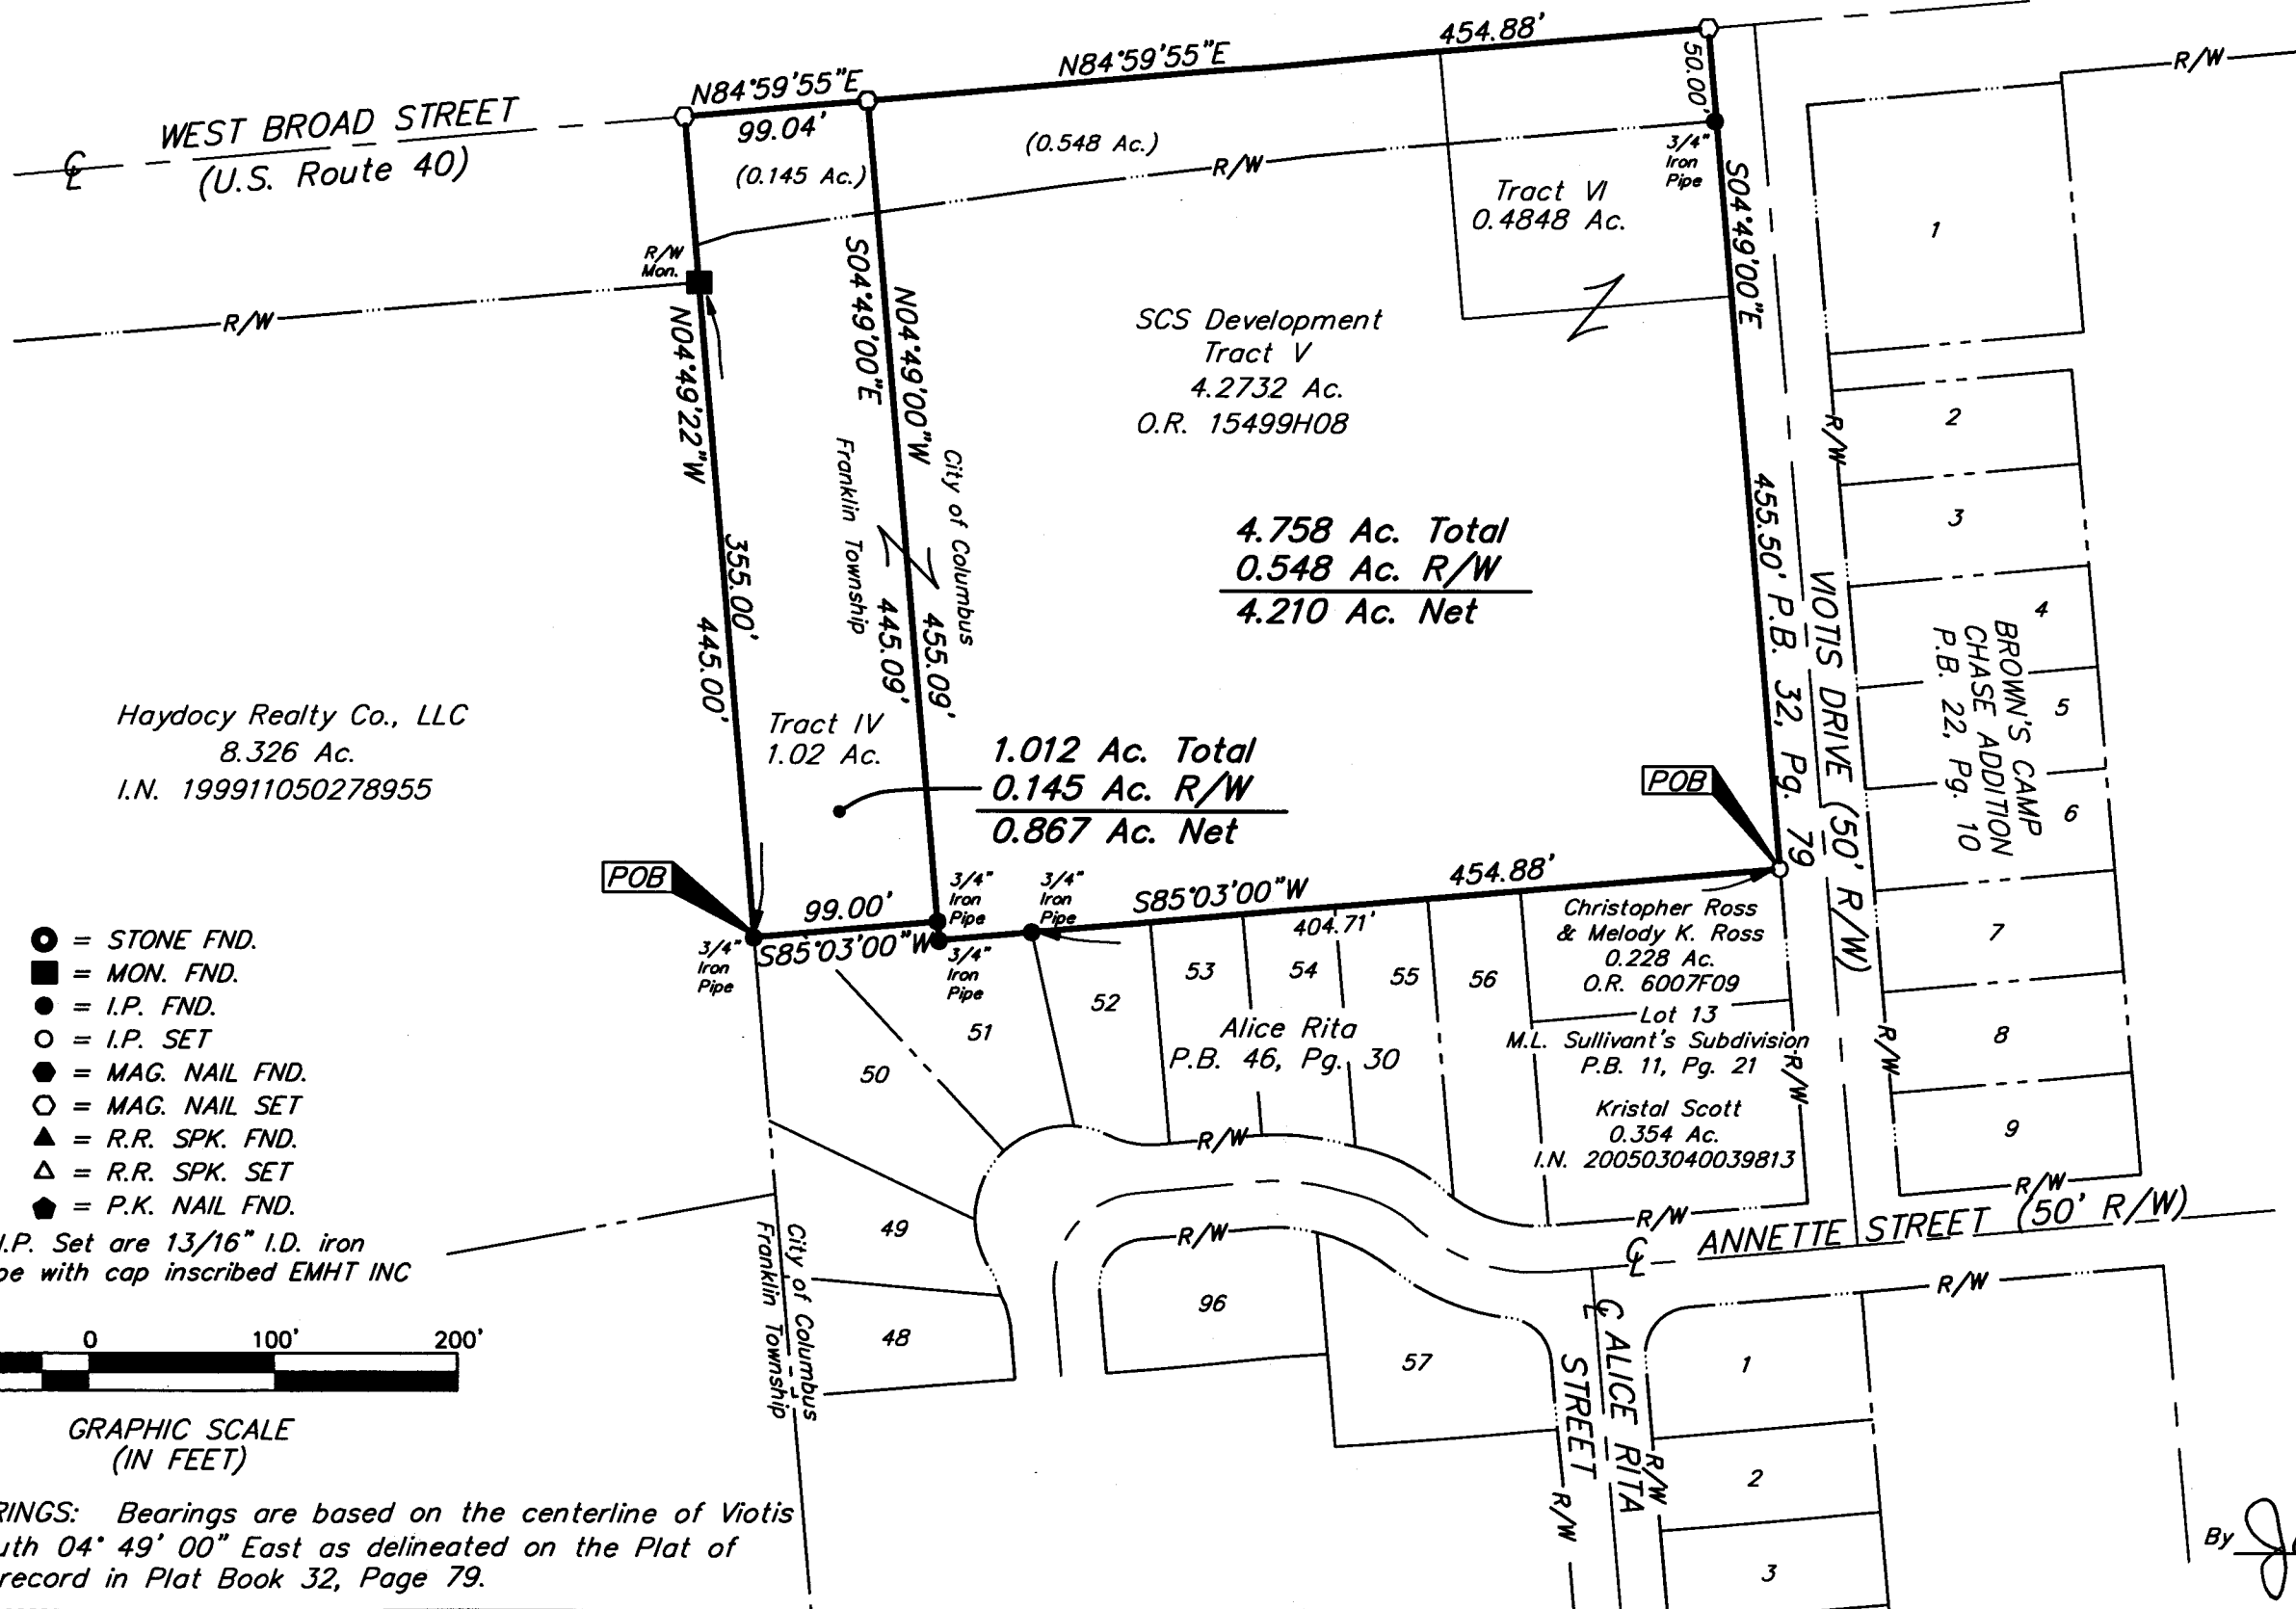

### RECEIVED

FEB 27 2006

Franklin County Engineer  
Dean C. Ringle, PE., PS.

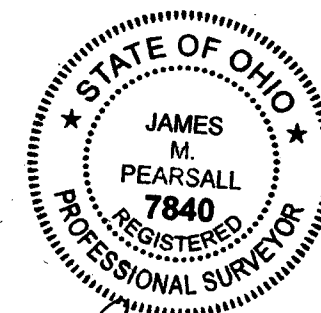

By *James M. Pearsall* 2/24/06  
Professional Surveyor No. 7840



GRAPHIC SCALE  
(IN FEET)

**BASIS OF BEARINGS:** Bearings are based on the centerline of Viotis Drive being South 04° 49' 00" East as delineated on the Plat of Viotis Drive of record in Plat Book 32, Page 79.

I:\CADD\DATA1\SURVEY\PROJ\20060419\DWG\60419BV.DWG-11X17 LAND CANNONS - NO XREES - LAST SAVED BY HKING [2/27/2006 9:32:21 AM] - PLOTTED BY HKING [2/27/2006 9:32:22 AM]