SURVEY OF ACREAGE PARCELS

VIRGINIA MILITARY SURVEY No. 1434

CITY OF GROVE CITY, FRANKLIN COUNTY, OHIO

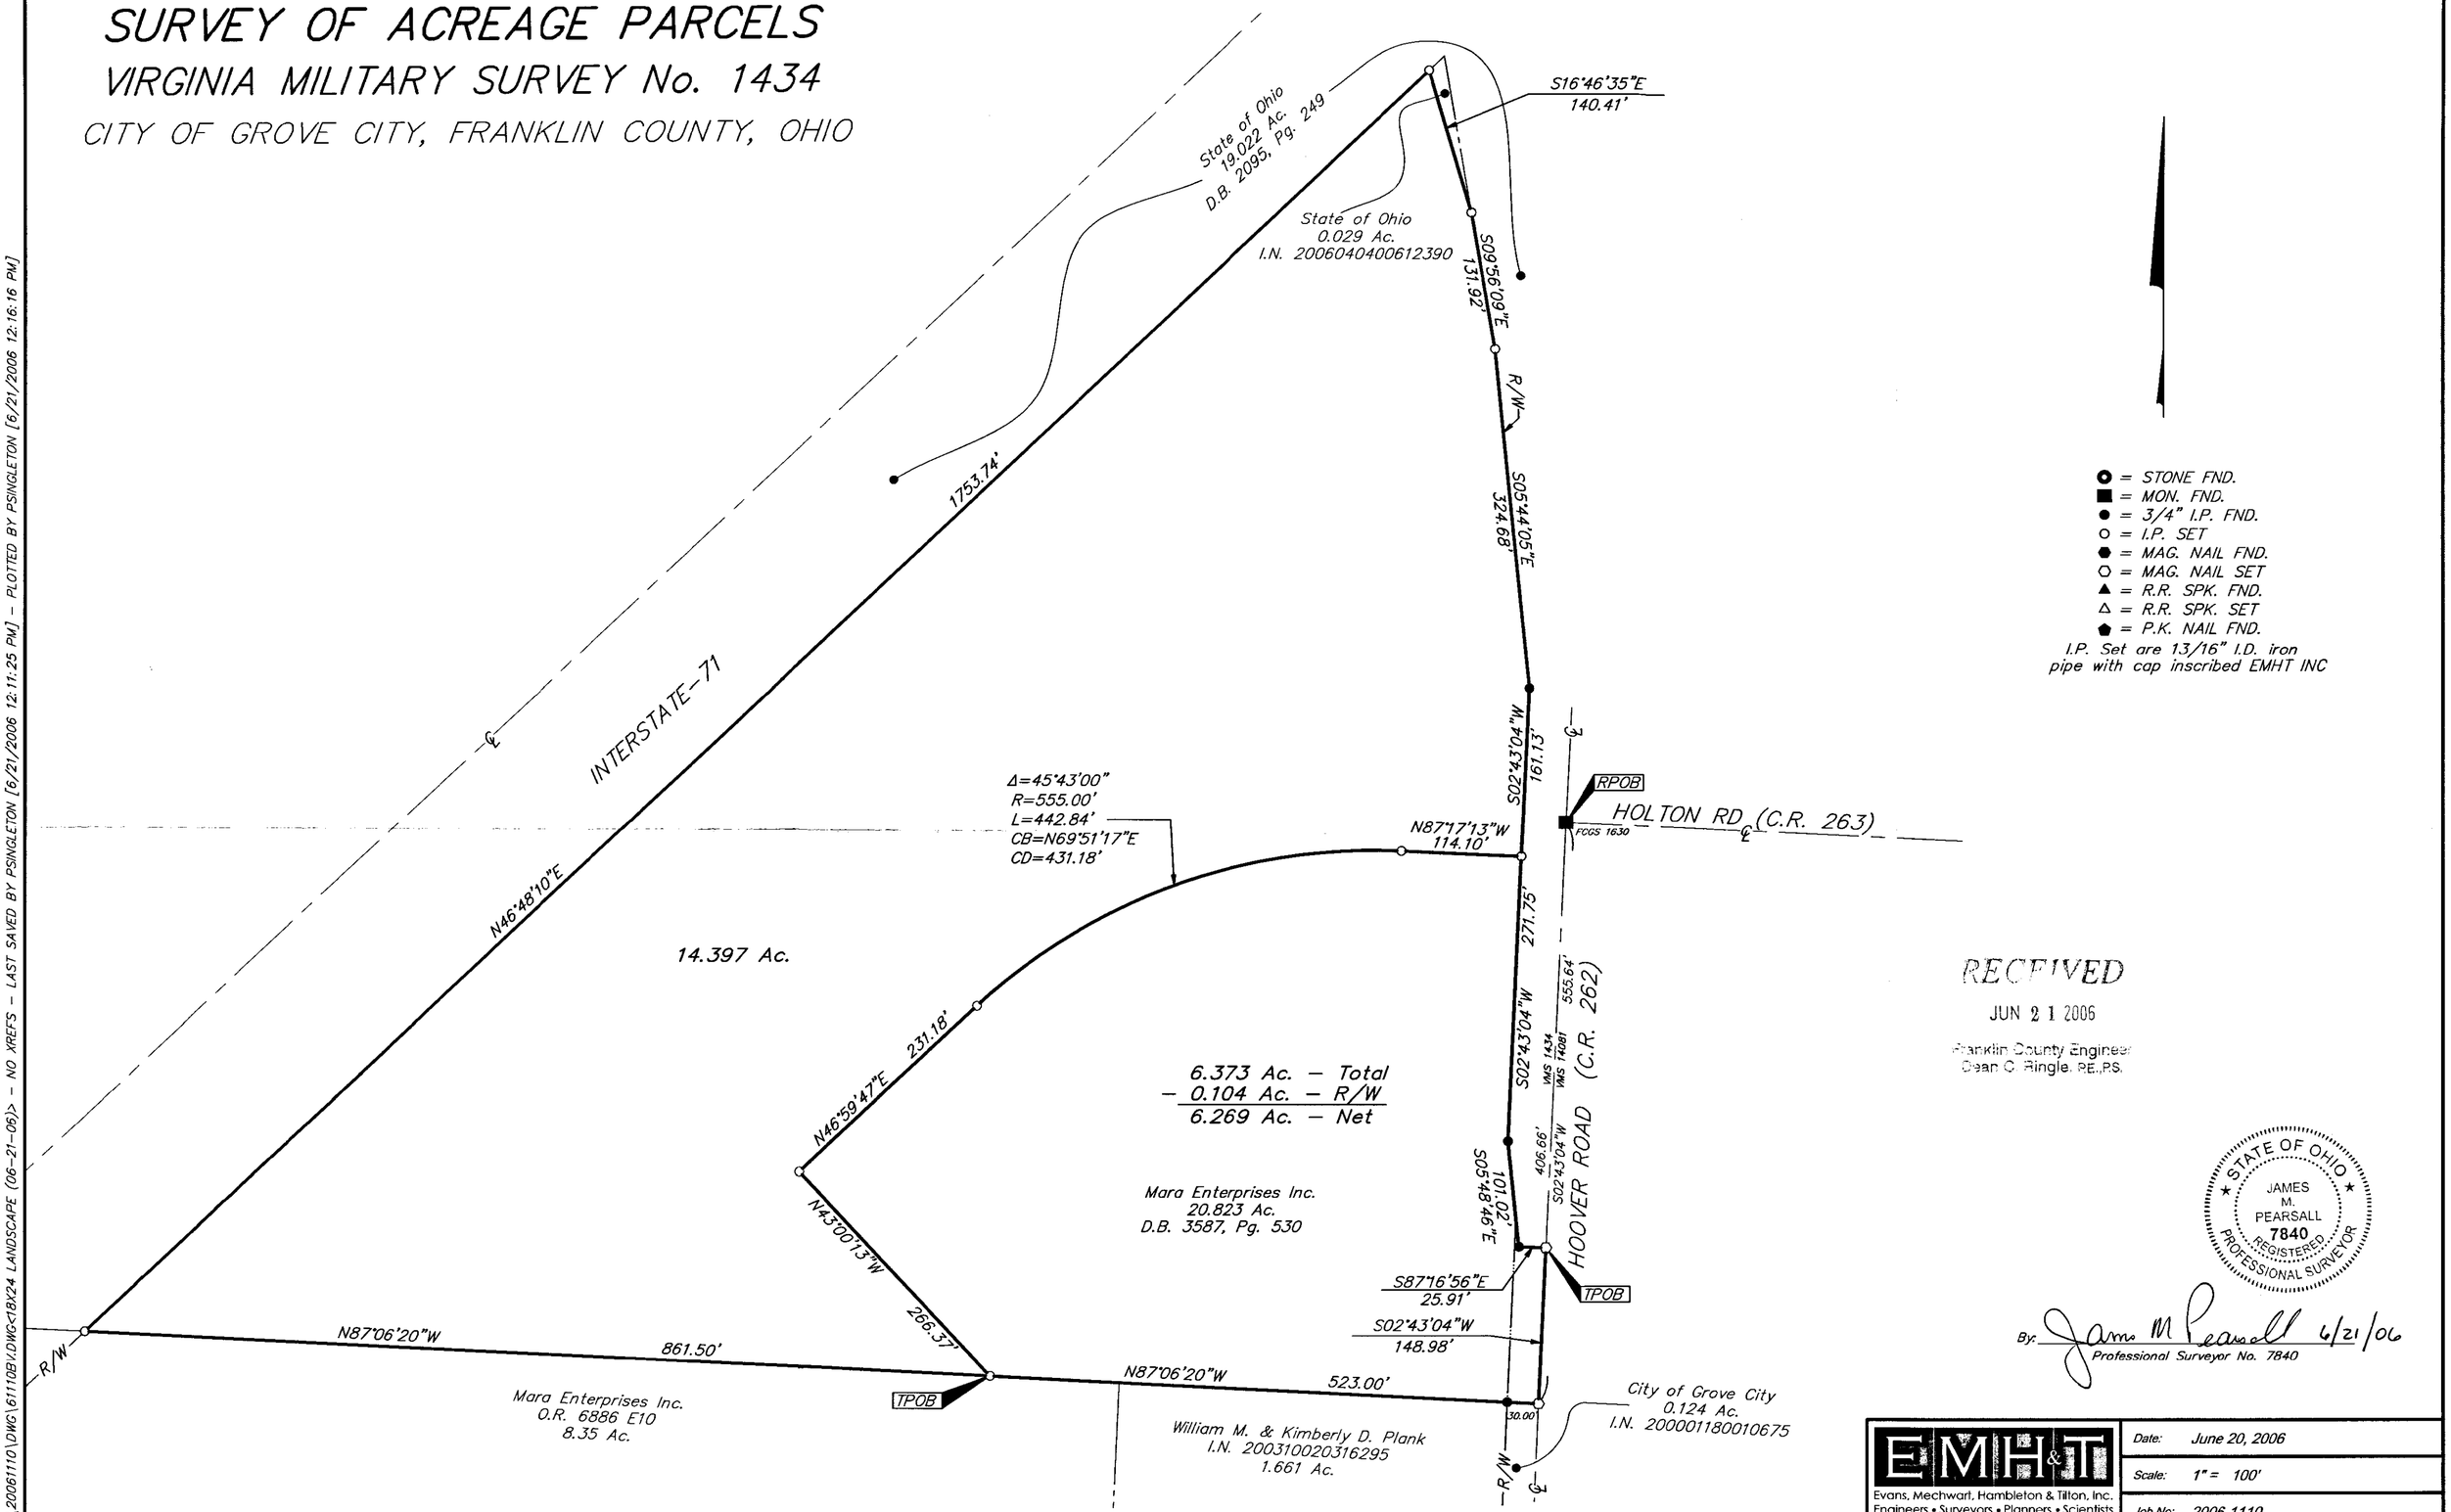

○ = STONE FND.
■ = MON. FND.
● = 3/4" I.P. FND.
○ = I.P. SET
⬟ = MAG. NAIL FND.
⬡ = MAG. NAIL SET
▲ = R.R. SPK. FND.
△ = R.R. SPK. SET
⬟ = P.K. NAIL FND.

I.P. Set are 13/16" I.D. iron pipe with cap inscribed EMHT INC

RECEIVED
JUN 21 2006
Franklin County Engineer
Dean C. Ringle, P.E., P.S.

STATE OF OHIO
JAMES M. PEARSALL
7840
REGISTERED PROFESSIONAL SURVEYOR

By: James M Pearsall 6/21/06
Professional Surveyor No. 7840

100' 0 100' 200'
GRAPHIC SCALE (IN FEET)

BASIS OF BEARINGS: Bearings are based on the Ohio State Plane Coordinate System (South Zone) as per NAD83 (1986 Adjustment). Control for bearings was from coordinates of monuments Jackson & Jackson Azimuth, established by the Franklin County Engineering Department, using Global Positioning System procedures and equipment.

EMH&T
Evans, Mechwart, Hambleton & Tilton, Inc.
Engineers • Surveyors • Planners • Scientists
5500 New Albany Road, Columbus, OH 43054
Phone: 614.775.4500 Fax: 614.775.4800
M C M X X V I

Date:	June 20, 2006
Scale:	1" = 100'
Job No:	2006-1110
Sheet:	1 of 1

REVISIONS

MARK	DATE	DESCRIPTION

\\CMHDATA1\SURVEY\PROJECT\20061110\DWG\61110BV.DWG<18X24 LANDSCAPE (06-21-06)> - NO XREFS - LAST SAVED BY PSINGLETON [6/21/2006 12:11:25 PM] - PLOTTED BY PSINGLETON [6/21/2006 12:16:16 PM]