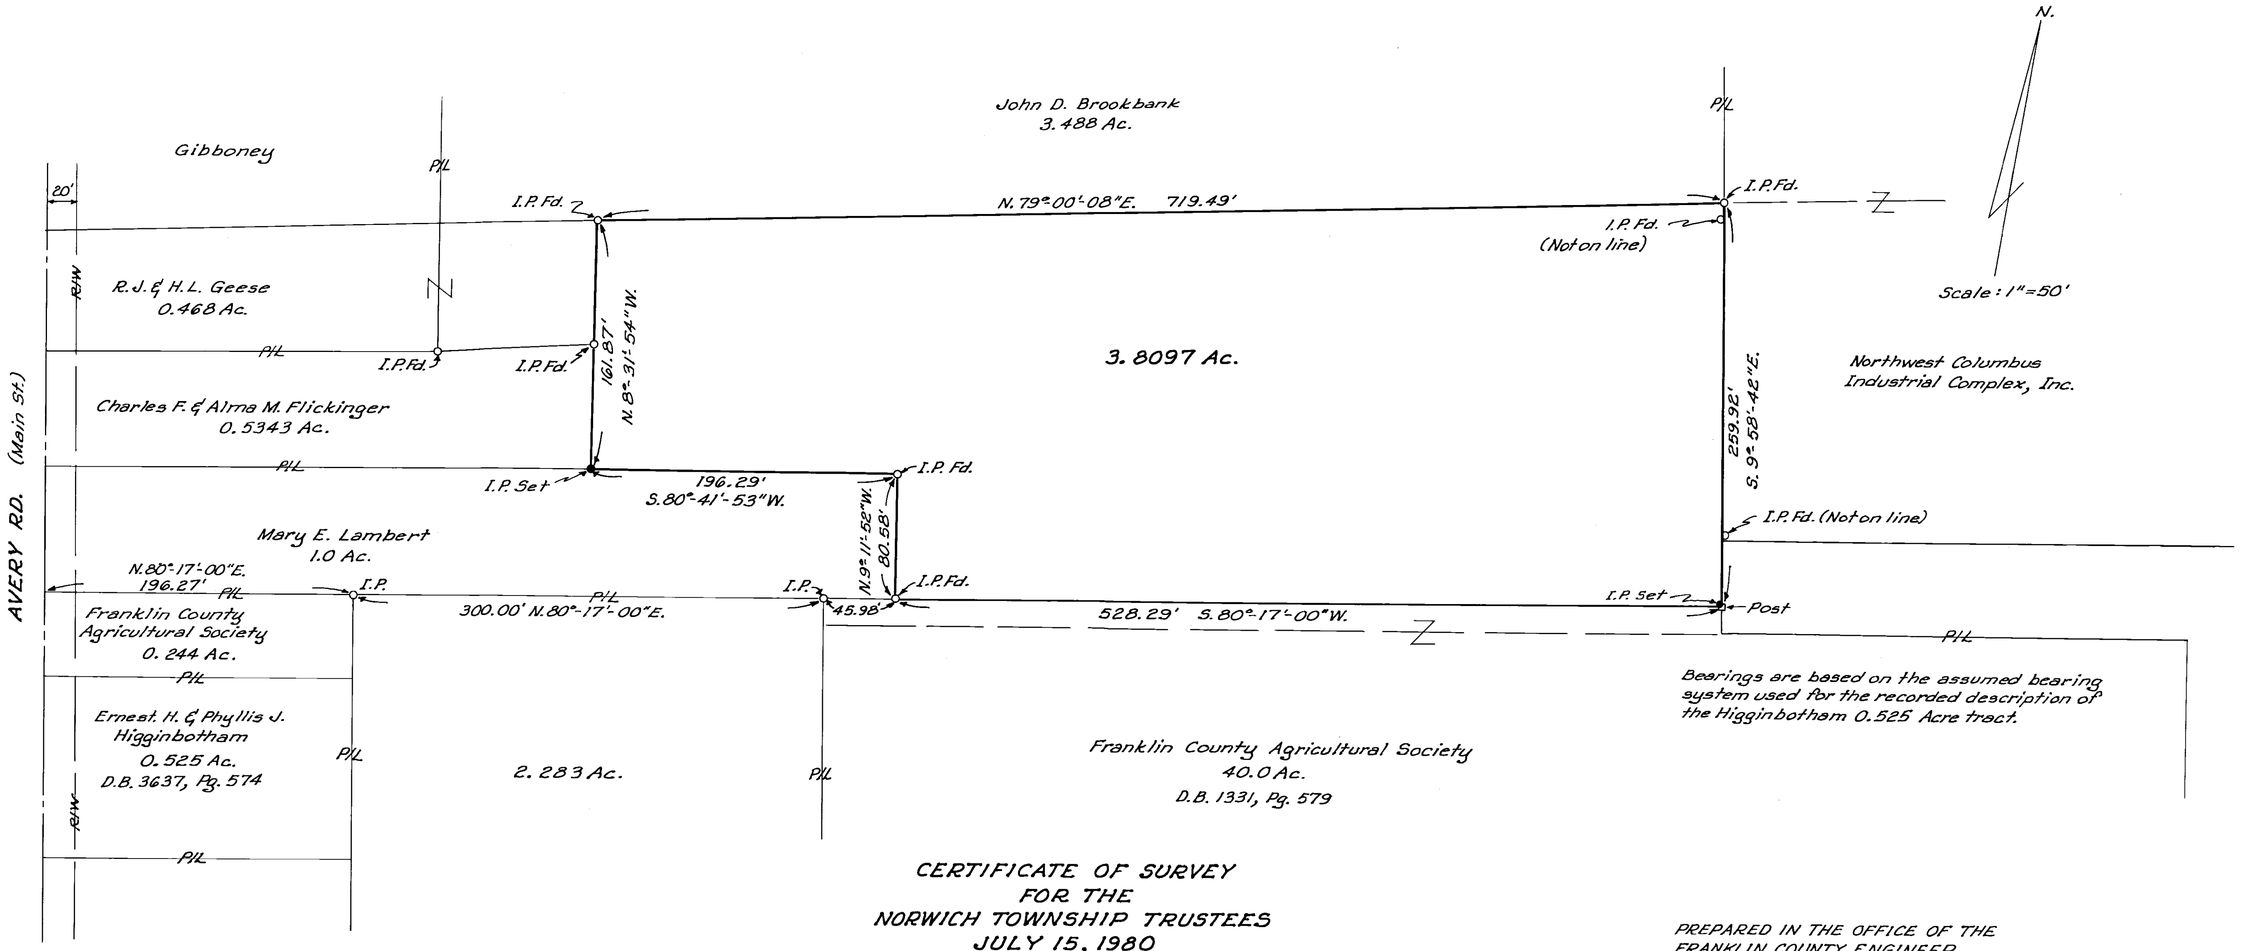

CERTIFICATE OF SURVEY
FOR THE
NORWICH TOWNSHIP TRUSTEES
JULY 15, 1980

Survey of a 3.8097 Acre tract situated in the County of Franklin, State of Ohio, Township of Norwich, Virginia Military Survey 3002, Deed Book 1196, Page 380, County Recorder's Office.

PREPARED IN THE OFFICE OF THE
FRANKLIN COUNTY ENGINEER,
970 DUBLIN RD., COLUMBUS, OHIO

I hereby certify that the foregoing plat was prepared under my direction from an actual survey of the premises.

Edward Hinton
Registered Surveyor #4576