

Myers Surveying Company, Inc.

2740 East Main Street, Columbus 43209 (Bexley), Ohio

614-235-8677

FAX:614-235-4559

A Boundary Survey prepared for and certified to:

The Title Company Ltd. and/or Coldwell Banker Home Loans

Legal Description: Situated in The State of Ohio, County of Franklin, Village of Canal Winchester Being 0.672 acres in the south half of Section 30, Township 15, Range 20

Applicant: Maguire


Posted Address: 176 W. Waterloo Street, Canal Winchester, Ohio

F.E.M.A. Flood Zone Designation: Flood Zone "X" as per F.I.R.M. 390169 0385 H



Scale 1" = 60'

Date: 07-22-2006

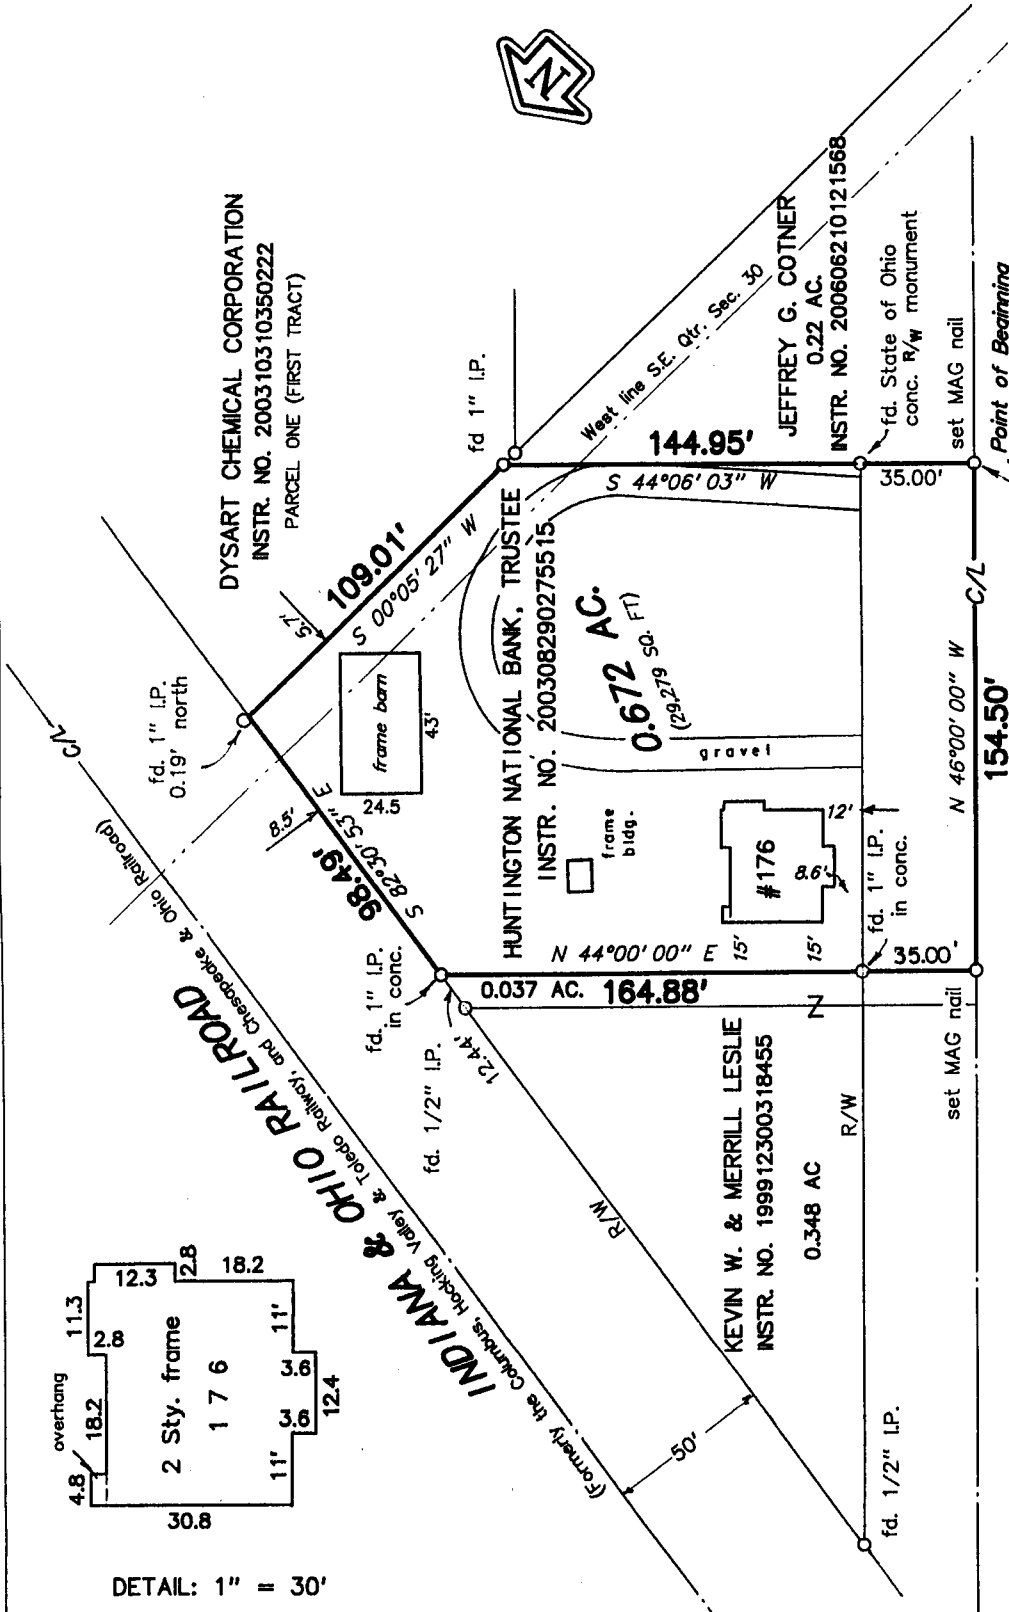

W. WATERLOO STREET

RECEIVED

OCT 02 2006

Franklin County Engineer
Dean C. Ringle, P.E., P.S.



Matthew D. Farley
9/29/06

Myers Surveying Co., Inc.

By *Matthew D. Farley*
Professional Surveyor

We hereby certify that the foregoing Boundary Survey was prepared from actual field measurements in accordance with Chapter 4733-37 Ohio Administrative Code. Iron pipes set are 30"x1" O.D. with an orange plastic plug inscribed "P.S. 6579", unless otherwise noted. Bearings are based on the centerline of W. Waterloo St. as North 46°00'00" West, per Instr. No. 199912300318455.

Myers Order No. - 21-05-30-2006 2006053021	Rec.	Field	DWG	Ltr.	Ck.

