SURVEY OF ACREAGE PARCEL

QUARTER TOWNSHIP 1, TOWNSHIP 2, RANGE 17
UNITED STATES MILITARY DISTRICT
CITY OF WESTERVILLE, FRANKLIN COUNTY, OHIO

RECEIVED
NOV 09 2006
Franklin County Engineer
Dean C. Ringle, P.E.,P.S.

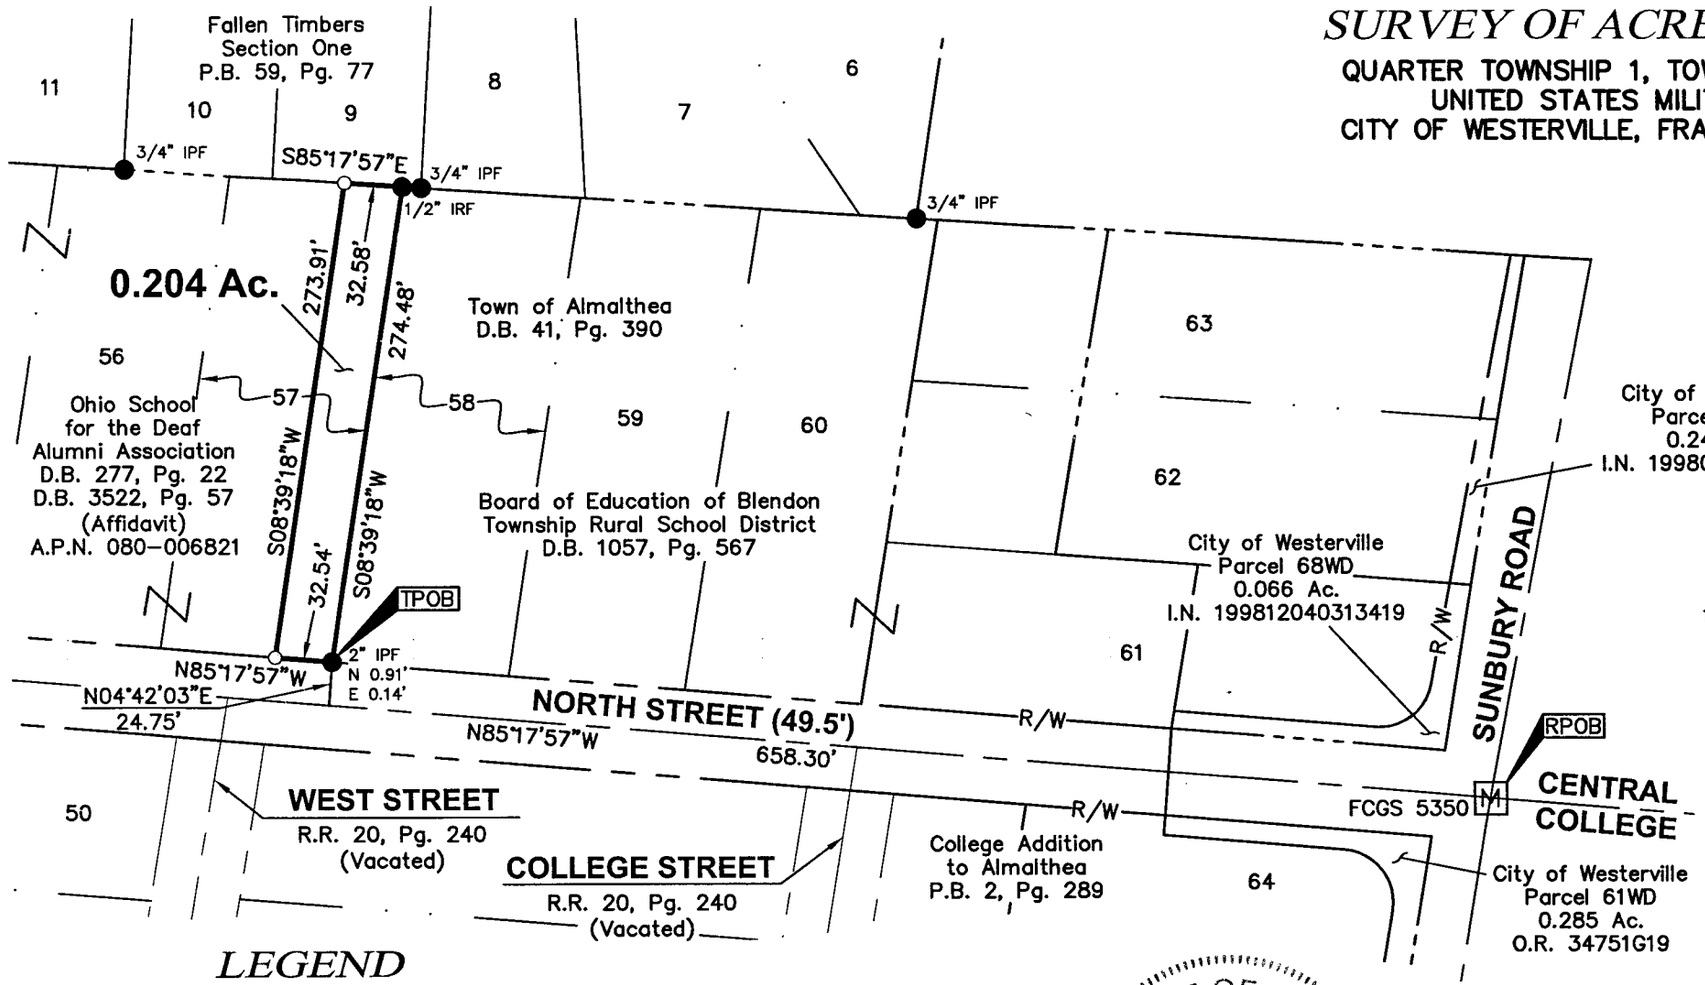

GRAPHIC SCALE

100' 0 50' 100' 200'

1" = 100'

Bearings shown hereon were transferred from a GPS survey of Franklin County Monuments "HOOVER" and "HOOVER AZIMUTH" performed by the Franklin County Engineer's Office, and is based upon the NAD83 Ohio State Plane Coordinate System, South Zone (1986 Adjustment), and determines the bearing between said monuments as S 86° 13' 34" W.

LEGEND

● Iron Pipe Found	○ Iron Pin Set
✖ PK Nail Found	⌑ PK Nail Set
▲ RR Spike Found	△ RR Spike Set
[M] Monument Box Fnd.	(M) Monument Fnd.

Iron pins set are 3/4" iron pipe, 30" long with a plastic cap inscribed "Advanced 7661".

STATE OF OHIO
JOHN C. DODGION
8069
REGISTERED PROFESSIONAL SURVEYOR

11/06/06

John C. Dodgion, P.S. 8069

DRAWN BY: JCD	JOB NO.: 06-0001-181
DATE: 10/02/06	CHECKED BY: DRH

ADVANCED
CIVIL DESIGN
ENGINEERS SURVEYORS

422 Beecher Road
Gahanna, Ohio 43230
ph 614.428.7750
fax 614.428.7755