Myers Surveying Company, Inc.

2740 East Main Street, Columbus 43209 (Bexley), Ohio
614-235-8677 FAX: 614-235-4559

A Boundary Survey prepared for and certified to:

Capitol South

Legal Description: Situated in Ohio, County of Franklin, City of Columbus, Being Lot 109 M. L. Sullivants' Western Additions Plat Book 1, Page 268

Applicant:

Posted Address: 377 W. Broad Street, Columbus, Ohio

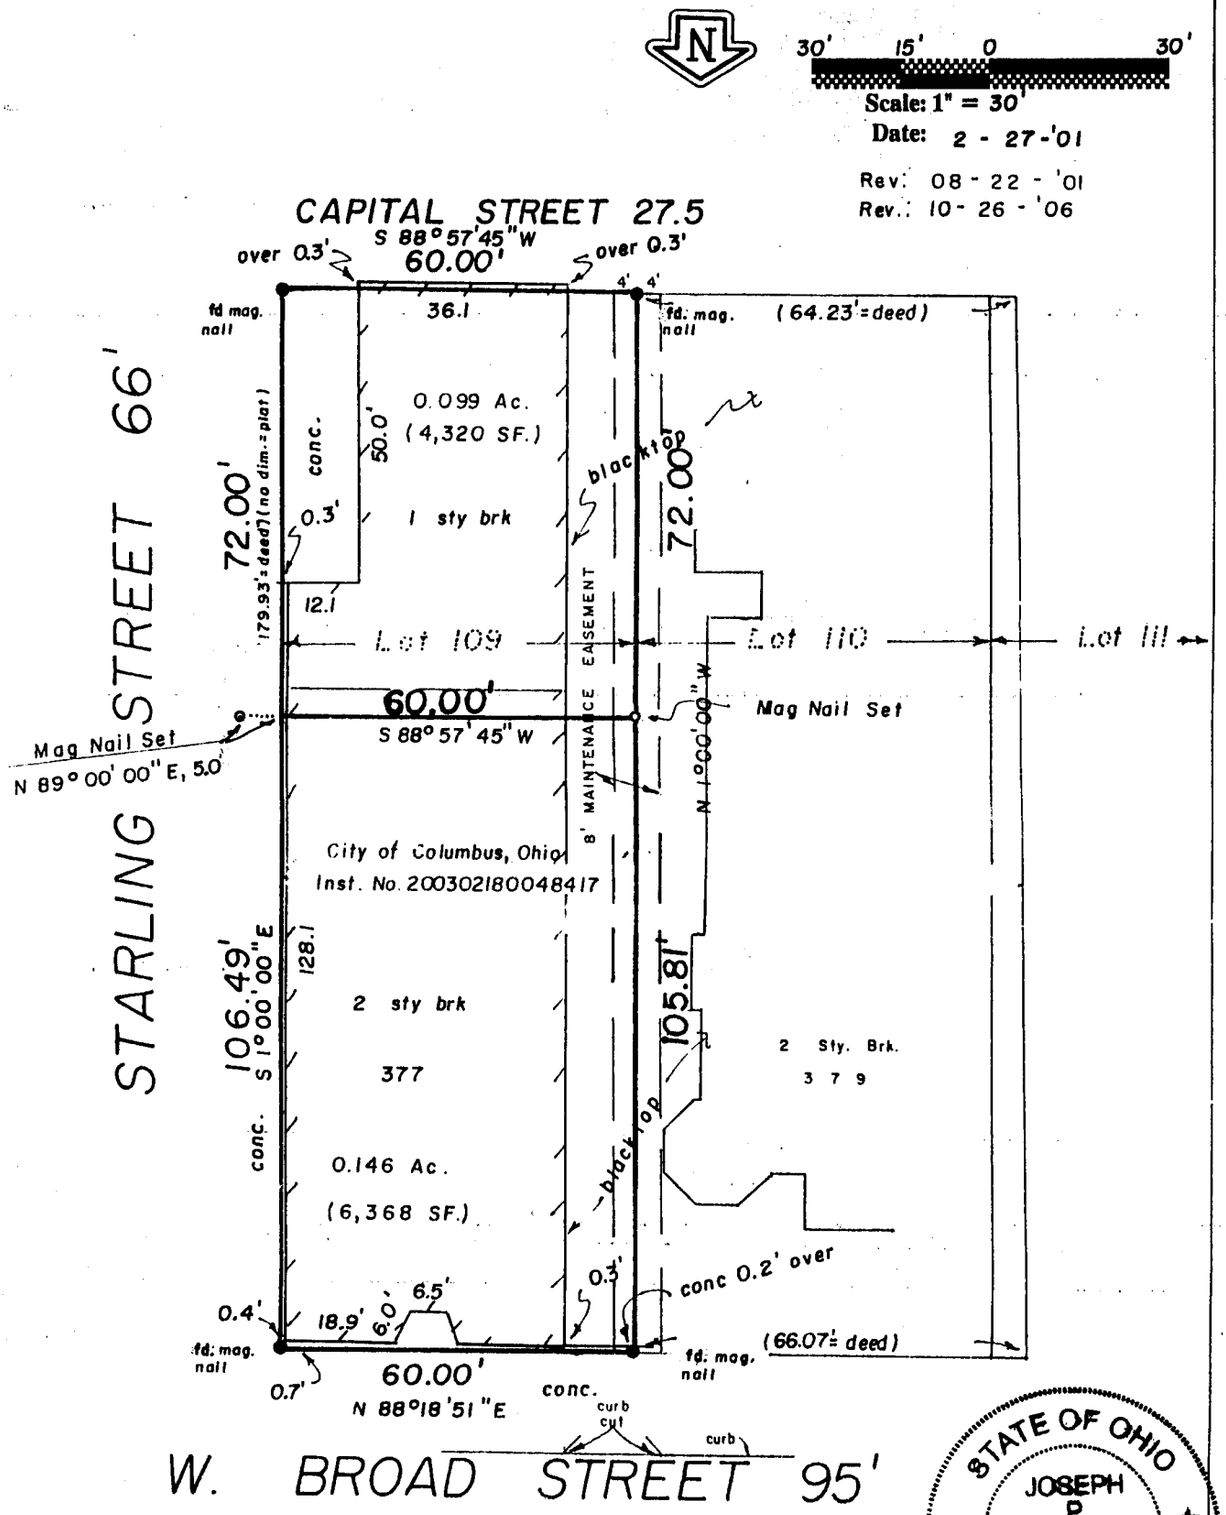

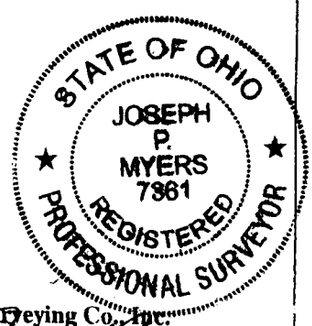

We hereby certify that the foregoing Boundary Survey was prepared from actual field measurements in accordance with Chapter 4733-37 Ohio Administrative Code. Iron pins set are 30"x1" O.D. with an orange plastic plug inscribed "P.S. 6579", unless otherwise noted. Basis of bearing is the west line of Starling Street assumed South 1 degree 00 minutes 00 seconds East.

Myers Surveying Co., Inc.

By _____
Professional Surveyor

Myers Order No. - 11-02/02/73	Rec.	Field JPM/CA/KCN	DWG JPM	Ltr. JPM	Ck.