EMH&T
Evans, Mechwart, Hambleton & Tilton, Inc.
Engineers • Surveyors • Planners • Scientists
5500 New Albany Road, Columbus, OH 43054
Phone: 614.775.4500 Fax: 614.775.4800
M C M X X V I

SURVEY OF ACREAGE PARCEL
LOCATED IN
VIRGINIA MILITARY SURVEY NUMBER 469
CITY OF GROVECITY, FRANKLIN COUNTY, OHIO

Date: October 17, 2006
Scale: 1" = 100'
Job No: 2004-1654

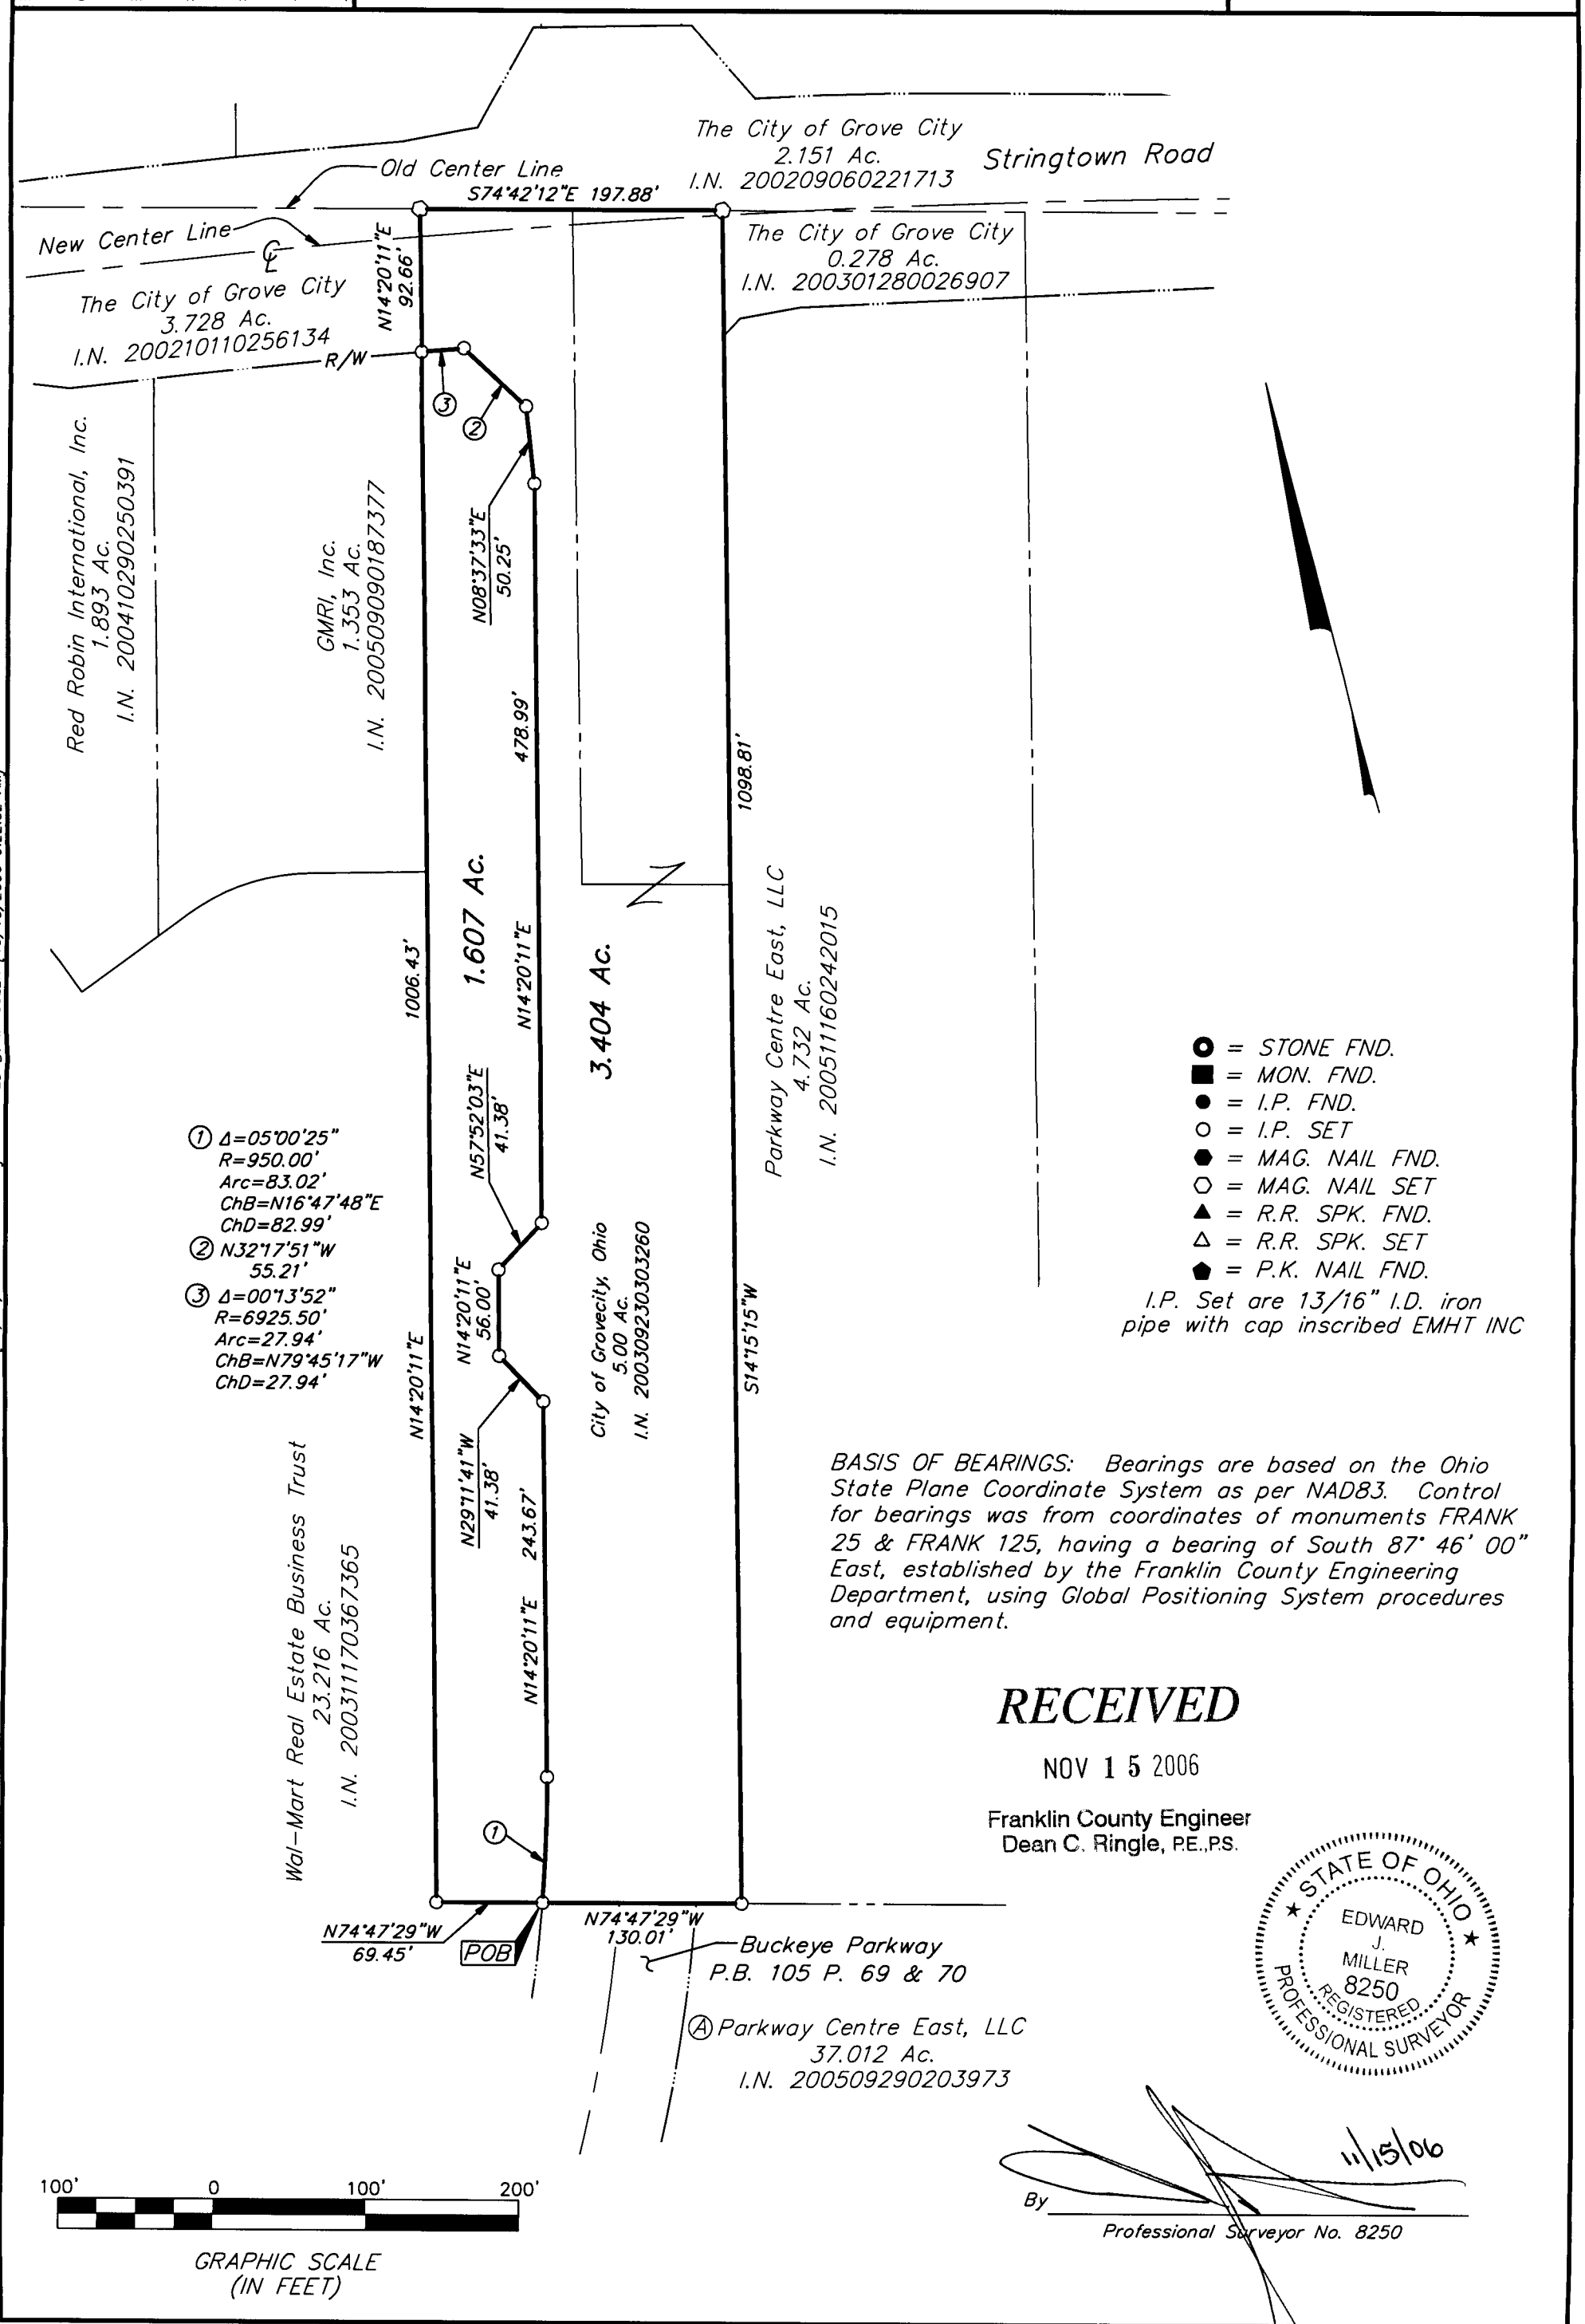

BASIS OF BEARINGS: Bearings are based on the Ohio State Plane Coordinate System as per NAD83. Control for bearings was from coordinates of monuments FRANK 25 & FRANK 125, having a bearing of South 87° 46' 00" East, established by the Franklin County Engineering Department, using Global Positioning System procedures and equipment.

RECEIVED
NOV 15 2006
Franklin County Engineer
Dean C. Ringle, P.E.,P.S.

STATE OF OHIO
EDWARD J. MILLER
8250
REGISTERED
PROFESSIONAL SURVEYOR

11/15/06
By
Professional Surveyor No. 8250

\\CMHDATA1\SURVEY\PROJECT\20041654\DWG\41654BV.DWG<11X17 PORTRAIT CANNON> - NO XREFS - LAST SAVED BY MRISSLER [10/18/2006 9:22:31 AM] - PLOTTED BY MRISSLER [10/18/2006 9:22:32 AM]