


RECEIVED
 DEC 0 6 2006
 Franklin County Engineer
 Dean C. Ringle, P.E., P.S.

Kenneth R. George
 Judy A. Wolfe
 Instrument Number 200508090161210

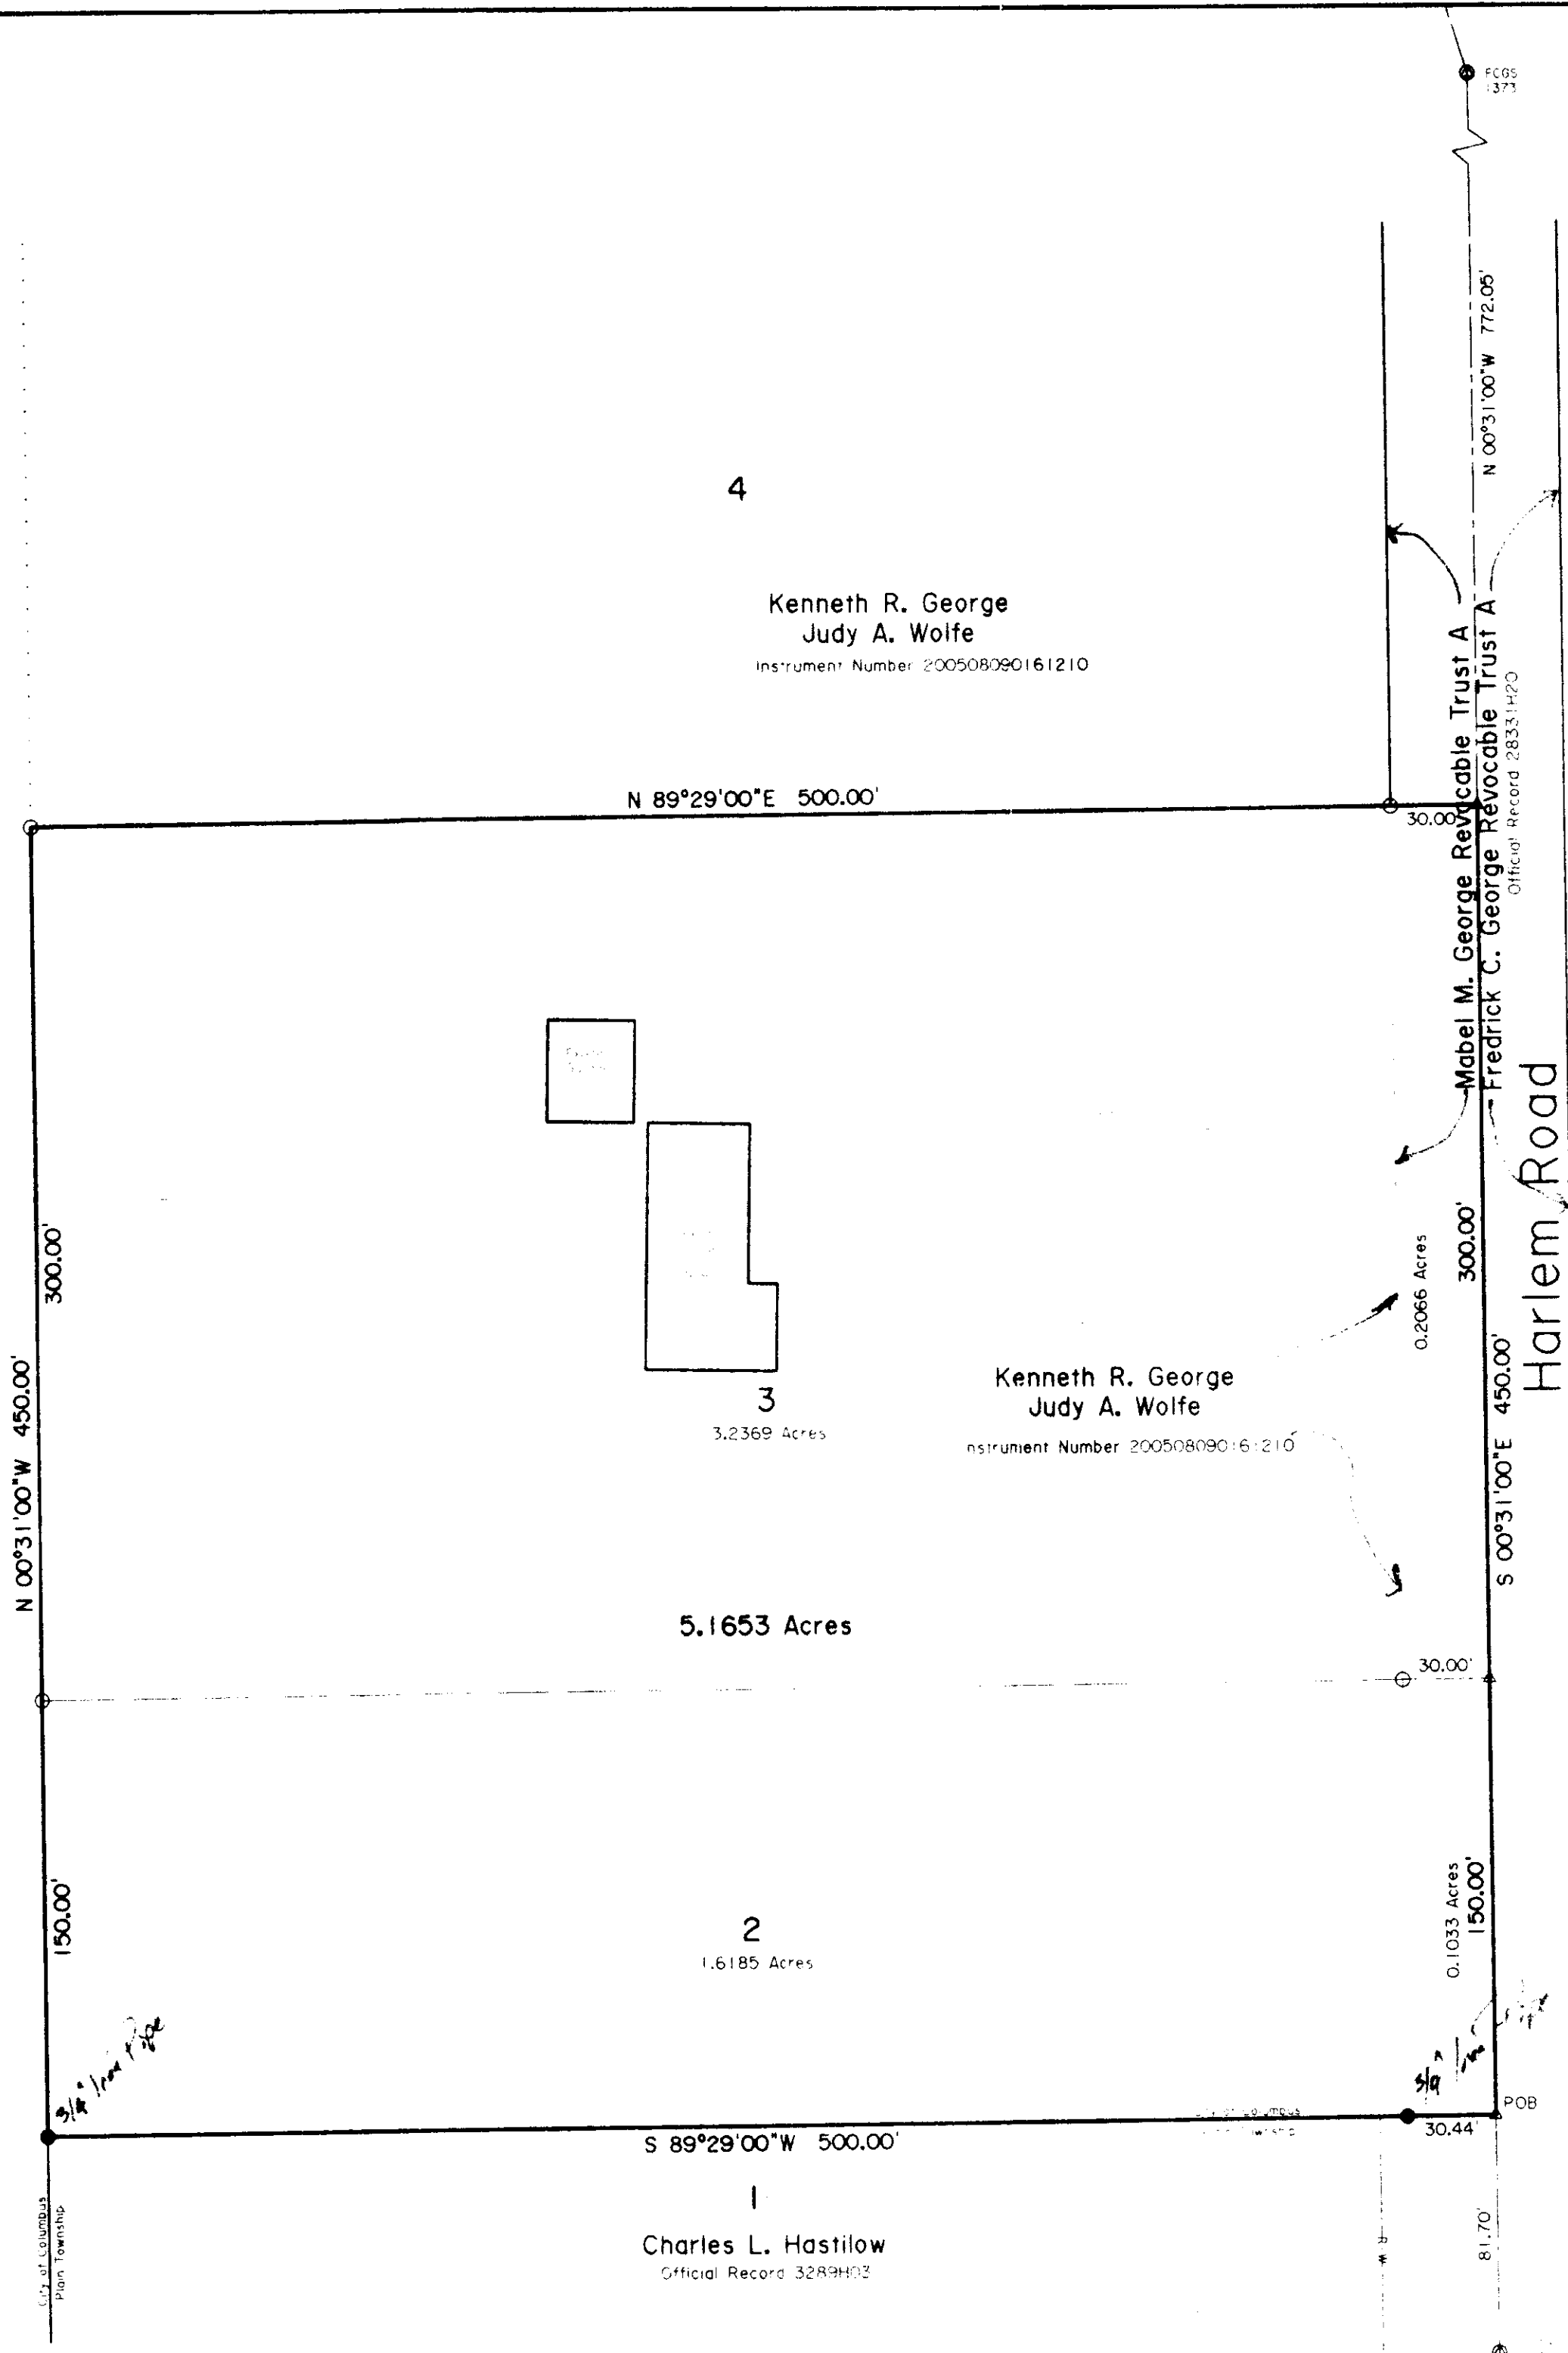


Resurvey of Lot 2 & 3

Plat of 17.085 Acres
 for
Fredrick C. George
 (unrecorded)

Section 7, Township 2 North, Range 16 West
 of the United States Military Lands
 City of Columbus, Franklin County, Ohio

Kenneth R. George
 Judy A. Wolfe
 Instrument Number 200508090161210

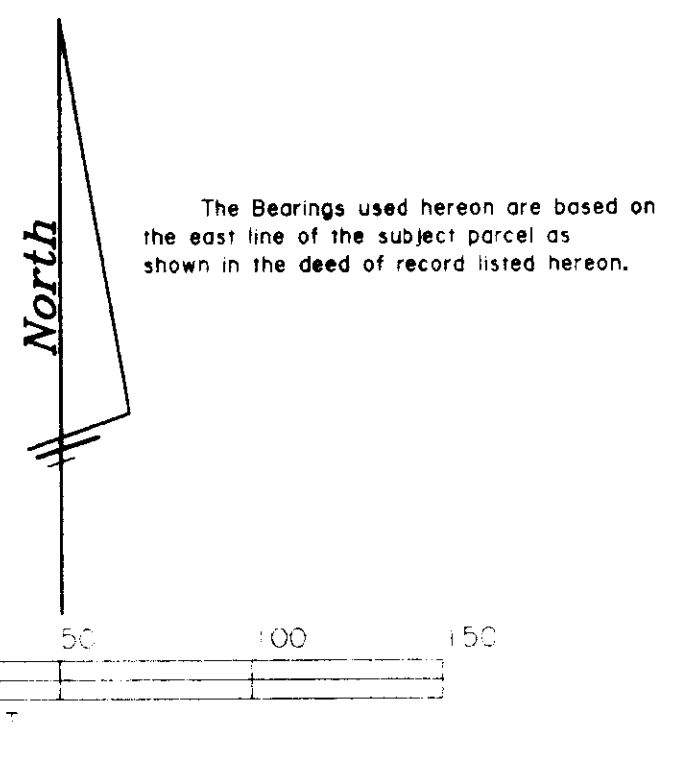

LEGEND

- Iron Pipe or Bar Found
- 3/4 inch Iron Pipe Set (Company name on marker)
- ▲ Railroad Spike Found
- △ Magnetic Nail Set
- Stone Found
- ⊙ Concrete Monument w/ Brass Cap
- Drill Hole



AHLERS, MOE & ASSOC. INC
 Engineers & Surveyors
 360 West Waterloo Street
 Canal Winchester, Ohio 43110
 (614) 837-1178