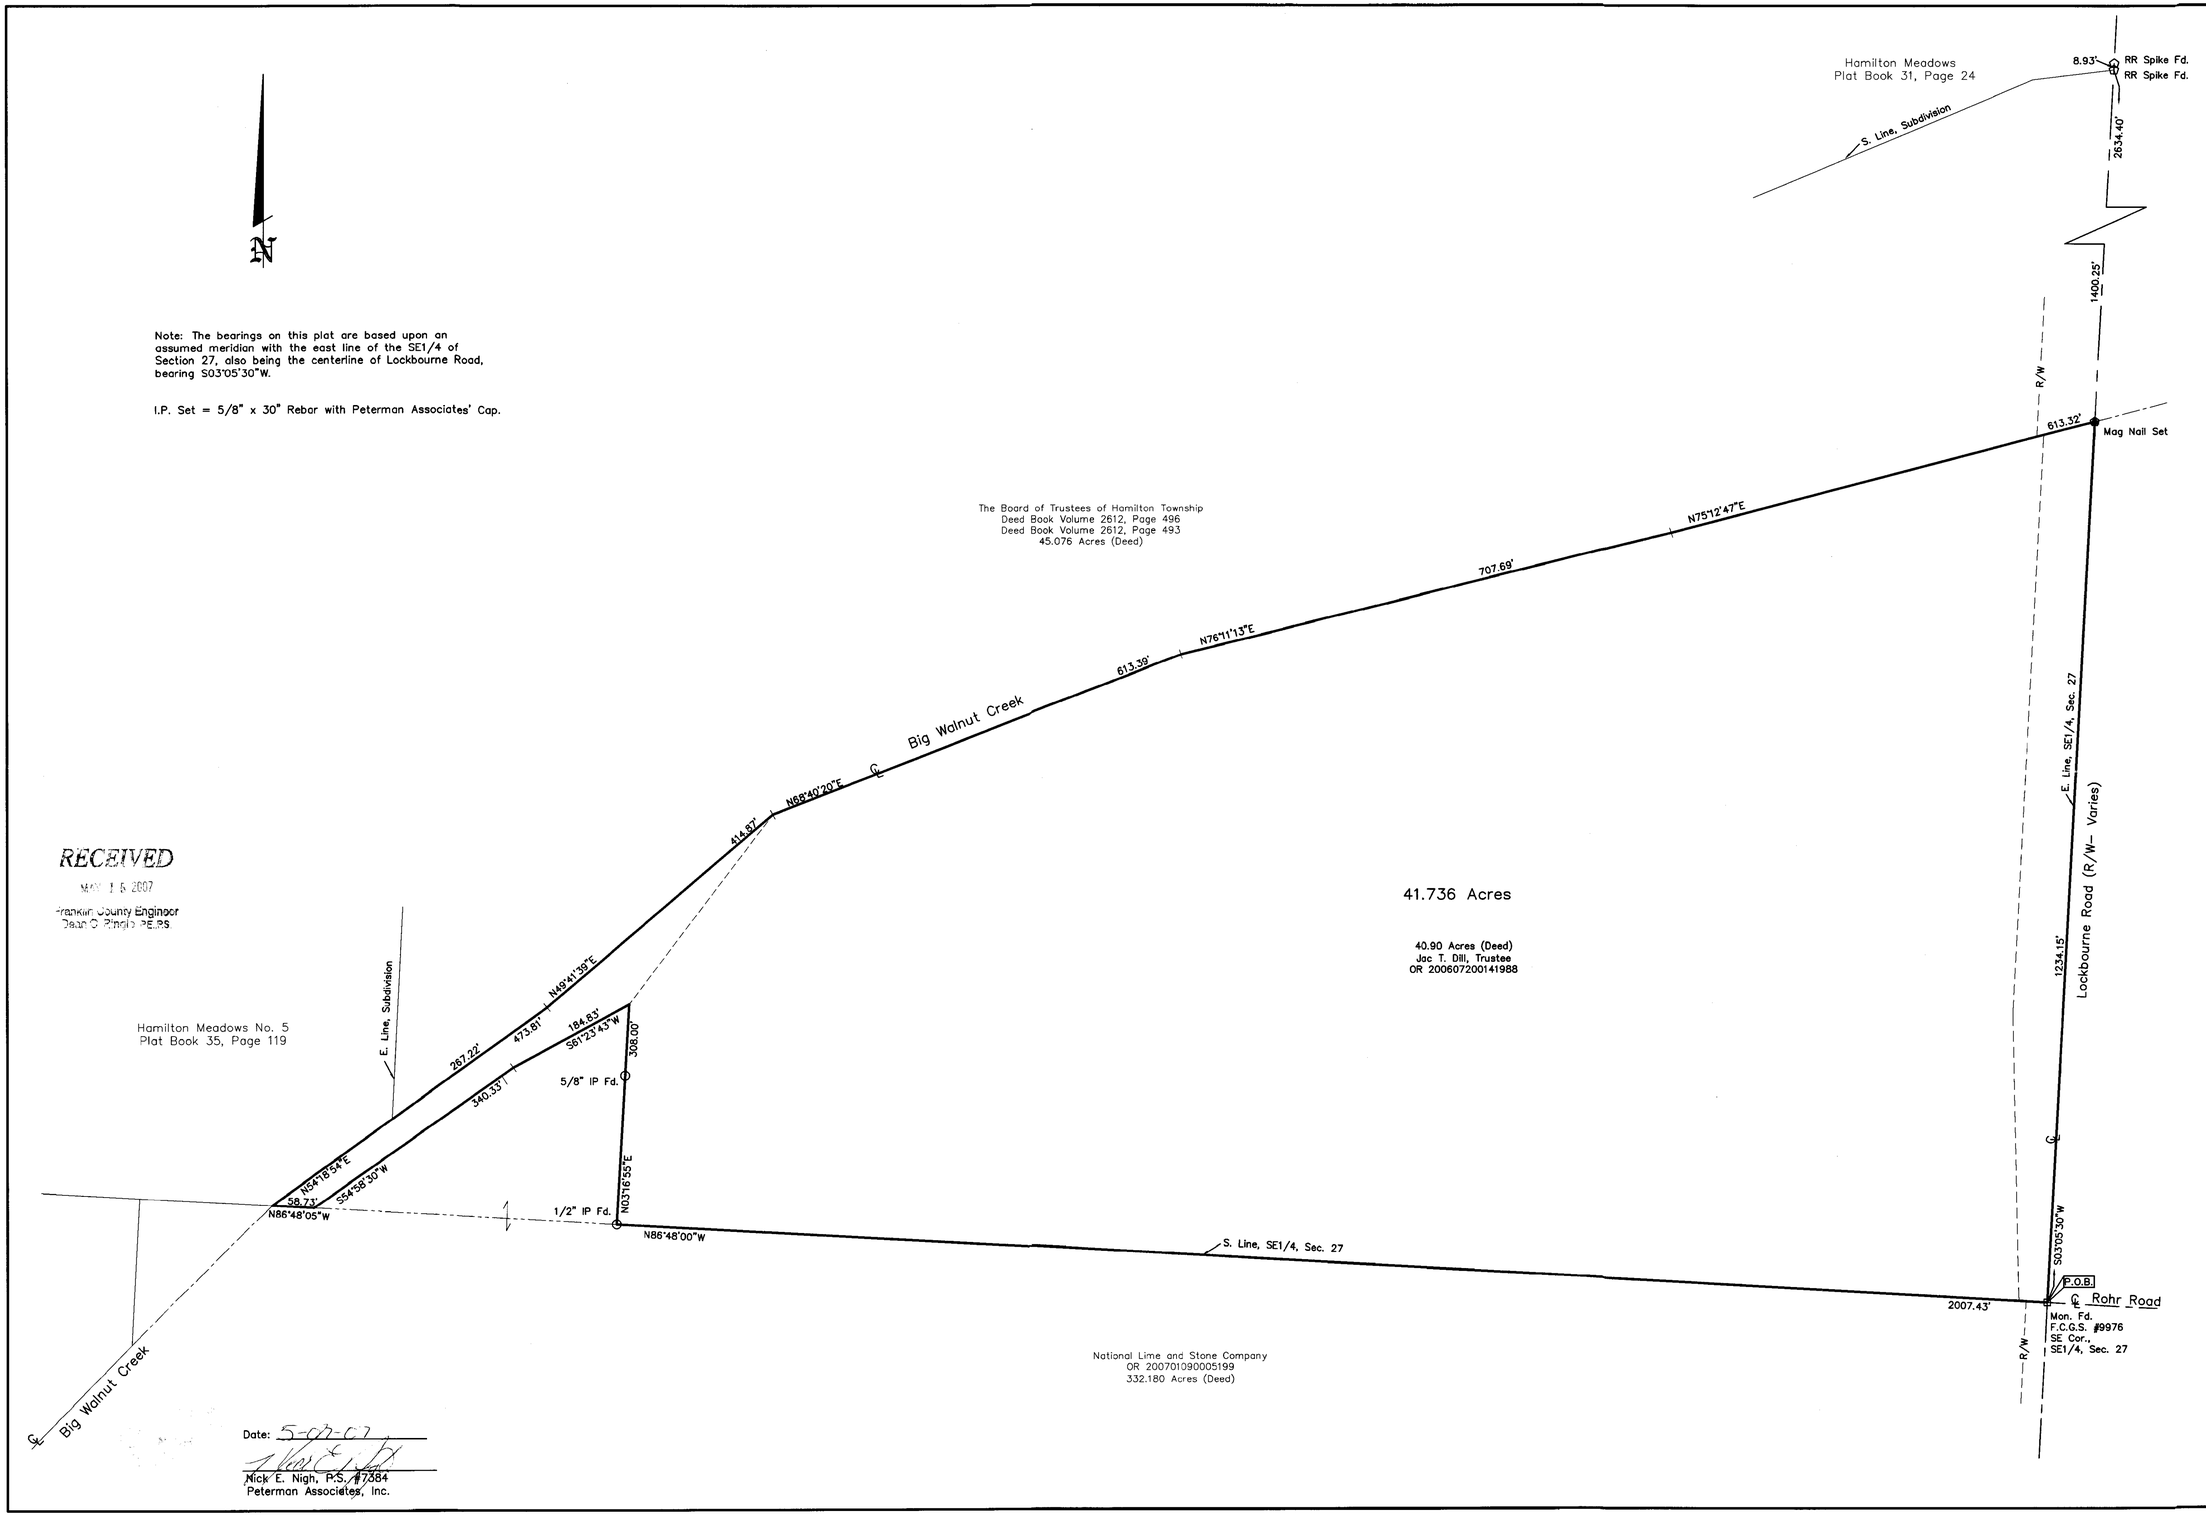

RECEIVED
MAY 1 5 2007
Franklin County Engineer
Dean C. Ringle P.E.P.S.

Date: 5-07-07

Nick E. Nigh, P.S. #7384
Peterman Associates, Inc.

PETERMAN ASSOCIATES, INC.
- ARCHITECTS - ENGINEERS - SURVEYORS -
Corporate Office
3480 N. Main Street
Findlay, Ohio 45840
Office (419)422-6672
Fax (419)422-9468
Offices In Toledo
Est. 1939

Boundary Survey

The National Lime & Stone Company

Being part of the SE1/4 of Section 27, T4N, R22W,
Congress Lands, Hamilton Township, Franklin County, Ohio

REVISIONS	DATE	BY

SCALE
0 50 100
(IN FEET)

DATE: 5-7-07
DWG BY: RKT
PROJECT: 07-0268