

J-4-B

EMH&T

Evans, Mechwart, Hambleton & Tilton, Inc.
Engineers • Surveyors • Planners • Scientists
5500 New Albany Road, Columbus, OH 43054
Phone: 614.775.4500 Fax: 614.775.4800


SURVEY OF ACREAGE PARCEL QUARTER TOWNSHIP 1, TOWNSHIP 1, RANGE 17 UNITED STATES MILITARY LANDS CITY OF COLUMBUS, FRANKLIN COUNTY, OHIO

Date: May 16, 2007

Job No. 2006-1356

Scale: 1" = 100'

M C M X X V I

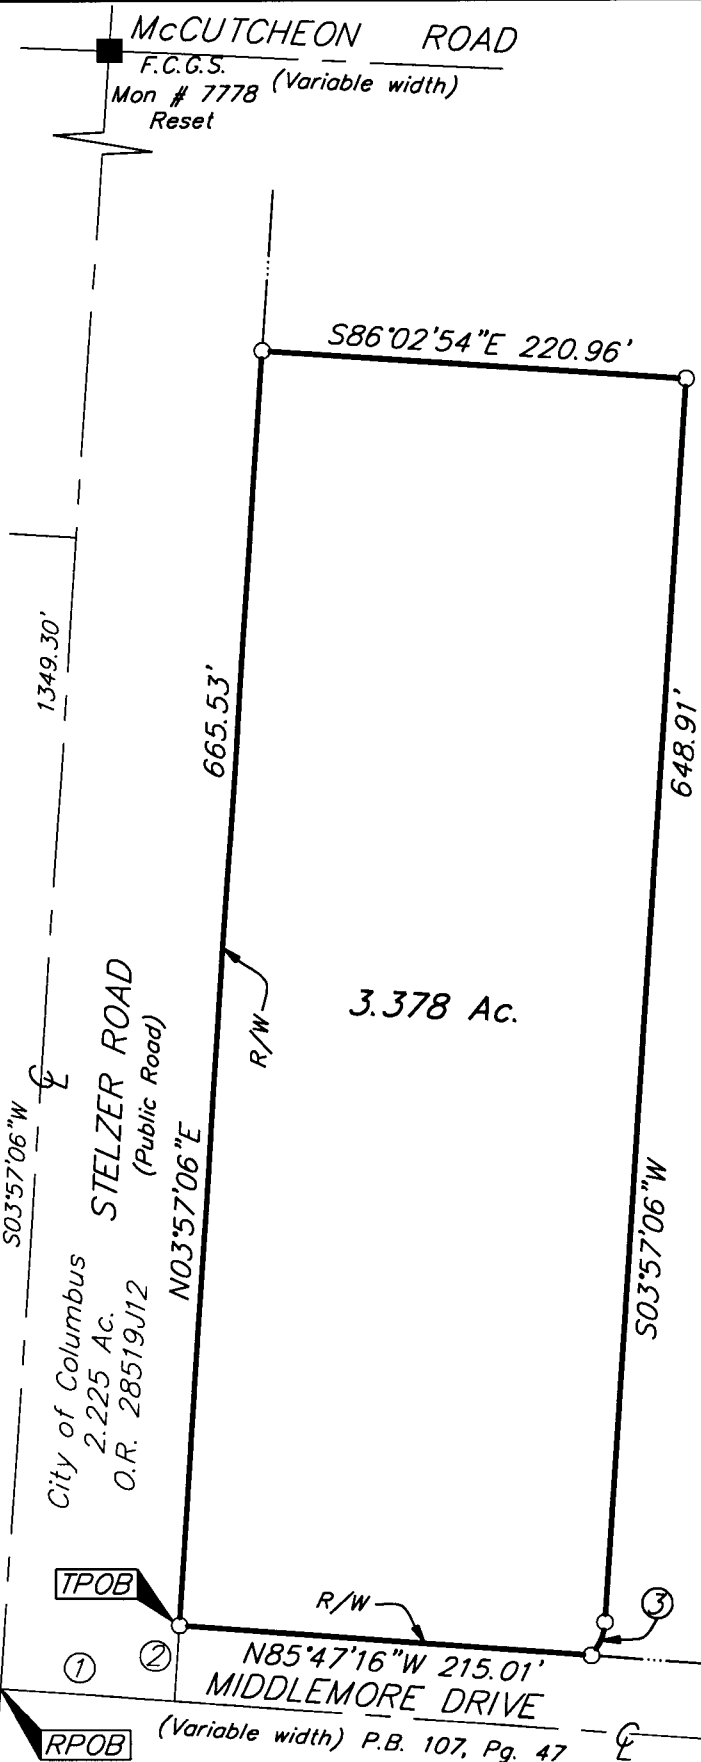

- ① S85°47'16"E 90.00'
- ② N03°57'06"E 40.01'
- ③ Δ=37°22'42"
R=29.00'
Arc=18.92'
ChB=S22°38'27"W
ChD=18.58'

McCutcheon GE, LLC
21.581 Ac.
I.N. 200612150248840

- = STONE FND.
- = MON. FND.
- = I.P. FND.
- = I.P. SET
- ◆ = MAG. NAIL FND.
- = MAG. NAIL SET
- ▲ = R.R. SPK. FND.
- Δ = R.R. SPK. SET
- ◆ = P.K. NAIL FND.

I.P. Set are 13/16" I.D. iron pipe with cap inscribed FMHT INC.

DWG<LEGAL PORTRAIT> - NO XREFS - LAST SAVED BY MRRISLER [5/17/2007 10:46:53 AM] - PLOTTED BY MRRISLER [5/17/2007 10:46:53 AM]