EMH&T
Evans, Mechwart, Hambleton & Tilton, Inc.
Engineers • Surveyors • Planners • Scientists
5500 New Albany Road, Columbus, OH 43054
Phone: 614.775.4500 Fax: 614.775.4800
M C M X X V I

SURVEY OF ACREAGE PARCEL
VIRGINIA MILITARY DISTRICT
SURVEY NO. 8231
CITY OF GROVE CITY, FRANKLIN COUNTY, OHIO

Date: August 15, 2007
Scale: 1" = 100'
Job No: 2007-0892

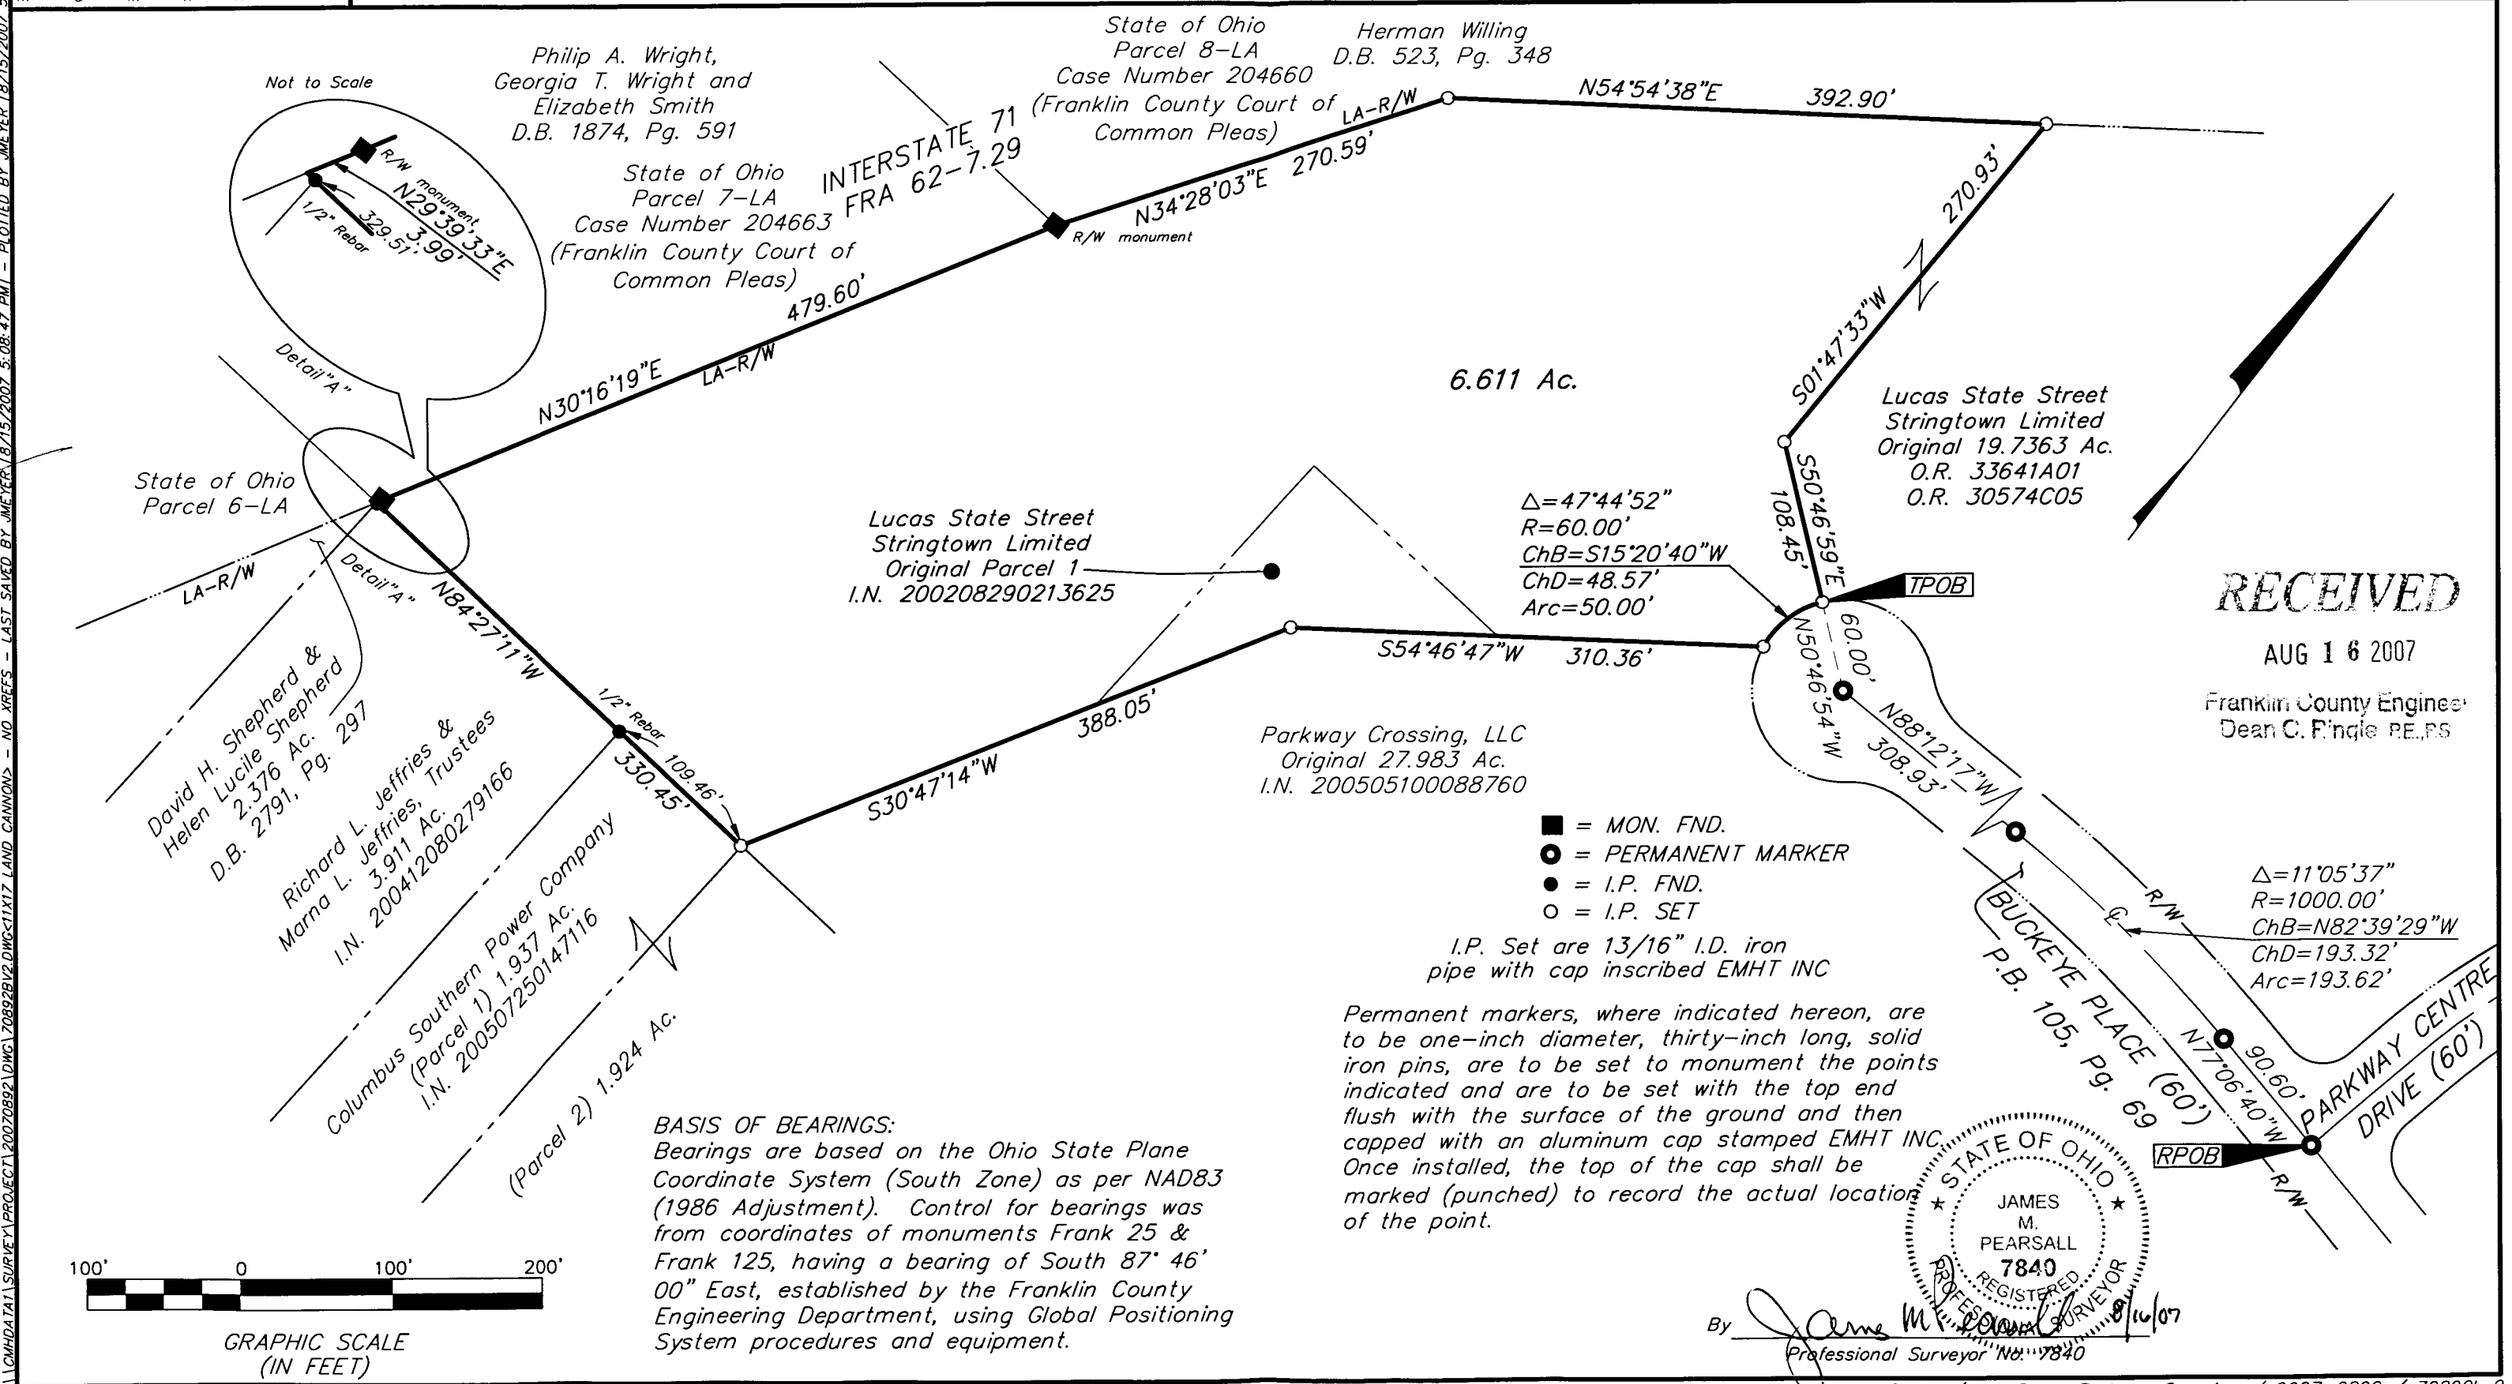

RECEIVED
AUG 16 2007
Franklin County Engineer
Dean C. Pingle P.E., P.S.

BASIS OF BEARINGS:
Bearings are based on the Ohio State Plane Coordinate System (South Zone) as per NAD83 (1986 Adjustment). Control for bearings was from coordinates of monuments Frank 25 & Frank 125, having a bearing of South 87° 46' 00" East, established by the Franklin County Engineering Department, using Global Positioning System procedures and equipment.

Permanent markers, where indicated hereon, are to be one-inch diameter, thirty-inch long, solid iron pins, are to be set to monument the points indicated and are to be set with the top end flush with the surface of the ground and then capped with an aluminum cap stamped EMHT INC. Once installed, the top of the cap shall be marked (punched) to record the actual location of the point.

STATE OF OHIO
JAMES M. PEARSALL
7840
REGISTERED
PROFESSIONAL SURVEYOR

By James M. Pearsall 8/16/07
Professional Surveyor No. 7840

\\CMHDATA1\SURVEY\PROJECT\20070892\DWG\70892BV2.DWG<11X17 LAND CANNON> - NO XREFS - LAST SAVED BY JMEYER 8/15/2007 5:08:47 PM - PLOTTED BY JMEYER 8/15/2007 5:08:55 PM