


E-9-F

PLAT OF SURVEY FOR ALLEY BEHIND LOT 97, BLOCK 2 VILLA PARK SUBDIVISION

SITUATED IN THE STATE OF OHIO, COUNTY OF FRANKLIN, CITY OF COLUMBUS,
BEING PART OF QUARTER TOWNSHIP 4, TOWNSHIP 2, RANGE 18,
UNITED STATES MILITARY LANDS.



NORTH

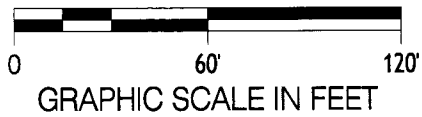

RECEIVED

OCT 04 2007

Franklin County Engineer
Dean C. Pindia P.E., P.S.

NOTE

ALL IRON PINS SET ARE 5/8" SOLID IRON PINS 30" IN LENGTH
WITH AN ORANGE PLASTIC CAP STAMPED "FLOYD BROWNE GROUP".

NOTE

ALL RECORD INFORMATION SHOWN HEREON WAS OBTAINED
FROM THE RECORDER'S OFFICE, FRANKLIN COUNTY, OHIO.


BASIS OF BEARINGS

BEARINGS ARE BASED ON THE NORTHERLY RIGHT OF WAY
LINE OF KILBOURNE AVENUE BEING NORTH 89°48'50" WEST OF
RECORD IN INSTRUMENT NUMBER 200012040244333.

I HEREBY STATE THAT THIS SURVEY IS BASED ON ACTUAL FIELD MEASUREMENTS
AND TO THE BEST OF MY KNOWLEDGE AND BELIEF IS CORRECT.

Maynard H. Thompson
MAYNARD H. THOMPSON, P.S.
PROFESSIONAL SURVEYOR NO. 7128

10/01/07
DATE

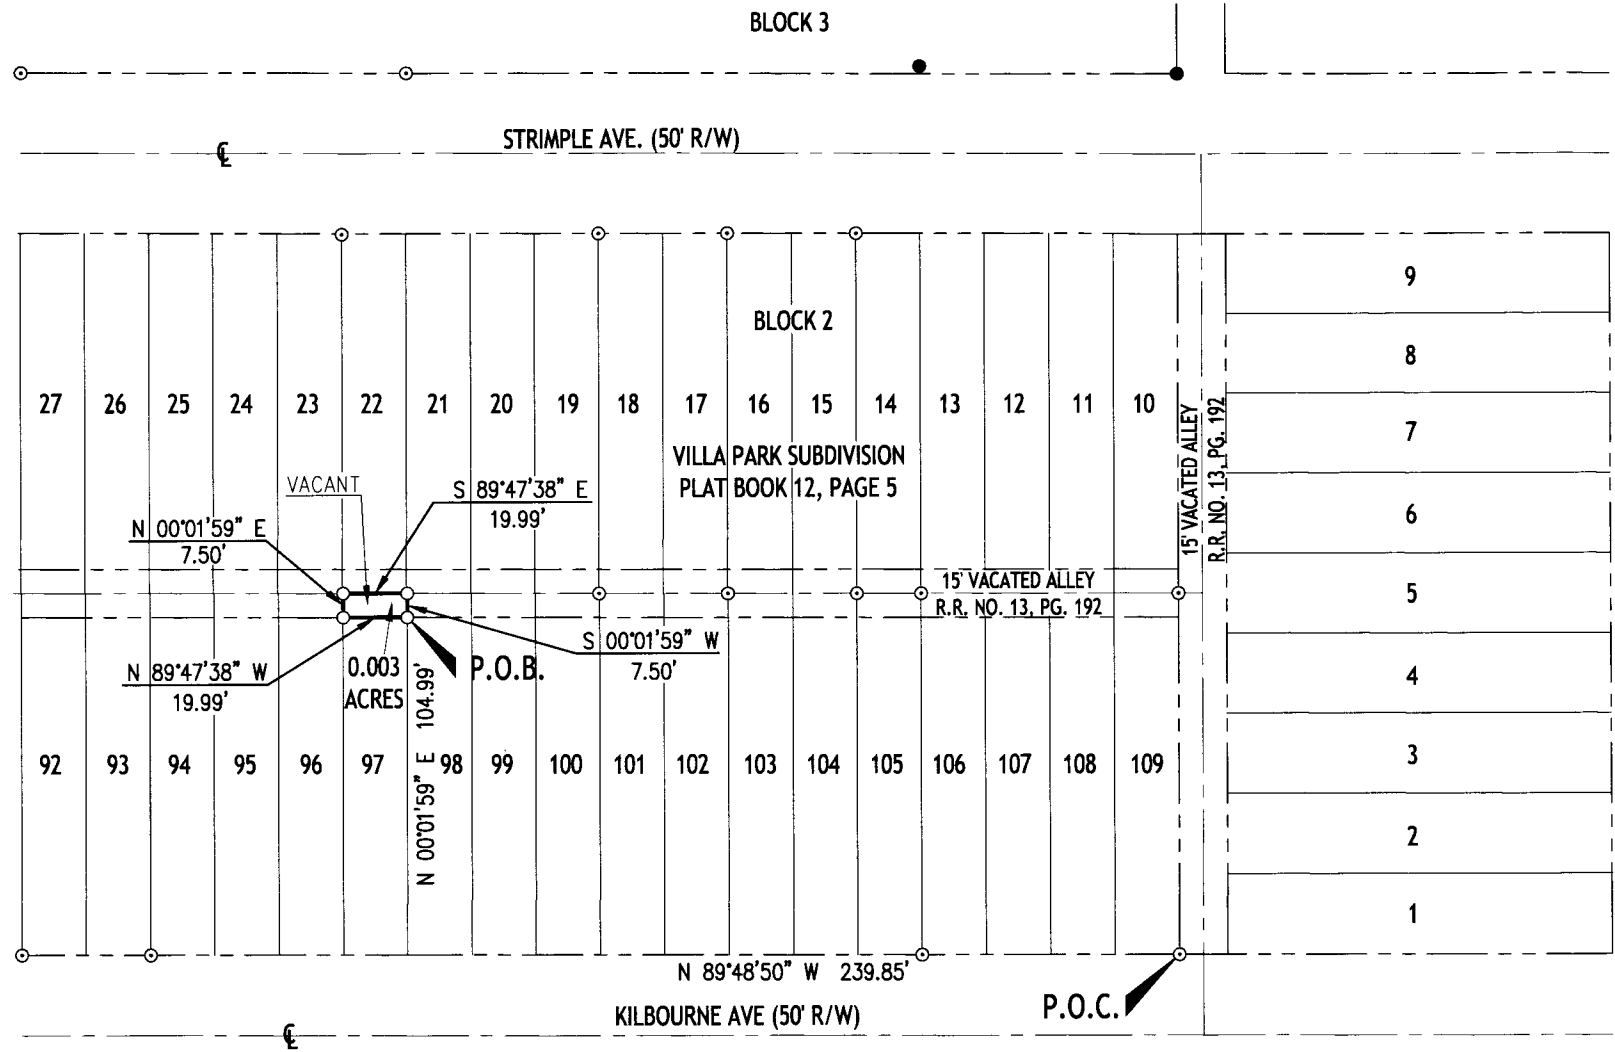

LEGEND

- IRON PIN FND ●
- IRON PIPE FND ⊙
- MAG NAIL FND ●
- IRON PIN SET ○
- MAG NAIL SET ⊙

PAGE 2 OF 2
DRAWN BY: DBP
CHECKED BY: MHT

FILE NO. 07-60714 ALLEY 97



Central Ohio
740.363.6792
740.363.6536 fax
800.325.7647

Solutions for Your World
www.FloydBrowne.com