EMH&T
Evans, Mechwart, Hambleton & Tilton, Inc.
Engineers • Surveyors • Planners • Scientists
5500 New Albany Road, Columbus, OH 43054
Phone: 614.775.4500 Fax: 614.775.4800
M C M X X V I

SURVEY OF ACREAGE PARCEL
SECTION 25, TOWNSHIP 11, RANGE 21
CONGRESS LANDS
VILLAGE OF CANAL WINCHESTER, FRANKLIN COUNTY, OHIO

Date: October 4, 2007
Scale: 1" = 200'
Job No: 2007-2055

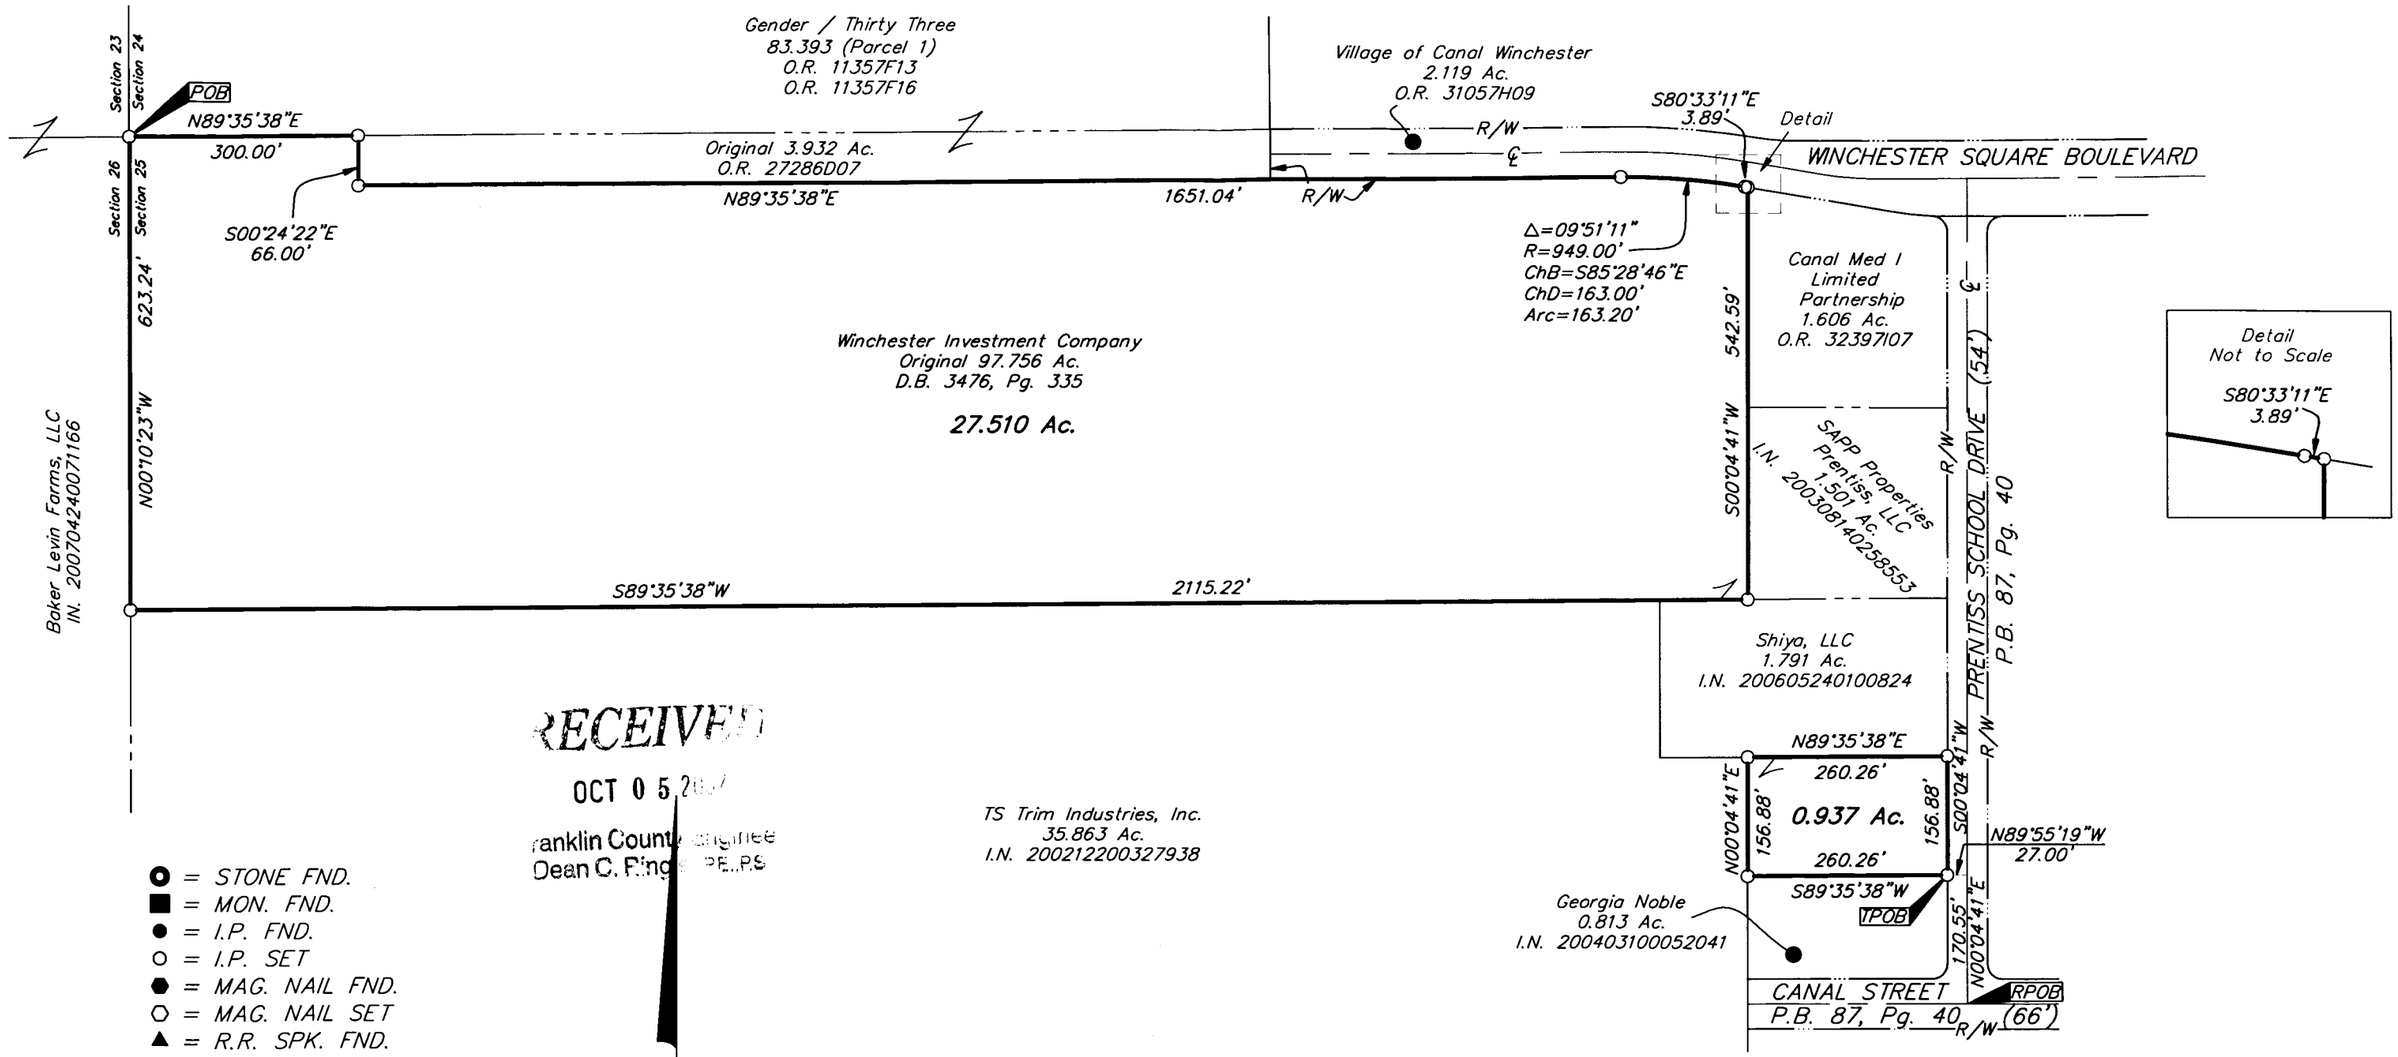

RECEIVED
OCT 0 5 2007
Franklin County Engineer
Dean C. Ringle PE, PS

- ○ = STONE FND.
- ■ = MON. FND.
- ● = I.P. FND.
- ○ = I.P. SET
- ⬢ = MAG. NAIL FND.
- ⬡ = MAG. NAIL SET
- ▲ = R.R. SPK. FND.
- △ = R.R. SPK. SET
- ⬟ = P.K. NAIL FND.

I.P. Set are 13/16" I.D. iron pipe with cap inscribed EMHT INC

200' 0 200' 400'
GRAPHIC SCALE
(IN FEET)

BASIS OF BEARINGS: Bearings are based on North 00° 04' 41" East for the centerline of Prentiss School Drive as shown on that plat entitled "Canal Street, Gender Road and Prentiss School Drive Dedication and Easements" recorded in Plat Book 87, Page 40.

Note:
This survey was prepared using documents of record, prior plats of survey, and observable field evidence.

STATE OF OHIO
JAMES M. PEARSALL
7840
REGISTERED
PROFESSIONAL SURVEYOR

By James M. Pearsall 10/4/07
Professional Surveyor No. 7840

\\CMHDATA1\SURVEY\PROJECT\20072055\DWG\72055BV.DWG<11X17 LAND CANNON> - NO XREFS - LAST SAVED BY PSINGLETON [10/4/2007 4:43:56 PM] - PLOTTED BY PSINGLETON [10/4/2007 4:43:56 PM]