D-8-F

PROPERTY SPLIT SURVEY

STATE OF OHIO, COUNTY OF FRANKLIN, TOWNSHIP OF PLEASANT, VIRGINIA MILITARY SURVEY No. 2595

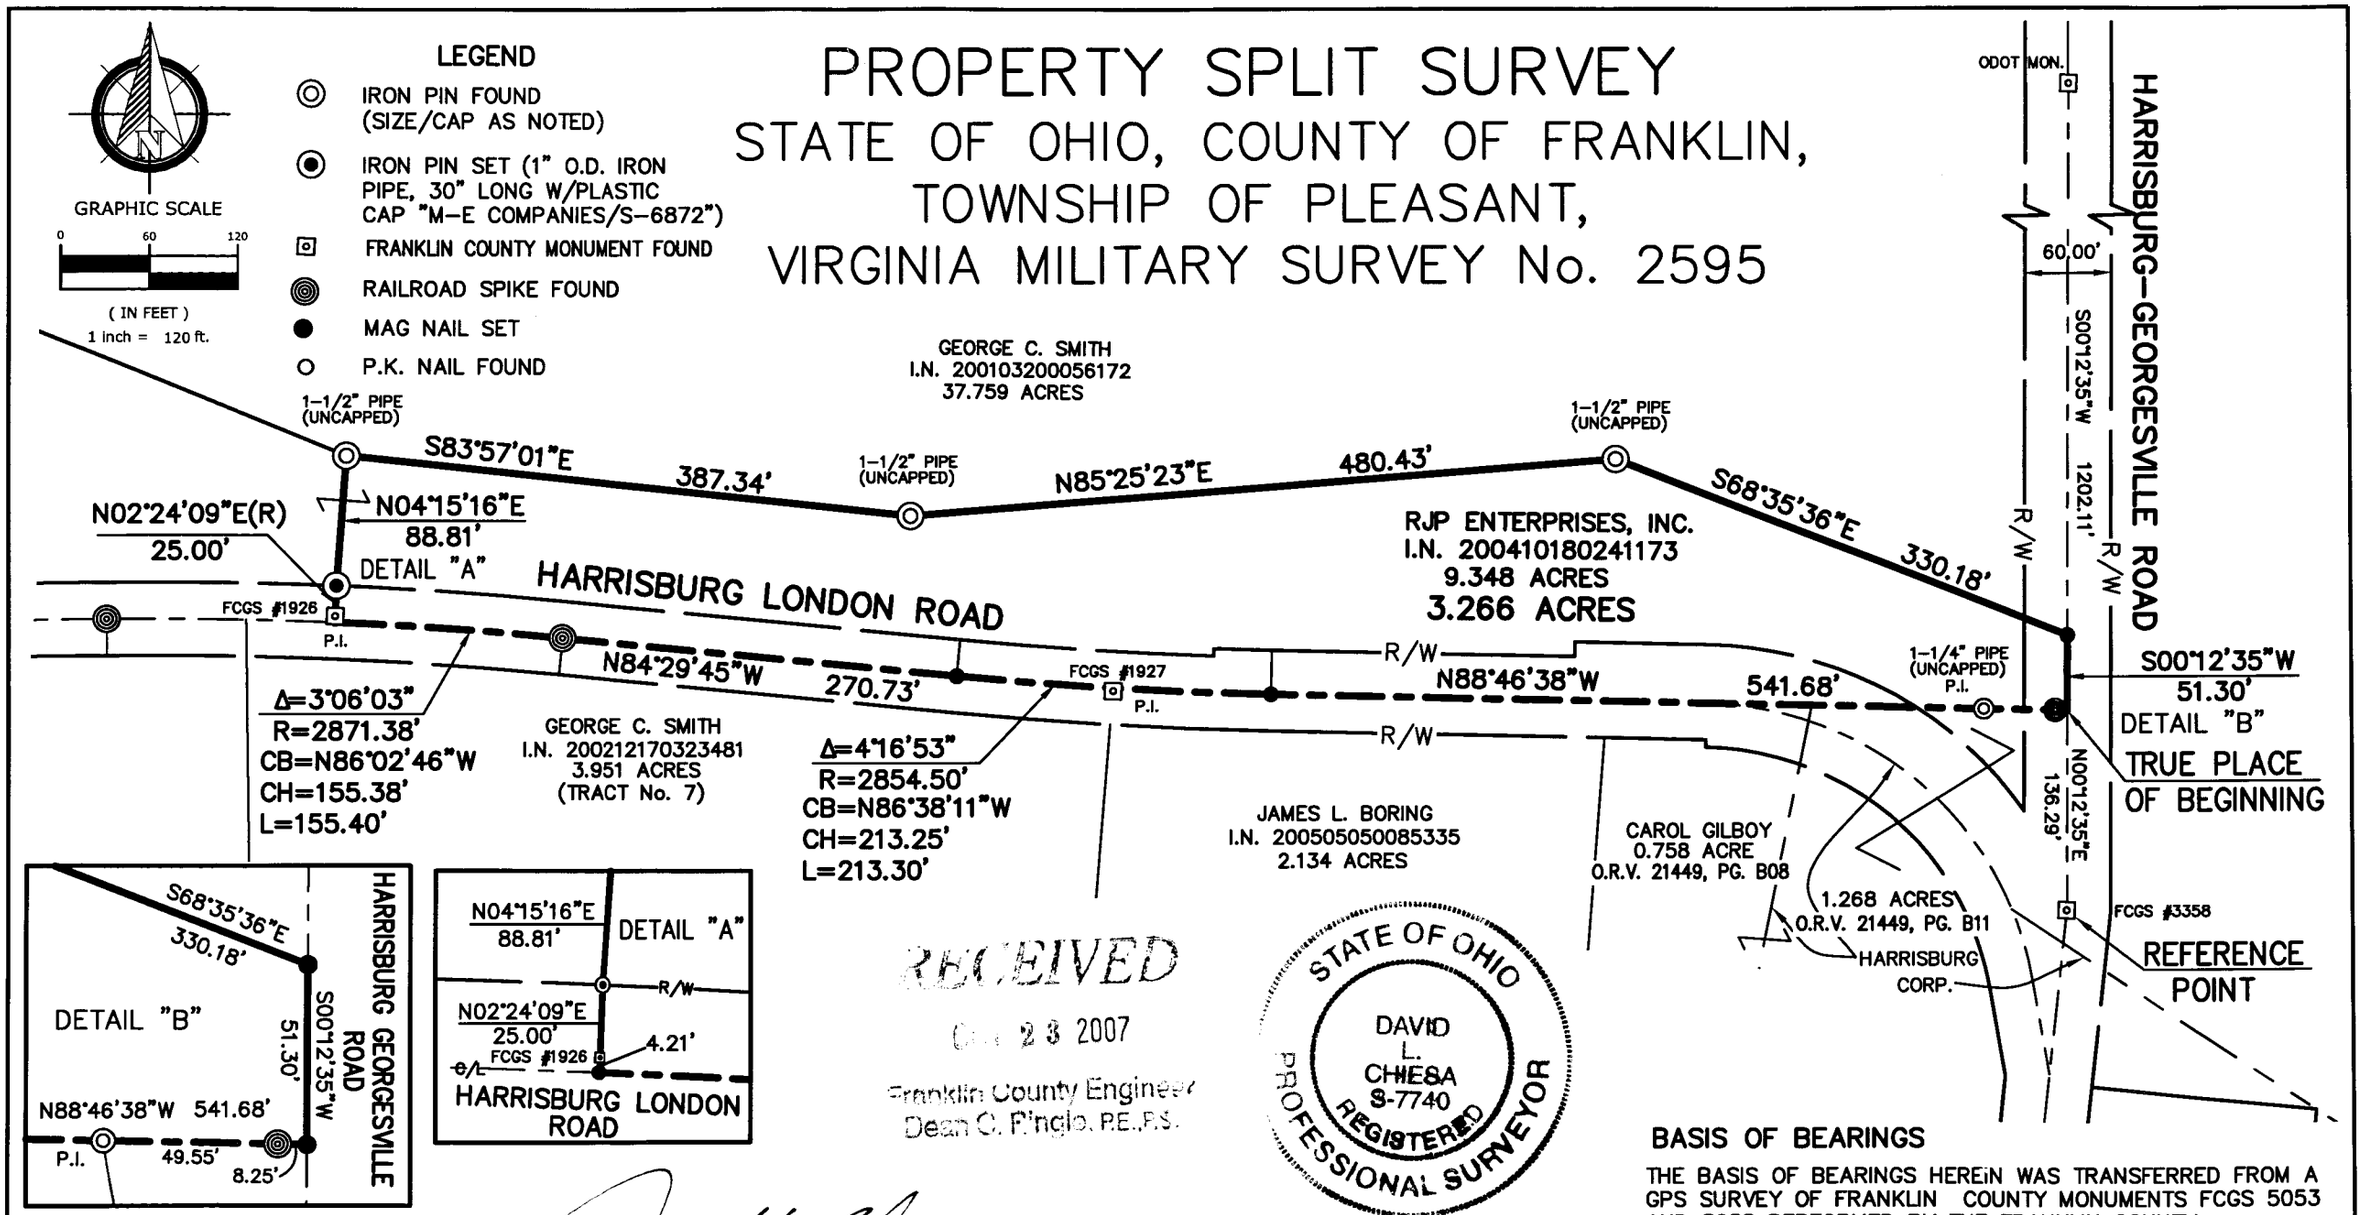

RECEIVED
Oct 23 2007
Franklin County Engineer
Dean C. Pinglo, P.E., P.S.

STATE OF OHIO
DAVID L. CHIESA
S-7740
REGISTERED
PROFESSIONAL SURVEYOR

BASIS OF BEARINGS

THE BASIS OF BEARINGS HEREIN WAS TRANSFERRED FROM A GPS SURVEY OF FRANKLIN COUNTY MONUMENTS FCGS 5053 AND 5055 PERFORMED BY THE FRANKLIN COUNTY ENGINEER'S OFFICE AND IS BASED ON THE NAD83 OHIO STATE PLANE COORDINATE SYSTEM, SOUTH ZONE, AND DETERMINES THE CENTERLINE OF HARRISBURG-GEORGESVILLE ROAD TO BE NORTH 00°12'35" EAST.

ME COMPANIES
635 Brooksedge Boulevard
Westerville, OH 43081
Contact: DAVE CHIESA
614-818-4900 ext. 225
Fax: 614-818-4902
www.mecompanies.com

Dave Chiesa 7740 10/17/07
REGISTERED SURVEYOR NO. DATE

J:\07\07-301\dwg\07301SPLIT.dwg by: dchiesa on 10/17/2007 @ 10:54:36 am ~ for M-E Companies, Inc.