


5750 Chandler Court
 Westerville, OH 43082
 E-Mail: hoyssinc@aol.com
 Phone (614) 895-1922
 Survey Fax (614) 895-1949
 Construction Fax (614) 895-9549

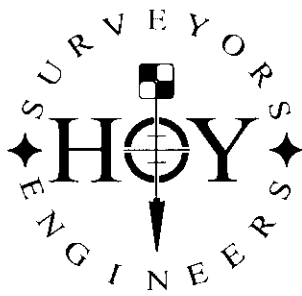

2942-07S


Order No.

CERTIFIED TO DANIEL GUTHRIE COUNTY OF FRANKLIN


CITY OF COLUMBUS SCALE 1" = 20' DATE 1-02-2008 DRN DBM CH

LOT 553/FOREST PARK EAST REVISED 3-28-08
 4982 SIENNA LANE
 COLUMBUS, OHIO

SIENNA LANE 50'

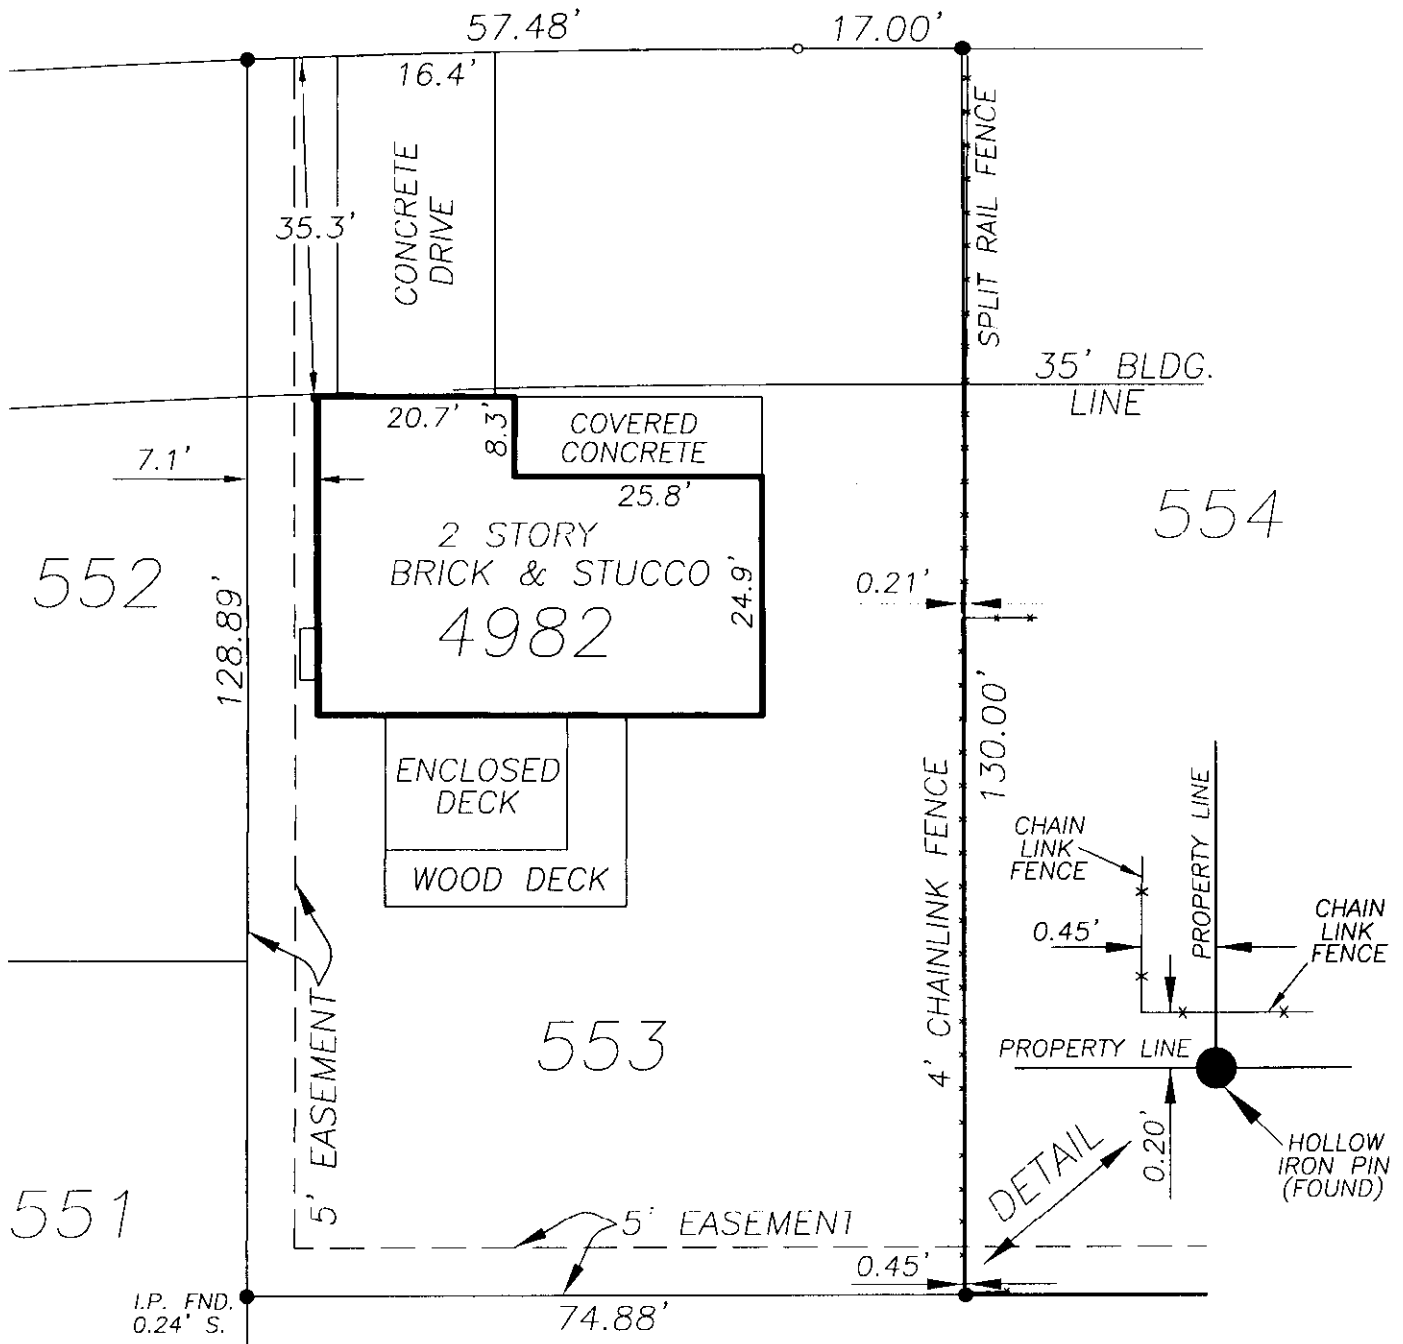

LEGEND:
 ● = IRON PIN FOUND

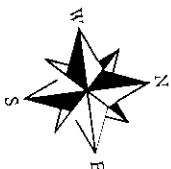

We hereby certify that the above plat was prepared from an actual field survey and to the best of our knowledge and belief is correct. All dimensions along arcs are chord distances.

HOY SURVEYING SERVICES, INC.

By David B. McCoy
 David B. McCoy
 Registered Professional Surveyor No. 7632

