RIGHT-OF-WAY DEDICATION & REMAINDER PARCEL

Quarter Township 3, Township 2, Range 18, United States Military Lands, of record in Instrument Number 199712220173204

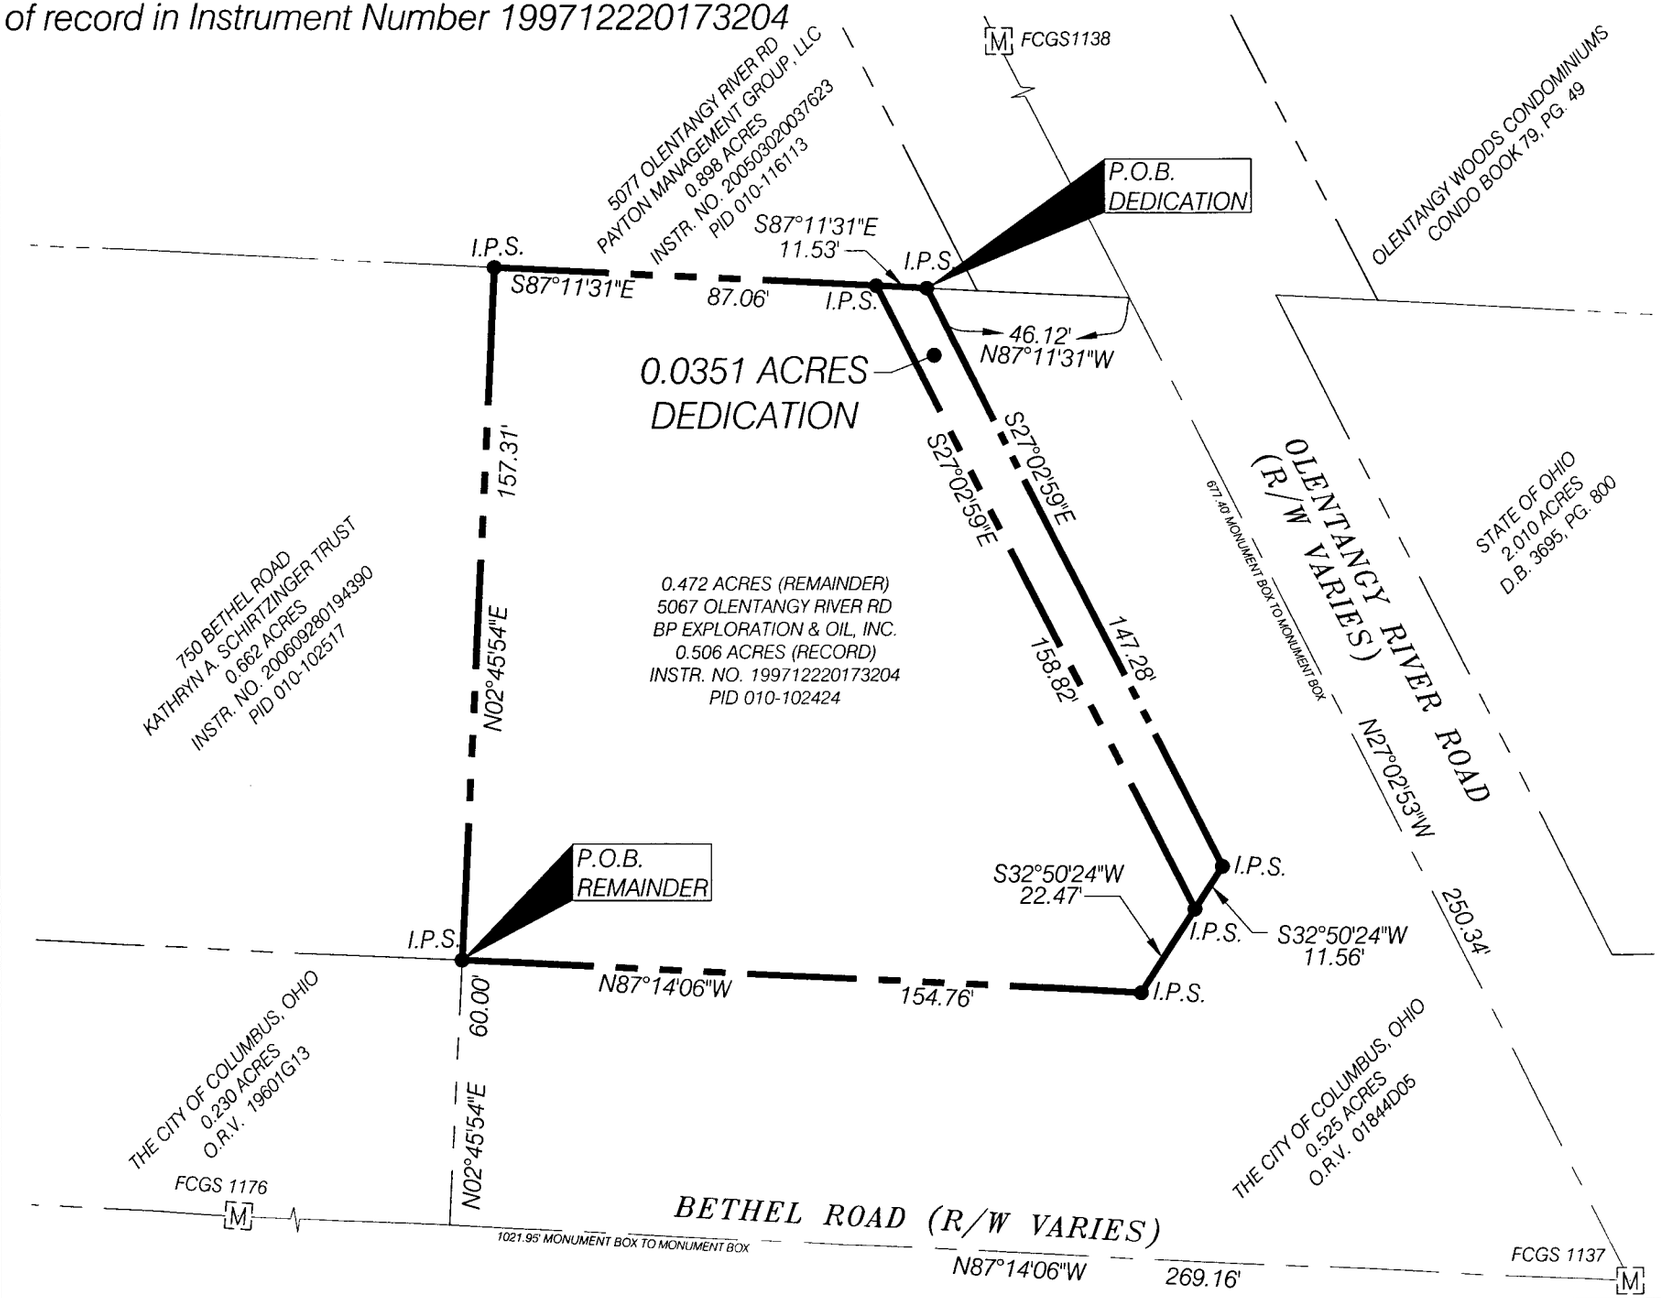

RECEIVED
JUL 08 2008
Franklin County Engineer
Dean C. Ringle, P.E., P.S.

wd partners
7007 Discovery Blvd
Dublin, Ohio 43017
614.634.7000 T
wdpartners.com

The bearings shown here are based on the Ohio State Plane Coordinate System, South Zone, using NAD1983 (1986 Adjustment). The bearing from Frank 161 to Frank 61 is South 85° 31' 37" East.
All bearings hereon are shown to indicate angles only.
This information is based upon a field survey performed by WD Partners in June, 2007.

Kevin P. Carpenter, P.S.# 8124

July 7, 2008

STATE OF OHIO
KEVIN P CARPENTER 8124
REGISTERED PROFESSIONAL SURVEYOR
07/07/08

LEGEND

● I.P.S. 3/4" x 30" IRON PIN SET

Ⓜ FRANKLIN COUNTY ENGINEER'S OFFICE GEODETIC SURVEY MONUMENT

NORTH

0 20 40 80

SCALE: 1" = 40.00'