EMH&T
Evans, Mechwart, Hambleton & Tilton, Inc.
Engineers • Surveyors • Planners • Scientists
5500 New Albany Road, Columbus, OH 43054
Phone: 614.775.4500 Fax: 614.775.4800
M C M X X V I

SURVEY OF ACREAGE TRACT
SECTION 9, QUARTER TOWNSHIP 1, TOWNSHIP 2, RANGE 16
UNITED STATES MILITARY LANDS
VILLAGE OF NEW ALBANY, COUNTY OF FRANKLIN, STATE OF OHIO

Date: August 19, 2008
Scale: 1" = 200'
Job No: 2008-1381

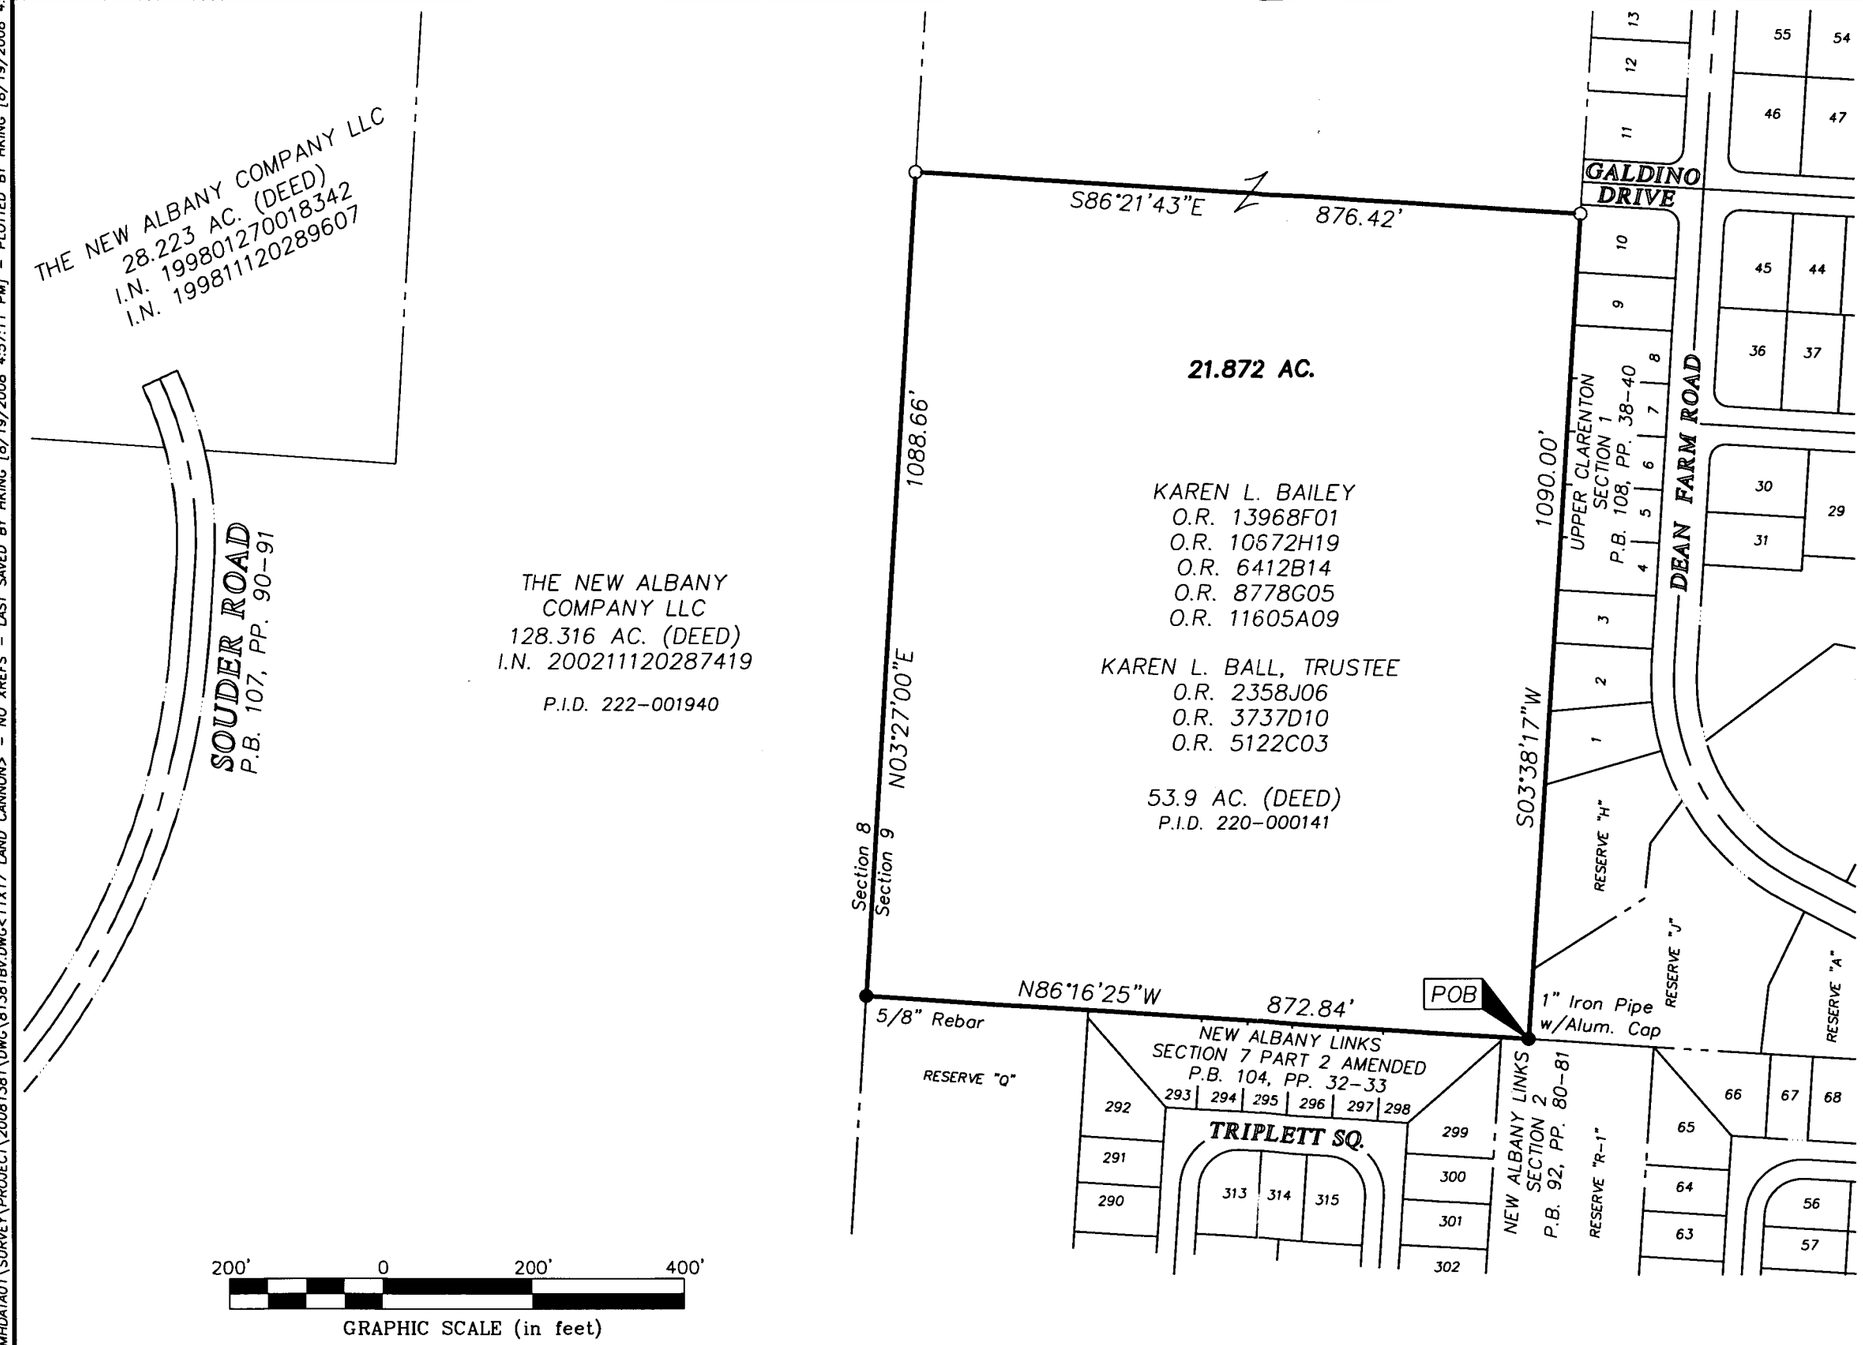

● = STONE FND.
■ = MON. FND.
● = I.P. FND.
○ = I.P. SET
⬢ = MAG. NAIL FND.
⬡ = MAG. NAIL SET
▲ = R.R. SPK. FND.
△ = R.R. SPK. SET
⬟ = P.K. NAIL FND.

I.P. Set are 13/16" I.D. iron pipes with cap inscribed EMHT INC

BASIS OF BEARINGS:
Bearings are based on the Ohio State Plane Coordinate System, South Zone, as per NAD83 (1986 adjustment). Control for bearings was from coordinates of monuments FRANK 80 and FRANK 180, having a bearing of North 85° 57' 24" West, as established by the Franklin County Engineering Department.

SURVEY NOTE:
This survey was prepared using documents of record, prior plats of survey, and observed evidence located by an actual field survey.

RECEIVED
AUG 19 2008
Franklin County Engineer
Dean C. Ringle, P.E.,P.S.

STATE OF OHIO
HEATHER L. KING
S-8307
REGISTERED PROFESSIONAL SURVEYOR

By [signature] 8/19/08
Professional Surveyor No. 8307

\\CMHDATA01\SURVEY\PROJECT\20081381\DWG\81381BV.DWG<11X17 LAND CANNON> - NO XREFS - LAST SAVED BY HKING [8/19/2008 4:57:11 PM] - PLOTTED BY HKING [8/19/2008 4:57:11 PM]