



Boundary Survey

Section 14, Township 4, Range 22, Congress Lands East of Scioto River
City of Columbus, Franklin County, Ohio

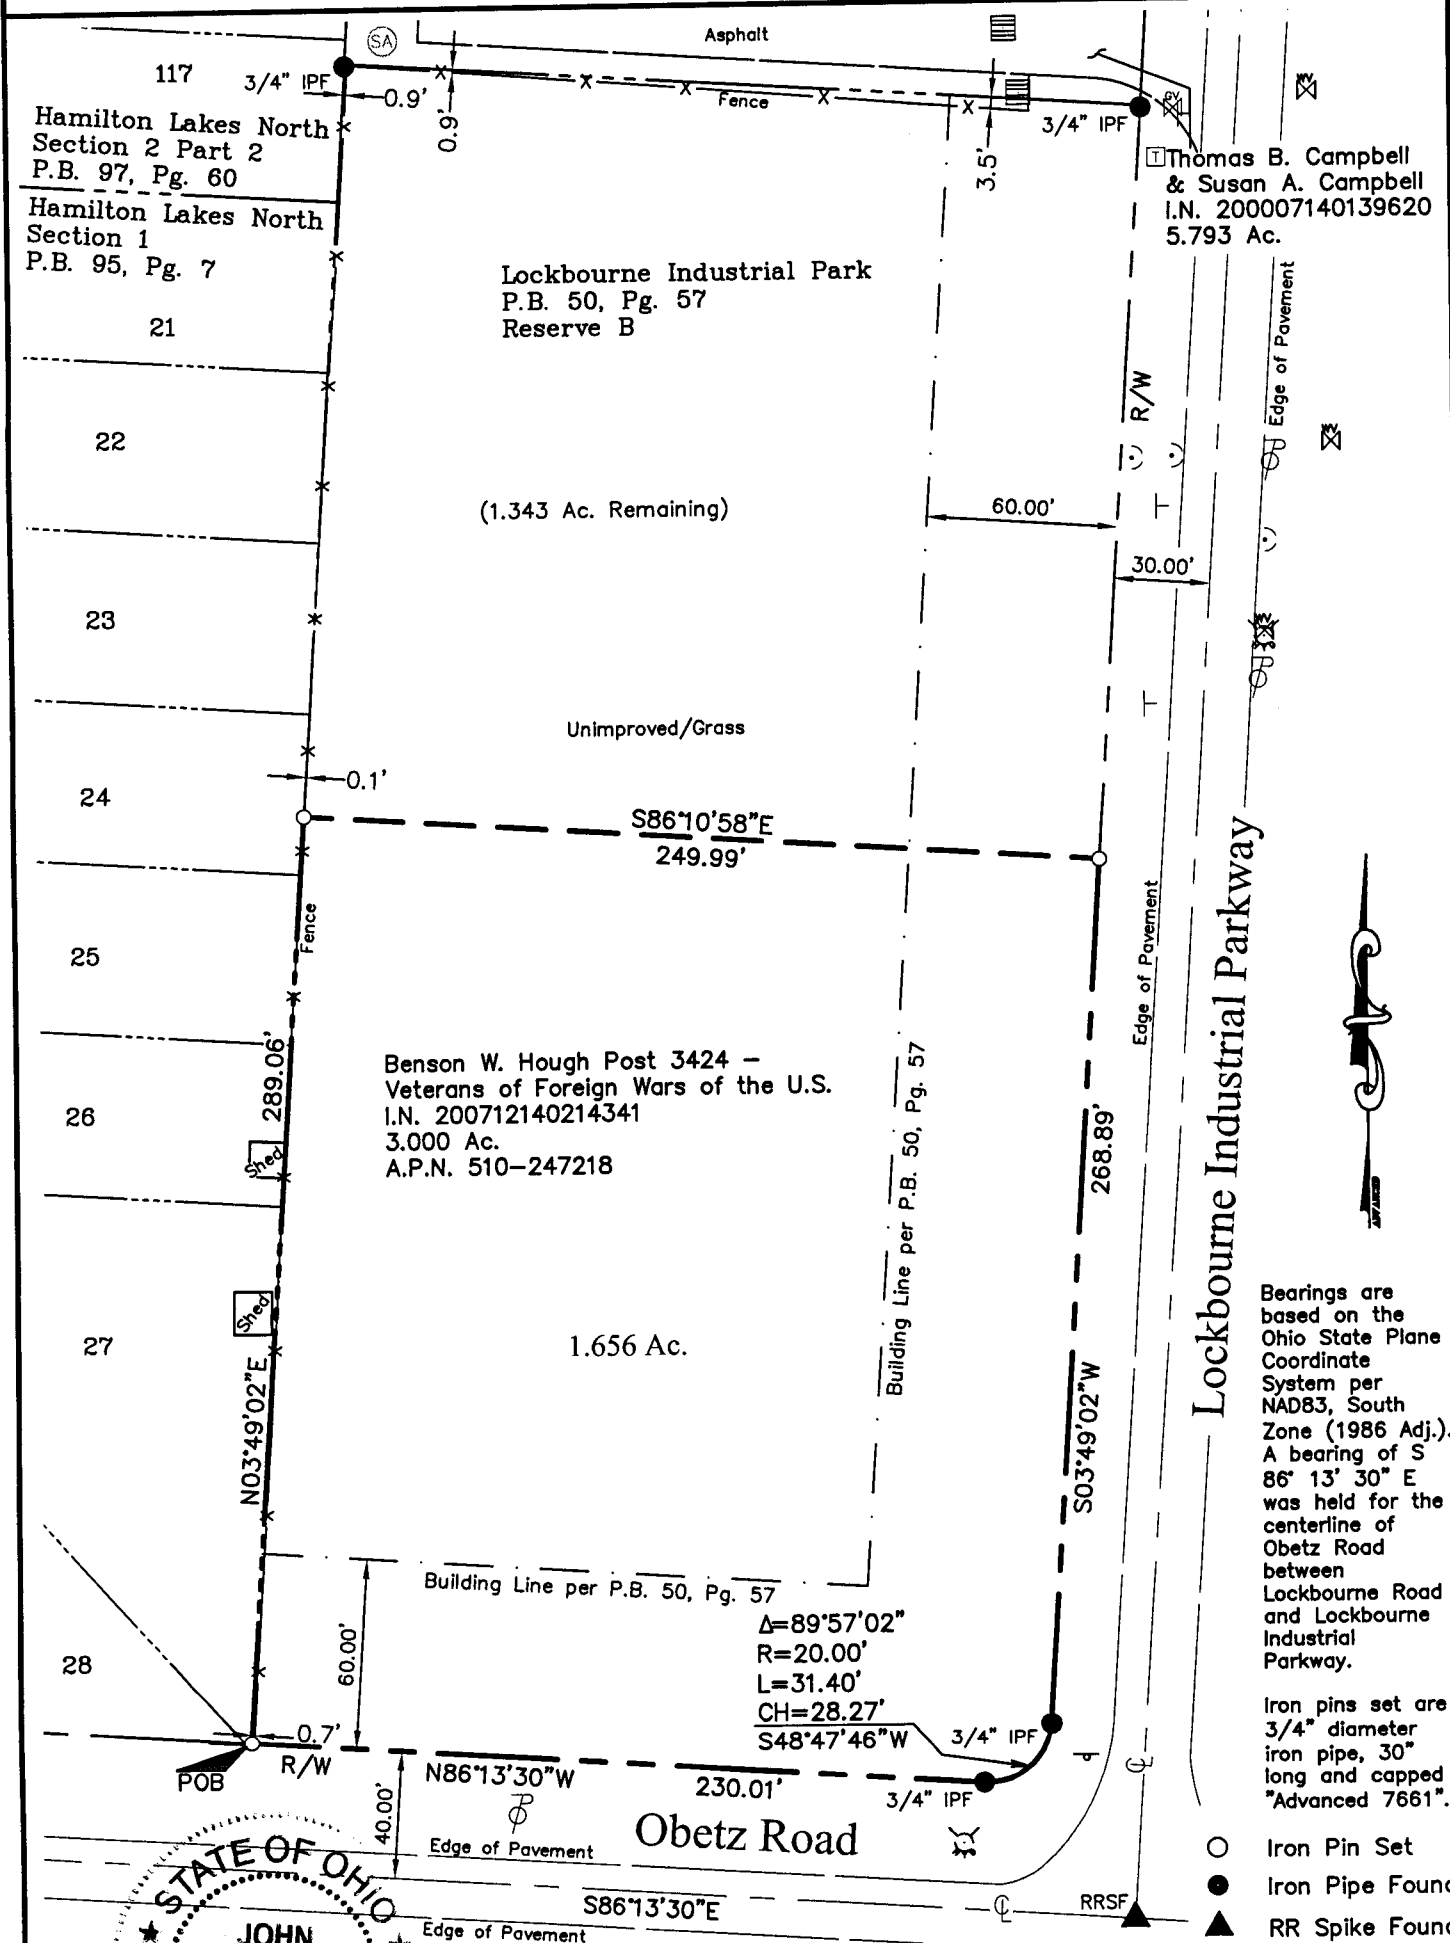

STATE OF OHIO
JOHN C. DODGION
8069
REGISTERED SURVEYOR

John C. Dodgion 12/02/2008
John C. Dodgion, P.S. 8069

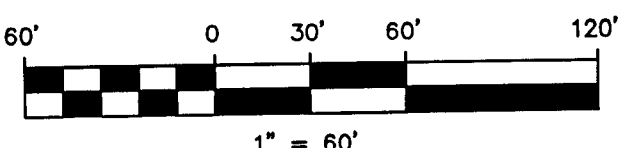

DRAWN BY: JCD	JOB NO.: 08-0002-216
DATE: 11/20/2008	CHECKED BY: DRH



ADVANCED
CIVIL DESIGN
ENGINEERS SURVEYORS

422 Beecher Road
Gahanna, Ohio 43230
ph 614.428.7750
fax 614.428.7755