


LOT SPLIT OF 3.211 ACRES  
PARCEL #161-000009  
LOCATED IN  
VIRGINIA MILITARY SURVEY No. 1388  
VILLAGE OF URBANCREST, FRANKLIN COUNTY, OHIO

**RECEIVED**

DEC 16 2008

Franklin County Engineer  
Dean C. Ringle, P.E., P.S.

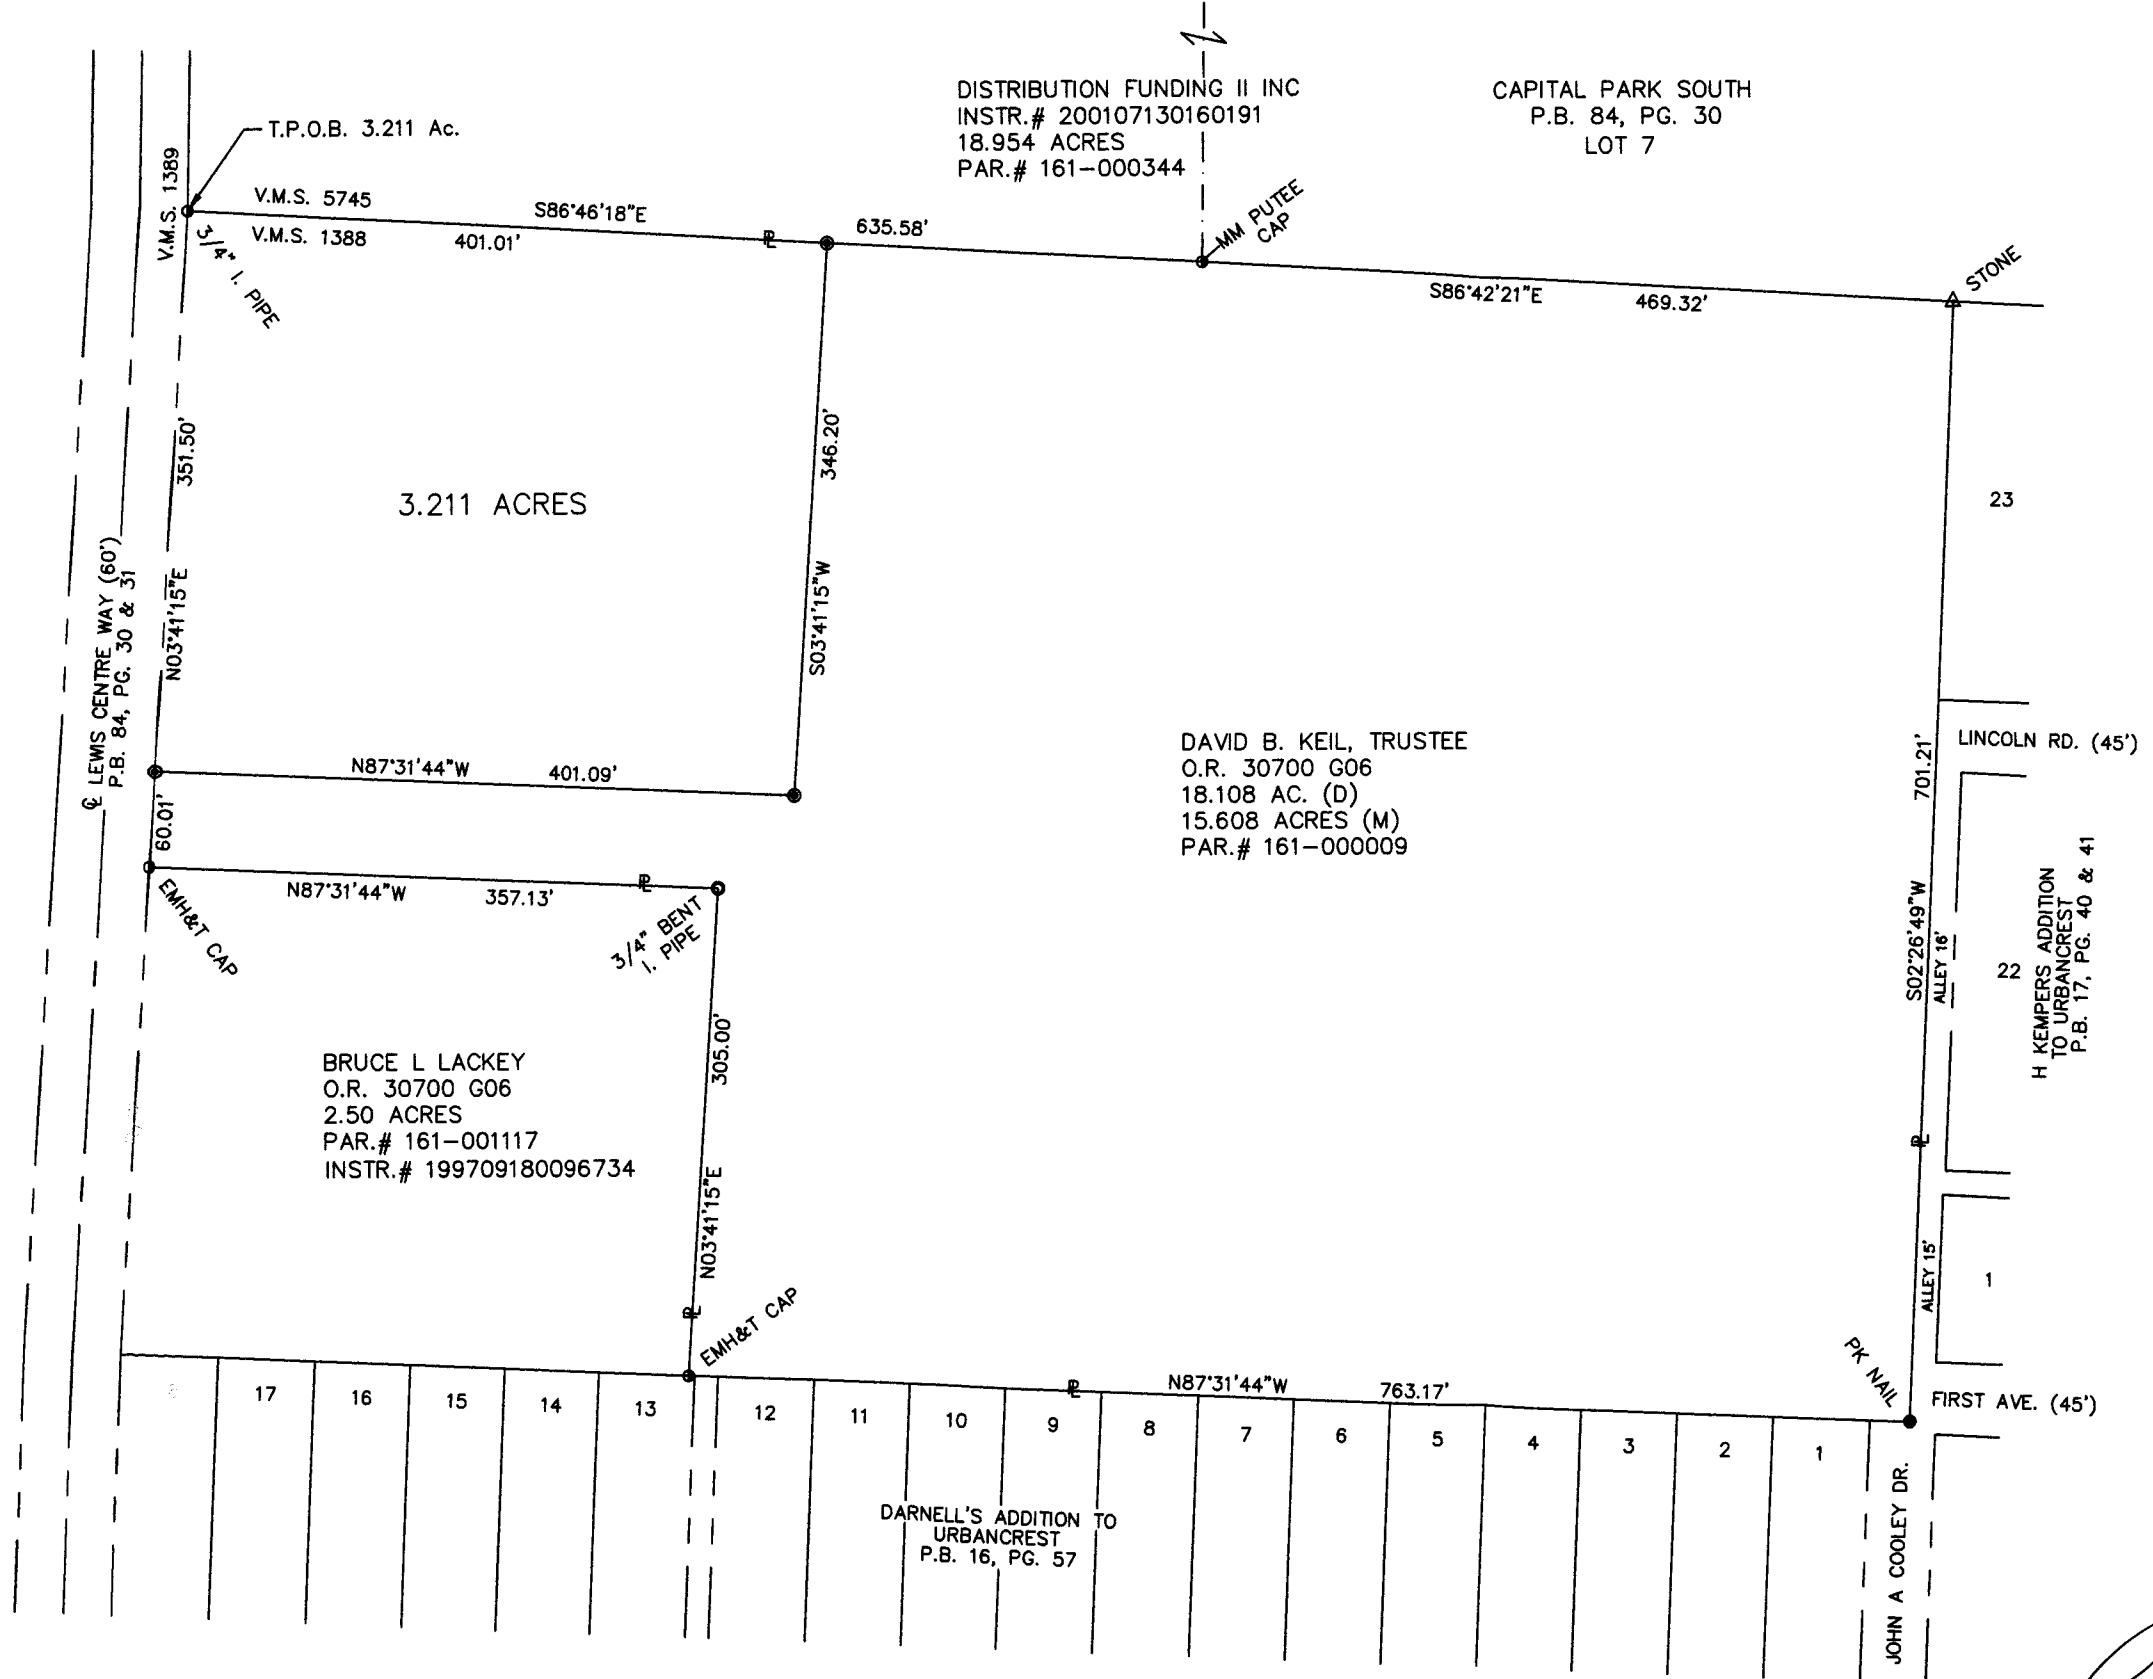


**LEGEND**

- CAPPED IRON PIN SET (8067)
- P.K. NAIL FOUND
- CAPPED PIN FOUND
- IRON PIN/PIPE FOUND
- ◆ BENCHMARK
- ▲ STONE FOUND

1 inch = 120 ft.

**BASIS OF BEARING**  
Bearings are based on a centerline of Lewis Centre Way shown in shown on Plat of CAPITAL PARK SOUTH P.B. 84, P.G. 30 & 31 as being N03°41'15"E .

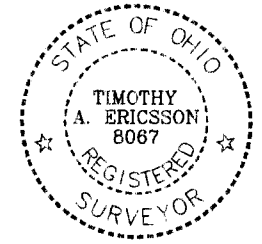

*TE*  
TIMOTHY A. ERICSSON P.S. 8067  
12/16/08  
DATE