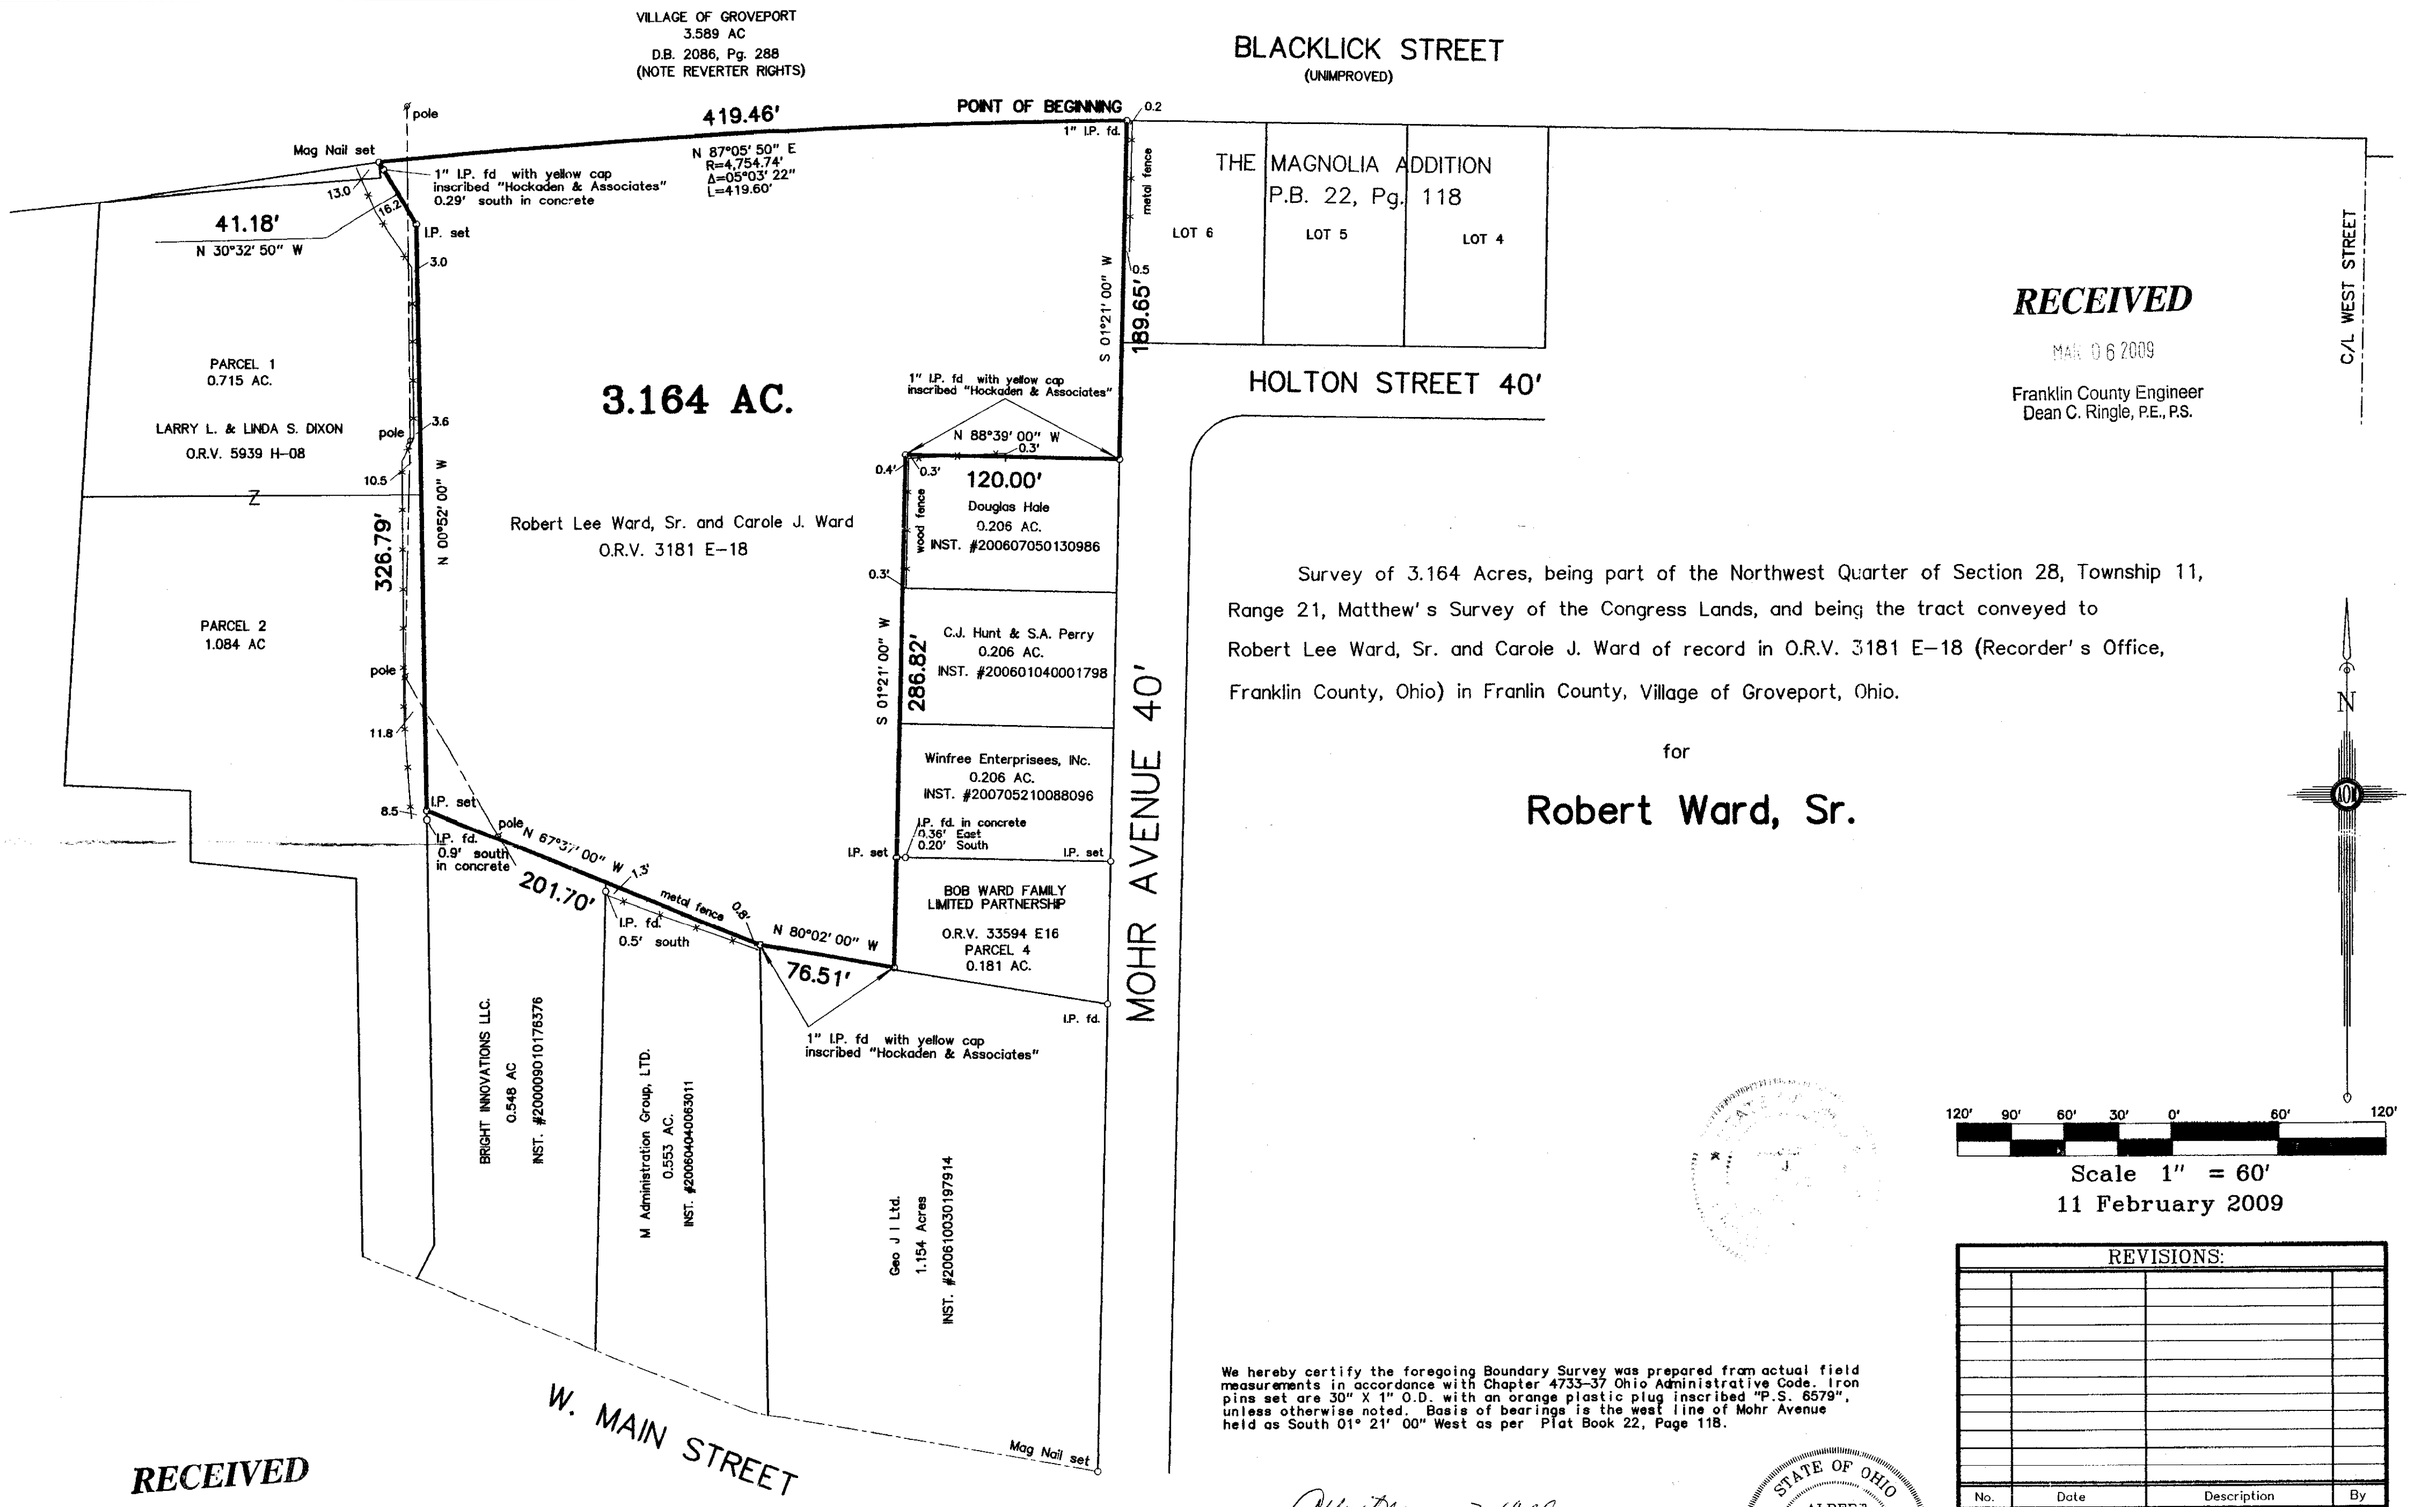

RECEIVED
MAR 06 2009
Franklin County Engineer
Dean C. Ringle, P.E., P.S.

Survey of 3.164 Acres, being part of the Northwest Quarter of Section 28, Township 11, Range 21, Matthew's Survey of the Congress Lands, and being the tract conveyed to Robert Lee Ward, Sr. and Carole J. Ward of record in O.R.V. 3181 E-18 (Recorder's Office, Franklin County, Ohio) in Franlin County, Village of Groveport, Ohio.

for

Robert Ward, Sr.

120' 90' 60' 30' 0' 60' 120'

Scale 1" = 60'
11 February 2009

We hereby certify the foregoing Boundary Survey was prepared from actual field measurements in accordance with Chapter 4733-37 Ohio Administrative Code. Iron pins set are 30" X 1" O.D. with an orange plastic plug inscribed "P.S. 6579", unless otherwise noted. Basis of bearings is the west line of Mohr Avenue held as South 01° 21' 00" West as per Plat Book 22, Page 118.

BY: Albert J. Myers 2-18-09
Albert J. Myers, Professional Surveyor No. 6579

STATE OF OHIO
ALBERT J. MYERS
6579
REGISTERED
PROFESSIONAL SURVEYOR

REVISIONS:

No.	Date	Description	By

MyersSurveying COMPANY
2740 East Main Street (614) 235 - 8677
Bexley, Ohio 43209-2577 info@myerssurveying.com

4-01-27-2009	401272009.scj	X-	T-

SITECOMP REO Boundary