


**SURVEY OF ACREAGE PARCEL**  
**QUARTER TOWNSHIP 4, TOWNSHIP 1, RANGE 19**  
**UNITED STATES MILITARY LANDS**  
**CITY OF UPPER ARLINGTON, COUNTY OF FRANKLIN, STATE OF OHIO**



\\CMHDATA01\PROJECT01\20081620\200816205\DWG\1620B4.DWG<18X24 PORTRAIT> - NO XREFS - LAST SAVED BY H KING [6/18/2009 2:59:01 PM] - PLOTTED BY H KING [6/18/2009 2:59:01 PM]

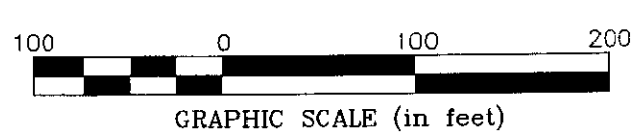


LINE TABLE		
LINE	BEARING	DISTANCE
L1	S02°59'22"W	24.28'
L2	N87°00'38"W	63.73'
L3	N56°04'08"W	33.43'

CURVE TABLE					
CURVE	DELTA	RADIUS	ARC	CH BRG	CH
C1	30°56'30"	35.00'	18.90'	N71°32'23"W	18.67'

**BASIS OF BEARINGS:**  
 The Bearings shown hereon are based on the Ohio State Plane Coordinate System South Zone as per NAD83 (1986 Adjustment). Control for bearings was from coordinates of monuments FCCS 6666 and 6667, having a bearing of South 00° 00' 00" East, established by the Franklin County Engineering Department, using Global Positioning System procedures and equipment.

- = STONE FND.
  - = MON. FND.
  - = I.P. FND.
  - = I.P. SET
  - = MAG. NAIL FND.
  - = MAG. NAIL SET
  - ▲ = R.R. SPK. FND.
  - △ = R.R. SPK. SET
  - ◆ = P.K. NAIL FND.
- I.P. Set are 13/16" I.D. iron pipe with cap inscribed EMHT INC

**RECEIVED**  
 JUN 12 2009  
 Franklin County Engineer  
 Dean C. Ringle, P.E., P.S.

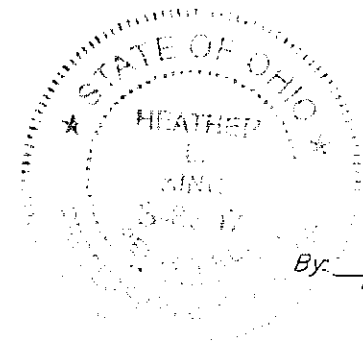

By: *Heather L. King* 6/19/09  
 Professional Surveyor No. 8307

<b>EMHT</b> Evans, Mechwart, Hambleton & Tilton, Inc. Engineers • Surveyors • Planners • Scientists 5500 New Albany Road, Columbus, OH 43054 Phone: 614.775.4500 Fax: 614.775.4800	Date: June 9, 2009	
	Scale: 1" = 100'	
	Job No: 2008-1620	
	Sheet: 1 of 1	
REVISIONS		
MARK	DATE	DESCRIPTION
HLK	6/17/09	Revisions per county comments