REVISIONS:			
1	8/6/2009	Acreage out of parcels	aomiii
No.	Date	Description	By

BOUNDARY SURVEY

80' 60' 40' 20' 0' 40' 80'

Scale 1" = 40'
May 28, 2009

RECEIVED

AUG 06 2009

Franklin County Engineer
Dean C. Ringle, P.E., P.S.

A Survey situated in the State of Ohio, County of Franklin, City of Whitehall, part of Lots 15 thru 18, inclusive, of Lowrie Brothers East Broad Street Acre Allotment in Plat Book 8, Page 18-A, part of the 2.096 Acre tract and Parcel No. 2 as conveyed to Sagi Realty Ltd. in Official Record Volume 31560 C-14 and Instrument 200202260050535, respectively, Recorder's Office , Franklin County, Ohio for:

Safe Auto Insurance Co.

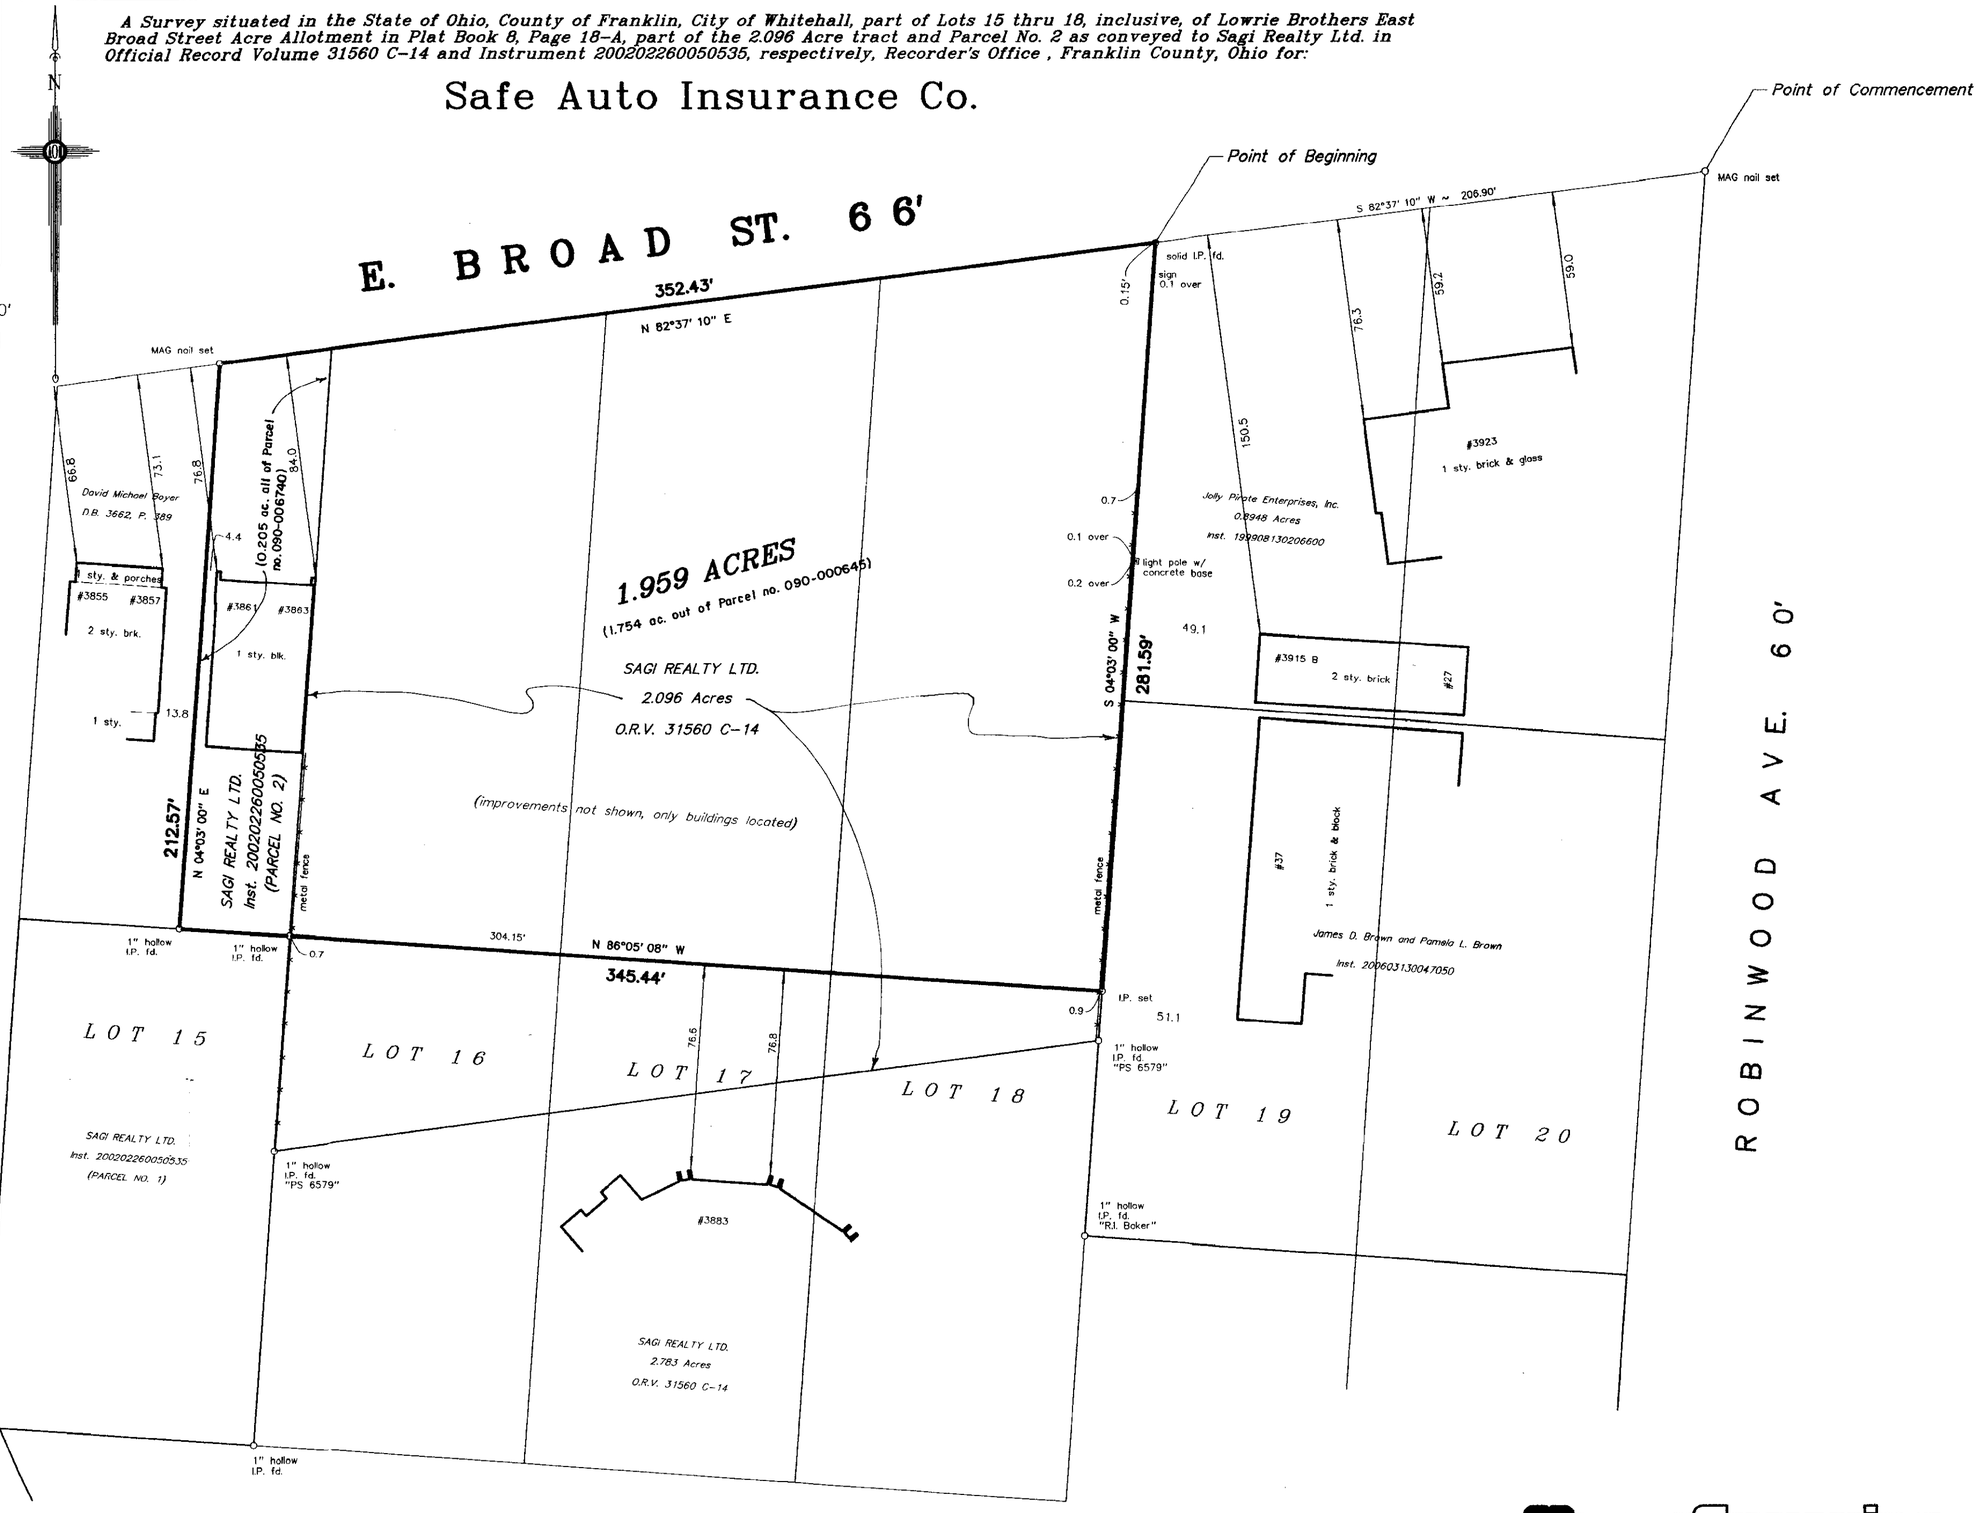

We hereby certify that the foregoing Boundary Survey was prepared from actual field measurements in accordance with Chapter 4733-37 Ohio Administrative Code. Iron pipes set are 30" X 1" O.D. with an orange plastic plug inscribed "P.S. 6579", unless otherwise noted. Basis of bearings is the south line of Lot 203 Lowrie Bros. East Broad Street Acre Allotment held as North 85° 56' 30" West as shown in D.B. 2944, P. 482.

Albert J. Myers, Professional Surveyor No. 6579

MyersSurveying COMPANY
2740 East Main Street (614) 235 - 8677
Bexley, Ohio 43209-2577 info@myerssurveying.com

m.o.#2-05/08/2009	205082009.scj	X - 926-A	T-3508