29016 C-6-D

Note: Iron pins (found) are 30" X 1" O.D. with yellow plastic caps inscribed 6065 and in good condition.

Note: Iron pins (found) are 1" O.D. and in good condition.

# 2.997 ACRE BOUNDARY SURVEY

Situated in the State of Ohio, County of Franklin, Township of Prairie, being in Virginia Military Survey No. 1436, and being a 2.997 acre tract of land, and also being all of Lot No's 1,2, and 3, (vacated, as shown of record in Deed Volume 2729, page 202) as delineated upon Genheimer Subdivision as shown of record in Plat Book 24, page 67, as conveyed to Margaret A. Ervin be deed of record in Deed Volume 2516, page 171, records of the Recorders Office, Franklin County, Ohio.

PREPARED FOR: TOM CLARK ESQ.

DATE: DEC. 30, 2009
SCALE: 1" = 100'

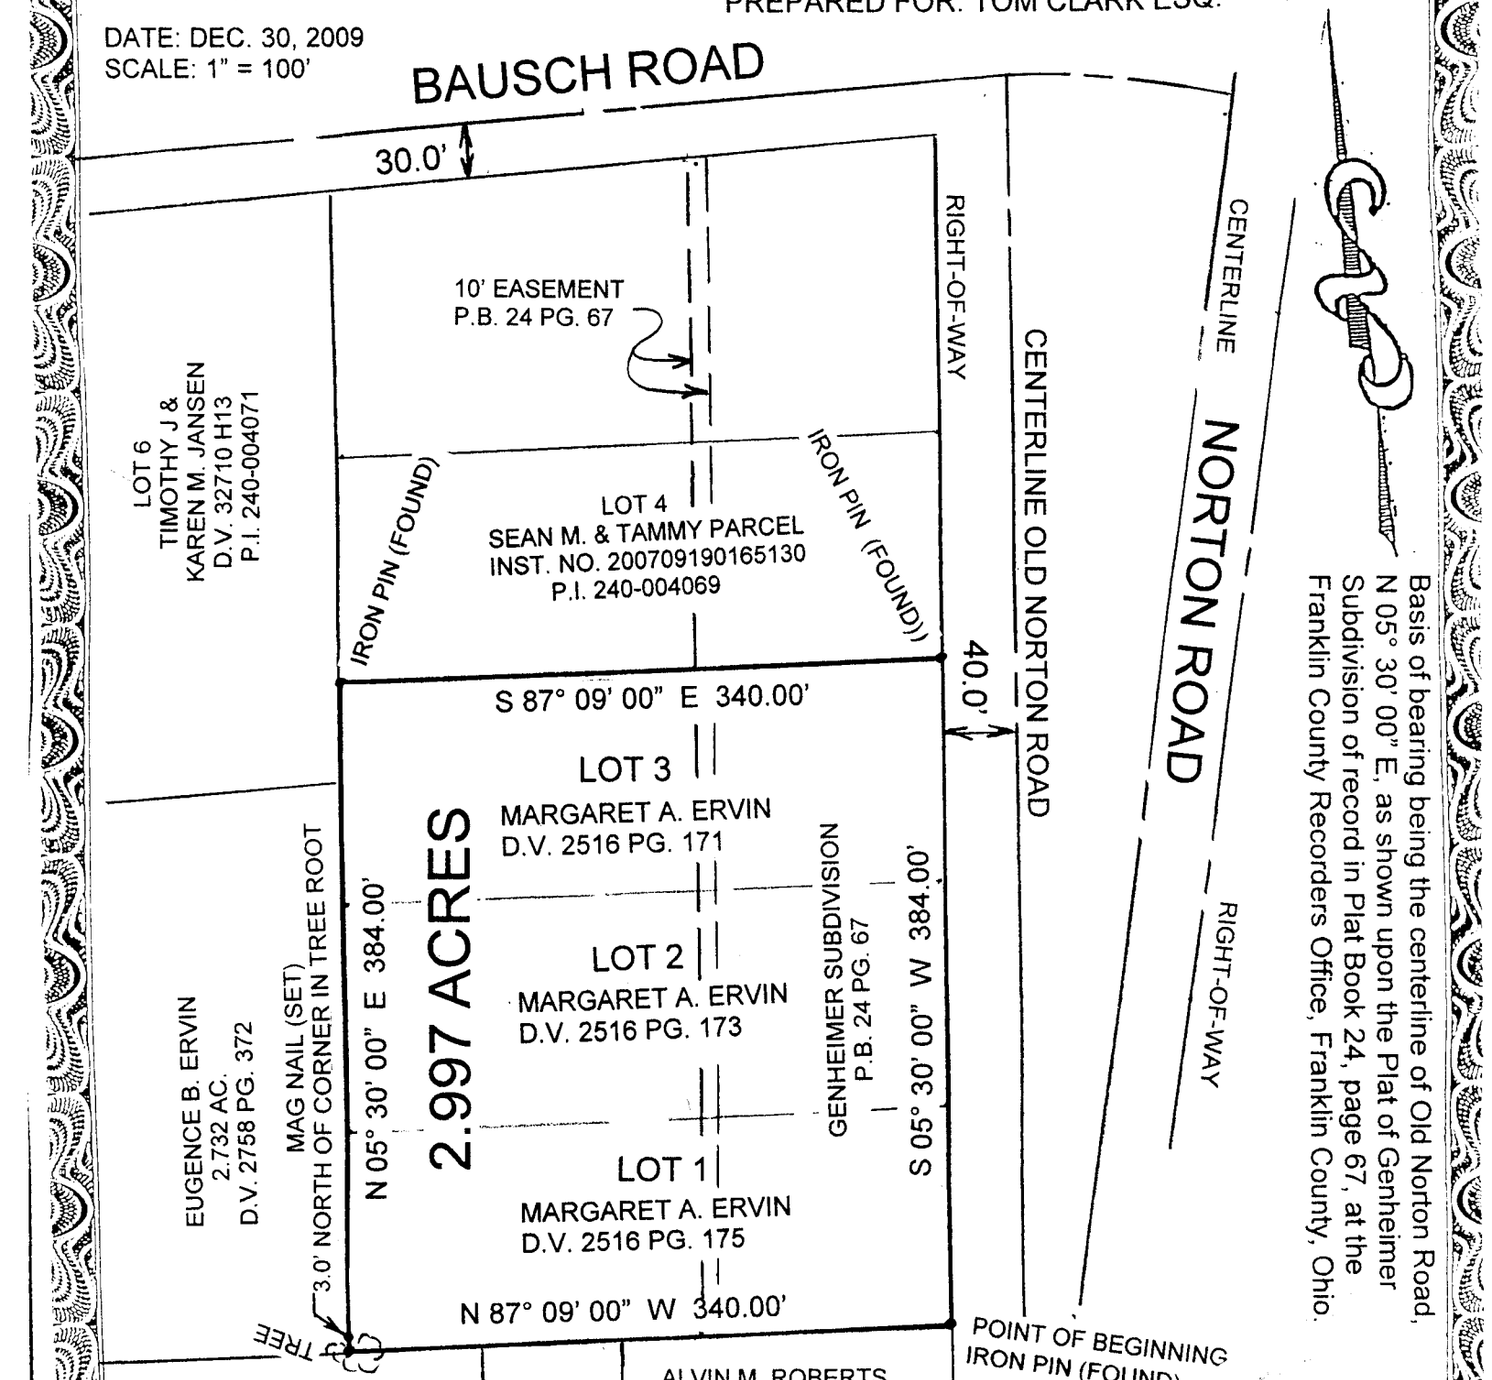


Basis of bearing being the centerline of Old Norton Road, N 05° 30' 00" E, as shown upon the Plat of Genheimer Subdivision of record in Plat Book 24, page 67, at the Franklin County Recorders Office, Franklin County, Ohio.

RECEIVED
JAN 19 2010
Franklin County Engineer
Dean C. Ringle, P.E., P.S.

VACATION OF LOTS NO. 1,2, & 3
OF RECORD IN D.V. 2729, PG.202

STATE OF OHIO
ROGER P. ARNOLD
S-6065
REGISTERED SURVEYOR

1/15/2010

PROFESSIONAL SURVEYOR NO. 6065