EMH&T
Evans, Mechwart, Hambleton & Tilton, Inc.
Engineers • Surveyors • Planners • Scientists
5500 New Albany Road, Columbus, OH 43054
Phone: 614.775.4500 Toll Free: 888.775.3648
emht.com

SURVEY OF ACREAGE PARCEL

HALF SECTION 52 OF SECTION 29, TOWNSHIP 12, RANGE 21
HALF SECTION 53 OF SECTION 30, TOWNSHIP 12, RANGE 21
REFUGEE LANDS
CITY OF COLUMBUS, COUNTY OF FRANKLIN, STATE OF OHIO

Date: December 3, 2009
Scale: 1" = 100
Job No: 2009-1044

SURVEY NOTE:
This survey was prepared using documents of record, prior plats of survey, and observed evidence located by an actual field survey.

BASIS OF BEARINGS:
The bearings shown heron are based on the Ohio State Plane Coordinate System, South Zone, NAD83 (1986 Adjustment). Said bearings originated from a field traverse which was tied (referenced) to said coordinate system by GPS observations and observations of selected Franklin County Monuments FCGS 9918 and FCGS 2251. In which a portion of the centerline of Wadsworth Drive has a bearing of S 04° 10' 46" W.

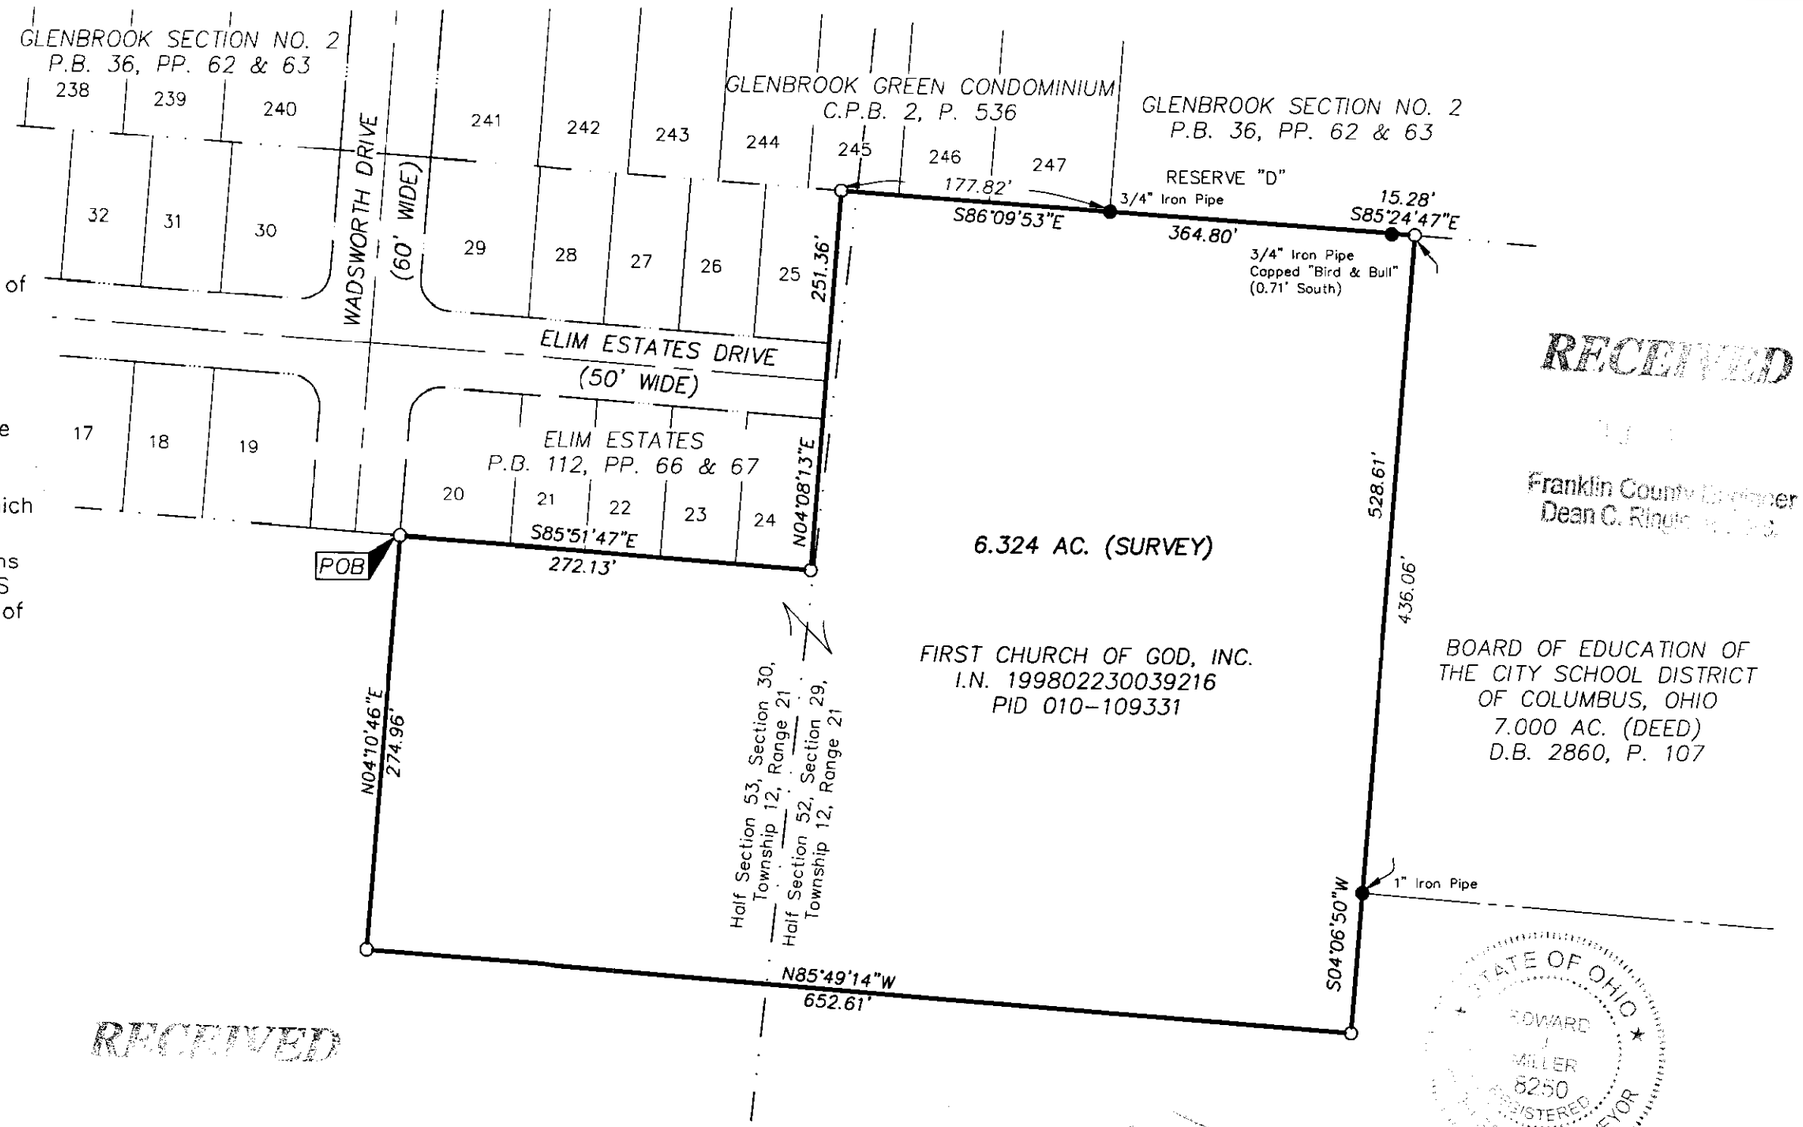

● = STONE FND.
■ = MON. FND.
● = I.P. FND.
○ = I.P. SET
⬢ = MAG. NAIL FND.
⬡ = MAG. NAIL SET
▲ = R.R. SPK. FND.
△ = R.R. SPK. SET
⬟ = P.K. NAIL FND.
I.P. Set are 13/16" I.D. iron pipe with cap inscribed EMHT INC

100' 0 100' 200'
GRAPHIC SCALE (in feet)

RECEIVED
Franklin County Engineer
Dean C. Ringle, P.E., P.S.

RECEIVED
Franklin County Engineer
Joel C. Kalish, P.E., P.S.

STATE OF OHIO
EDWARD J. MILLER
8250
REGISTERED
PROFESSIONAL SURVEYOR

By _____
Professional Surveyor No. 8250
Edward J. Miller

2/11/10
Date

J:\20091044\20091044SV\DWG\20091044BV2.DWG plotted by MASTON, JOHN on 2/17/2010 10:23:59 AM last saved by MRISSLER on 12/4/2009 8:04:13 AM
Xrefs: