

Myers Surveying Company, Inc.

2740 East Main Street, Columbus 43209 (Bexley), Ohio

614-235-8677

FAX:614-235-4559


A Boundary Survey prepared for and certified to:

Pinnacle Golf Club

Legal Description: Situated in The State of Ohio, County of Franklin, City of Grove City Being Lot 392 Pinnacle Club Section 3, Plat Book 109, Page 26.

Applicant:


Posted Address: Pinnacle Club Drive, Grove City, Ohio

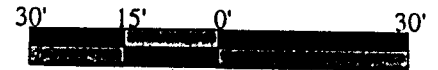

Scale 1" = 30'

Date: 02/01/2010

PINNACLE DEVELOPMENT COMPANY OF GROVE CITY, LTD.
16.829 AC. - I.N. 200410220245257

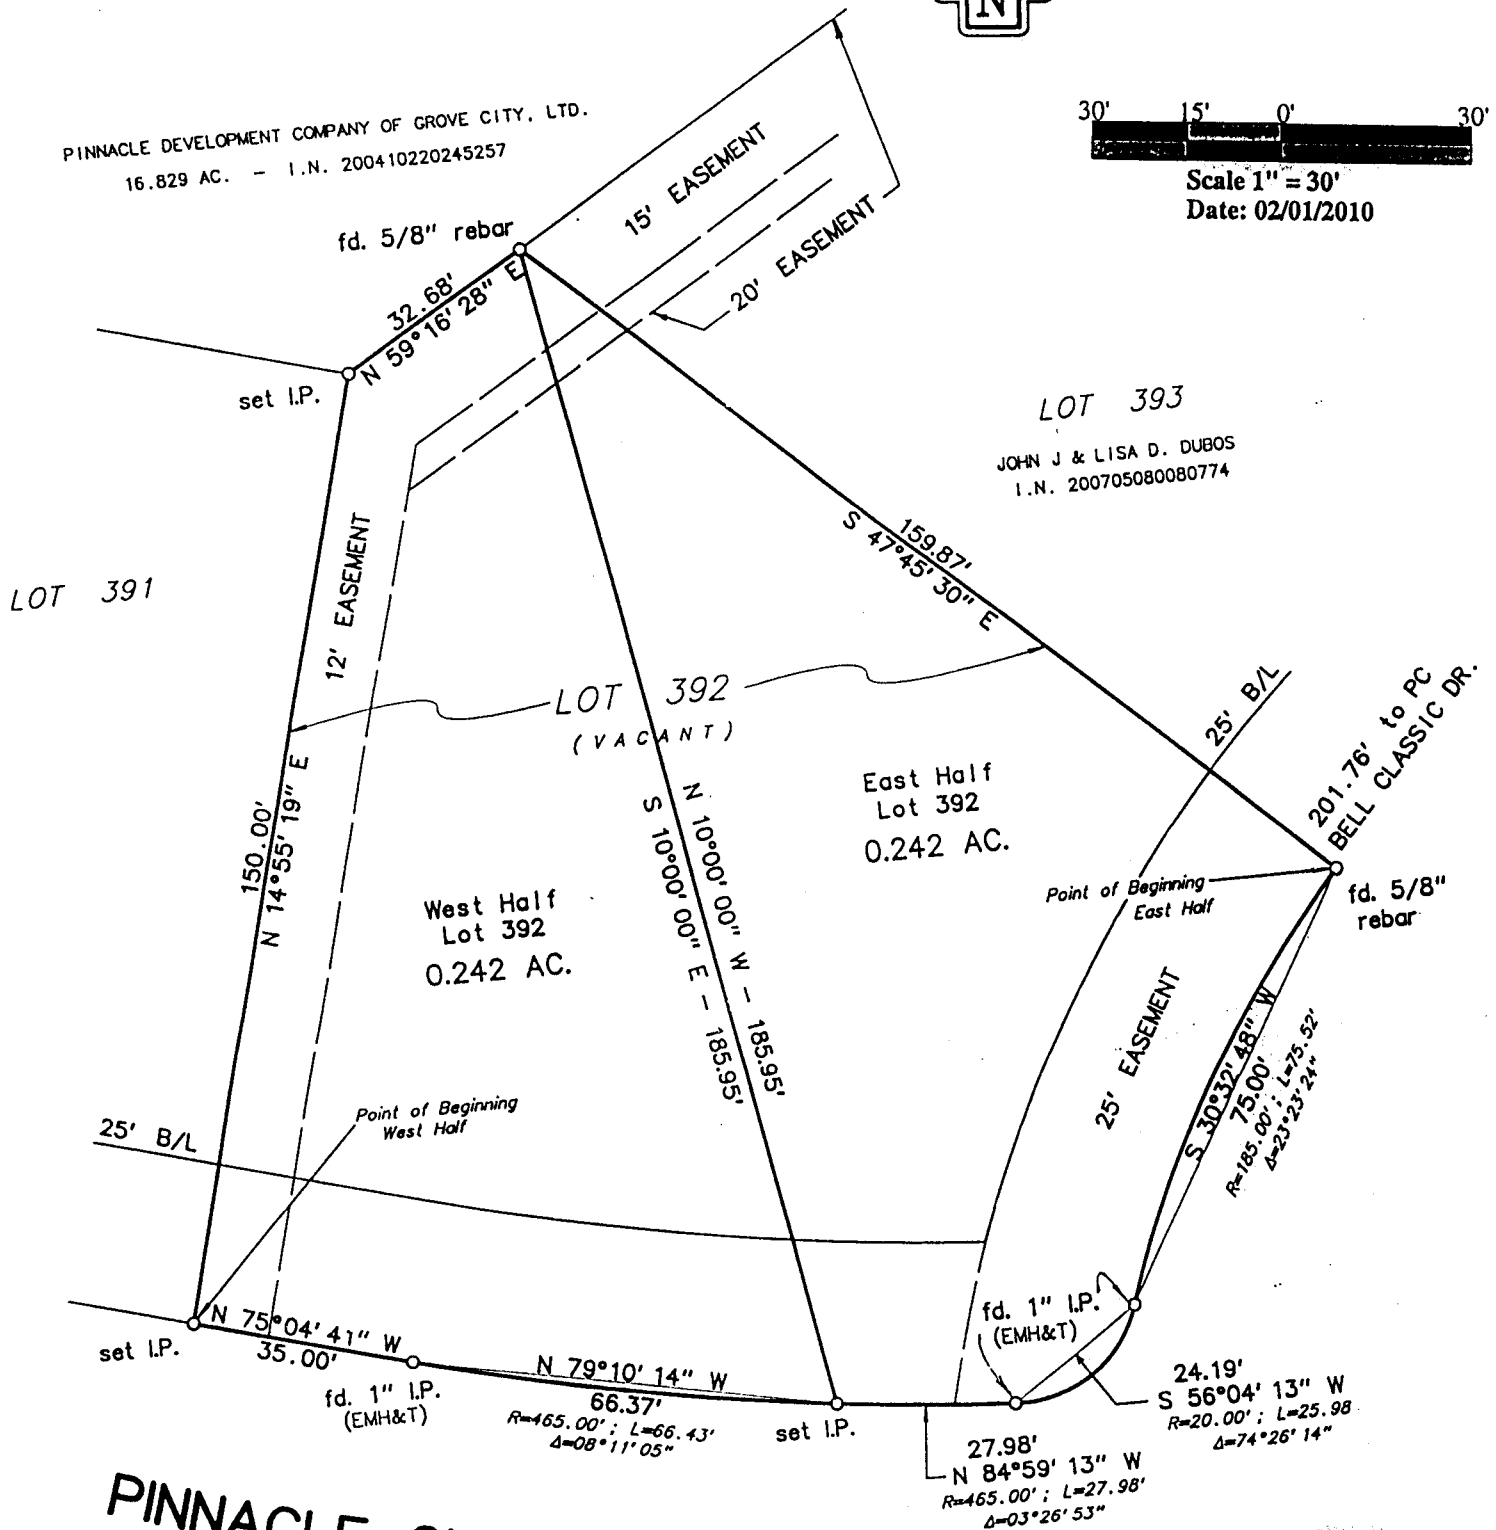

PINNACLE CLUB DRIVE 70' (P.B. 104, P. 99)

RECEIVED

FEB 05 2010

Franklin County Engineer
Dean C. Ringle, P.E., P.S.

We hereby certify that the foregoing Boundary Survey was prepared from actual field measurements in accordance with Chapter 4733-37 Ohio Administrative Code. Iron pipes set are 30"x1" O.D. with a plastic plug inscribed "P.S. 6579". Basis of bearings is the centerline of Pinnacle Club Drive as North 75 deg. 04' 41" West, as per P.B. 109, Pg. 26.


Myers Surveying Co., Inc.

By *[Signature]*

2-1-2010

Professional Surveyor

Myers Order No. - 2-C1/28/2010

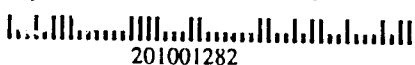

Rec.

Field

DWG

Ltr.

Ck.

MDF

MDF