EXHIBIT C 6-3-A

Myers Surveying Company, Inc.

2740 East Main Street, Columbus 43209 (Bexley), Ohio
614-235-8677 FAX:614-235-4559

A Boundary Survey prepared for and certified to:

Egan-Ryan Funeral Services

Legal Description: Situated in The State of Ohio, County of Franklin, City of Columbus Being Lots 14 and 15 Samuel Medary's Subdivision, Deed Book 38, Page 534.

Applicant: n/a

Posted Address: 406 & 410 Oak Street, Columbus, Ohio

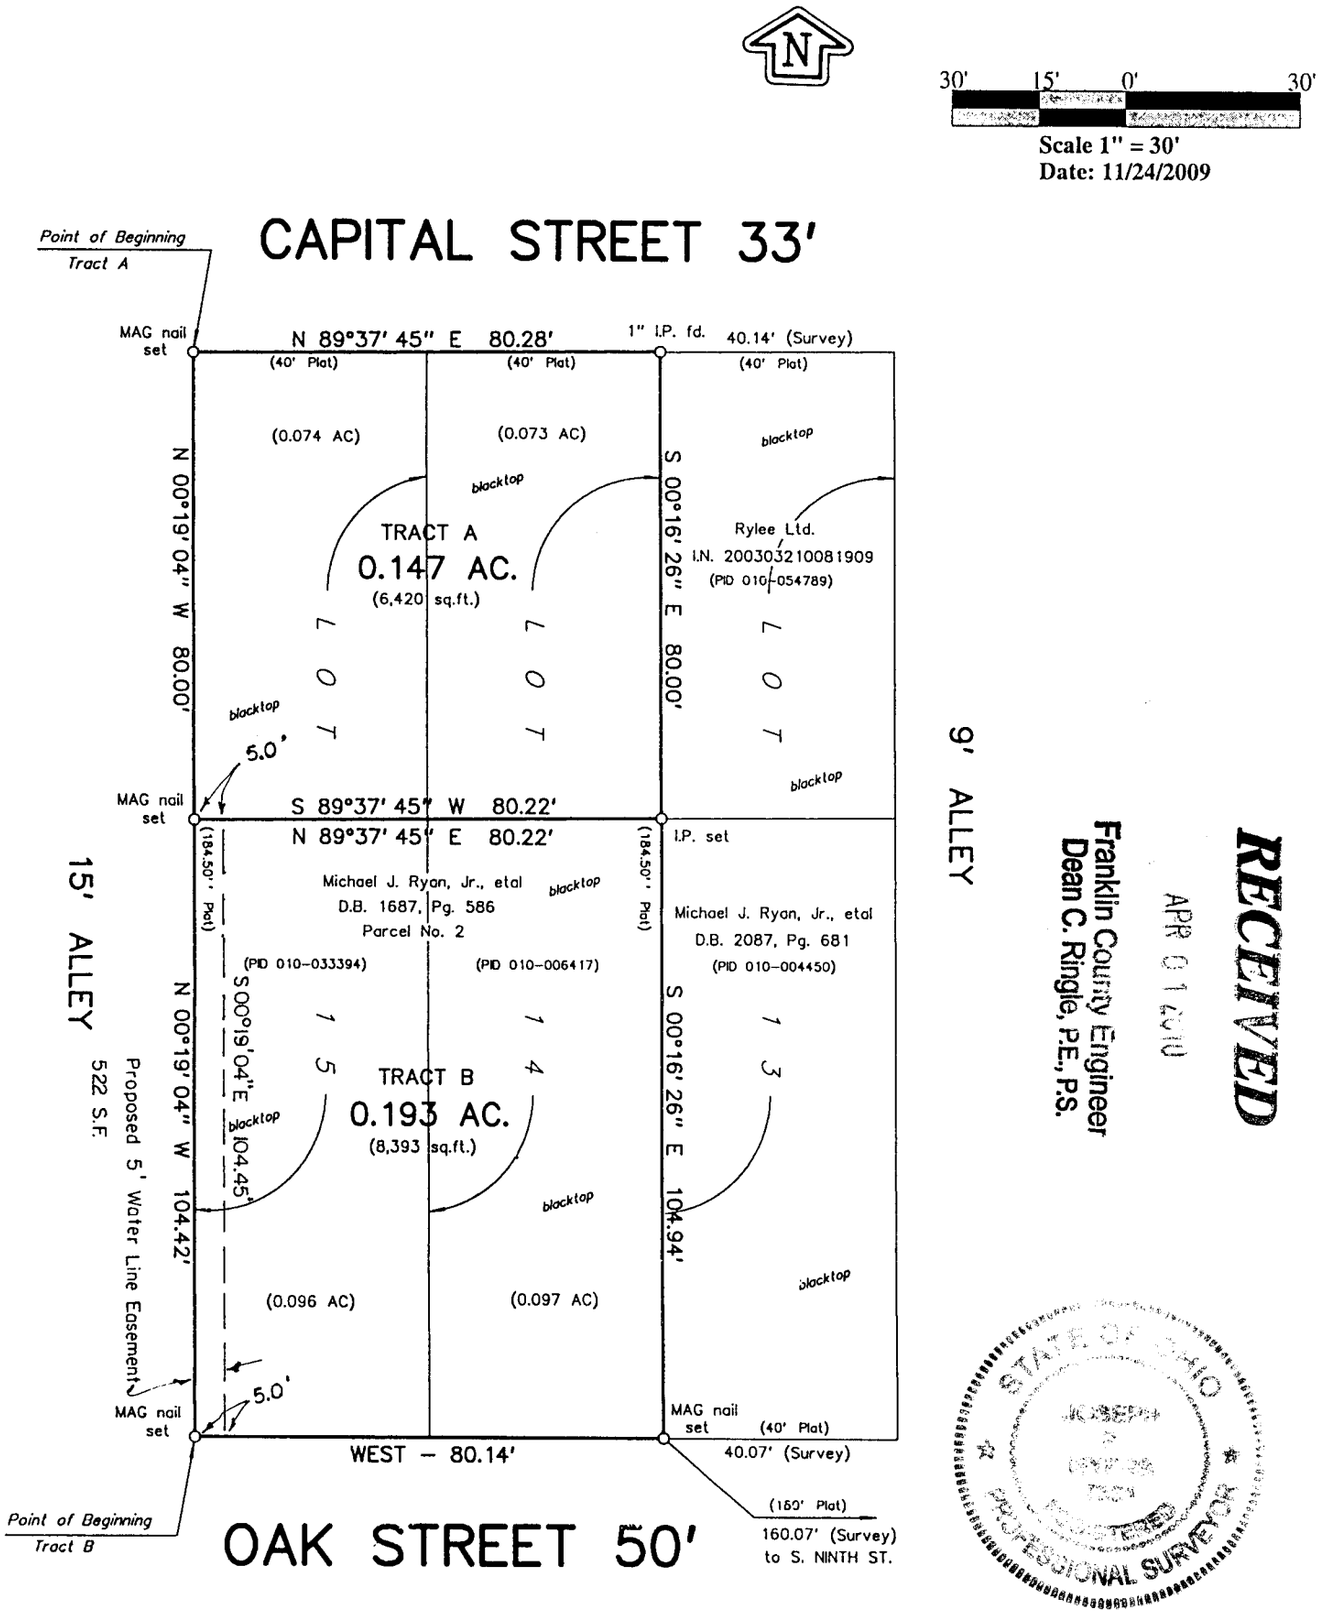

RECEIVED
APR 01 2010
Franklin County Engineer
Dean C. Ringle, P.E., P.S.

We hereby certify that the foregoing Boundary Survey was prepared from actual field measurements in accordance with Chapter 4733-37 Ohio Administrative Code. Iron pipes set are 30"x1" O.D. with an orange plastic plug inscribed "P.S. 6579", unless otherwise noted. Bearings are based on the north line of Oak Street held as WEST.

Myers Surveying Co., Inc.

By _____
2-17-2010 (add easement)
Professional Surveyor

Myers Order No. - 2-11/23/2009	Rec.	Field RD	DWG	Ltr.	Ck.
200911232					