F-9-A

REVISIONS:			
No.	Date	Description	By

Situated in the State of Ohio, County of Franklin, City of Columbus, being part of Lots 3, 4, 5 and 6 of Sara A. & C. Shoemaker's Addition (P.B. 3, PG. 234), all of Lots 1, 2, 3 and 4 of Carrie M. & J.M. Tibbett's Fairview Subdivision (P.B. 4, PG. 118), and part of a 20' Alley vacated by City of Columbus Ordinance #455-32.

For:

A & E GLASS and ALUMINUM, Inc.

November 17, 2009

80' 60' 40' 20' 0' 40' 80'

Scale 1" = 40'

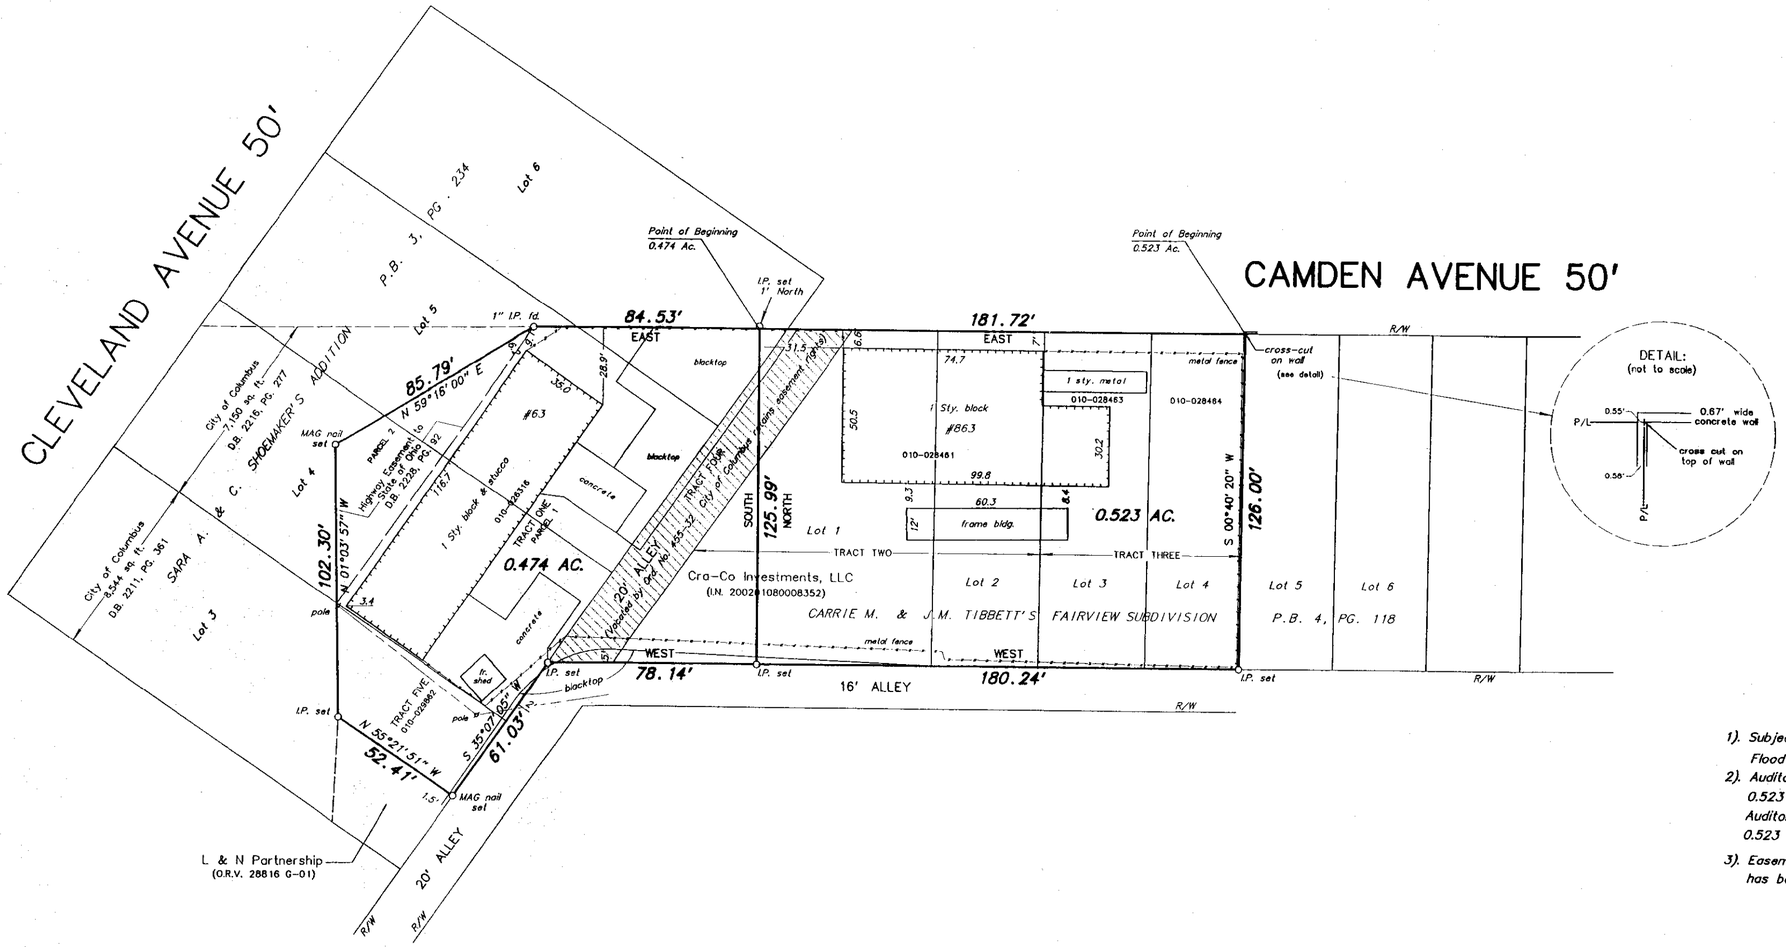

We hereby certify that the foregoing Boundary Survey was prepared from actual field measurements in accordance with Chapter 4733-37 Ohio Administrative Code. Iron pipes set are 30" X 1" (O.D.) with a plastic cap inscribed "P.S. 6579", unless otherwise noted. Bearings are based on the south line of Camden Road held as EAST.

BY _____ 4-26-10

Albert J. Myers, Professional Surveyor No. 6579.

REGISTERED PROFESSIONAL SURVEYOR

RECEIVED

APR 26 2010

Franklin County Engineer
Dean C. Ringle, P.E., P.S.

Notes:

1). *Subject tract is in Flood Zone "X" as per F.E.M.A. Flood Insuarnce Rate Map 390170 0326 K.*
2). *Auditor's Parcel 010-028461 has 0.287 acres in the 0.523 acre tract, and 0.047 acre in the 0.474 acre tract. Auditor's Parcel 010-026316 has 0.020 acres in the 0.523 acre tract, and 0.376 acre in the 0.474 acre tract.*
3). *Easements may affect subject tract, no title commitment has been proveded to the undersigned.*

MyersSurveying COMPANY

2740 East Main Street (614) 235 - 8677
Bexley, Ohio 43209-2577 info@myerssurveying.com

mo#3-11/03/09		X-3334	T-3521

3251

3251