


Situated in the State of Ohio, County of Franklin, Township of Brown, and being in Virginia Military Survey No. 2606, and being a 6.002 acre tract, and a 7.543 acre tract entirely out of a 13.546 acre tract of land being the remainder of an original 26.671 acre tract belonging to Florence M. Krull of record in Instrument No. 200208220207697, at the Franklin County Recorders Office, Franklin County Ohio.

Basis of Bearing used upon the attached Plat being, S 56° 38' 43" W, the centerline of Morris Road and recorded in Instrument No. 200208220207697.

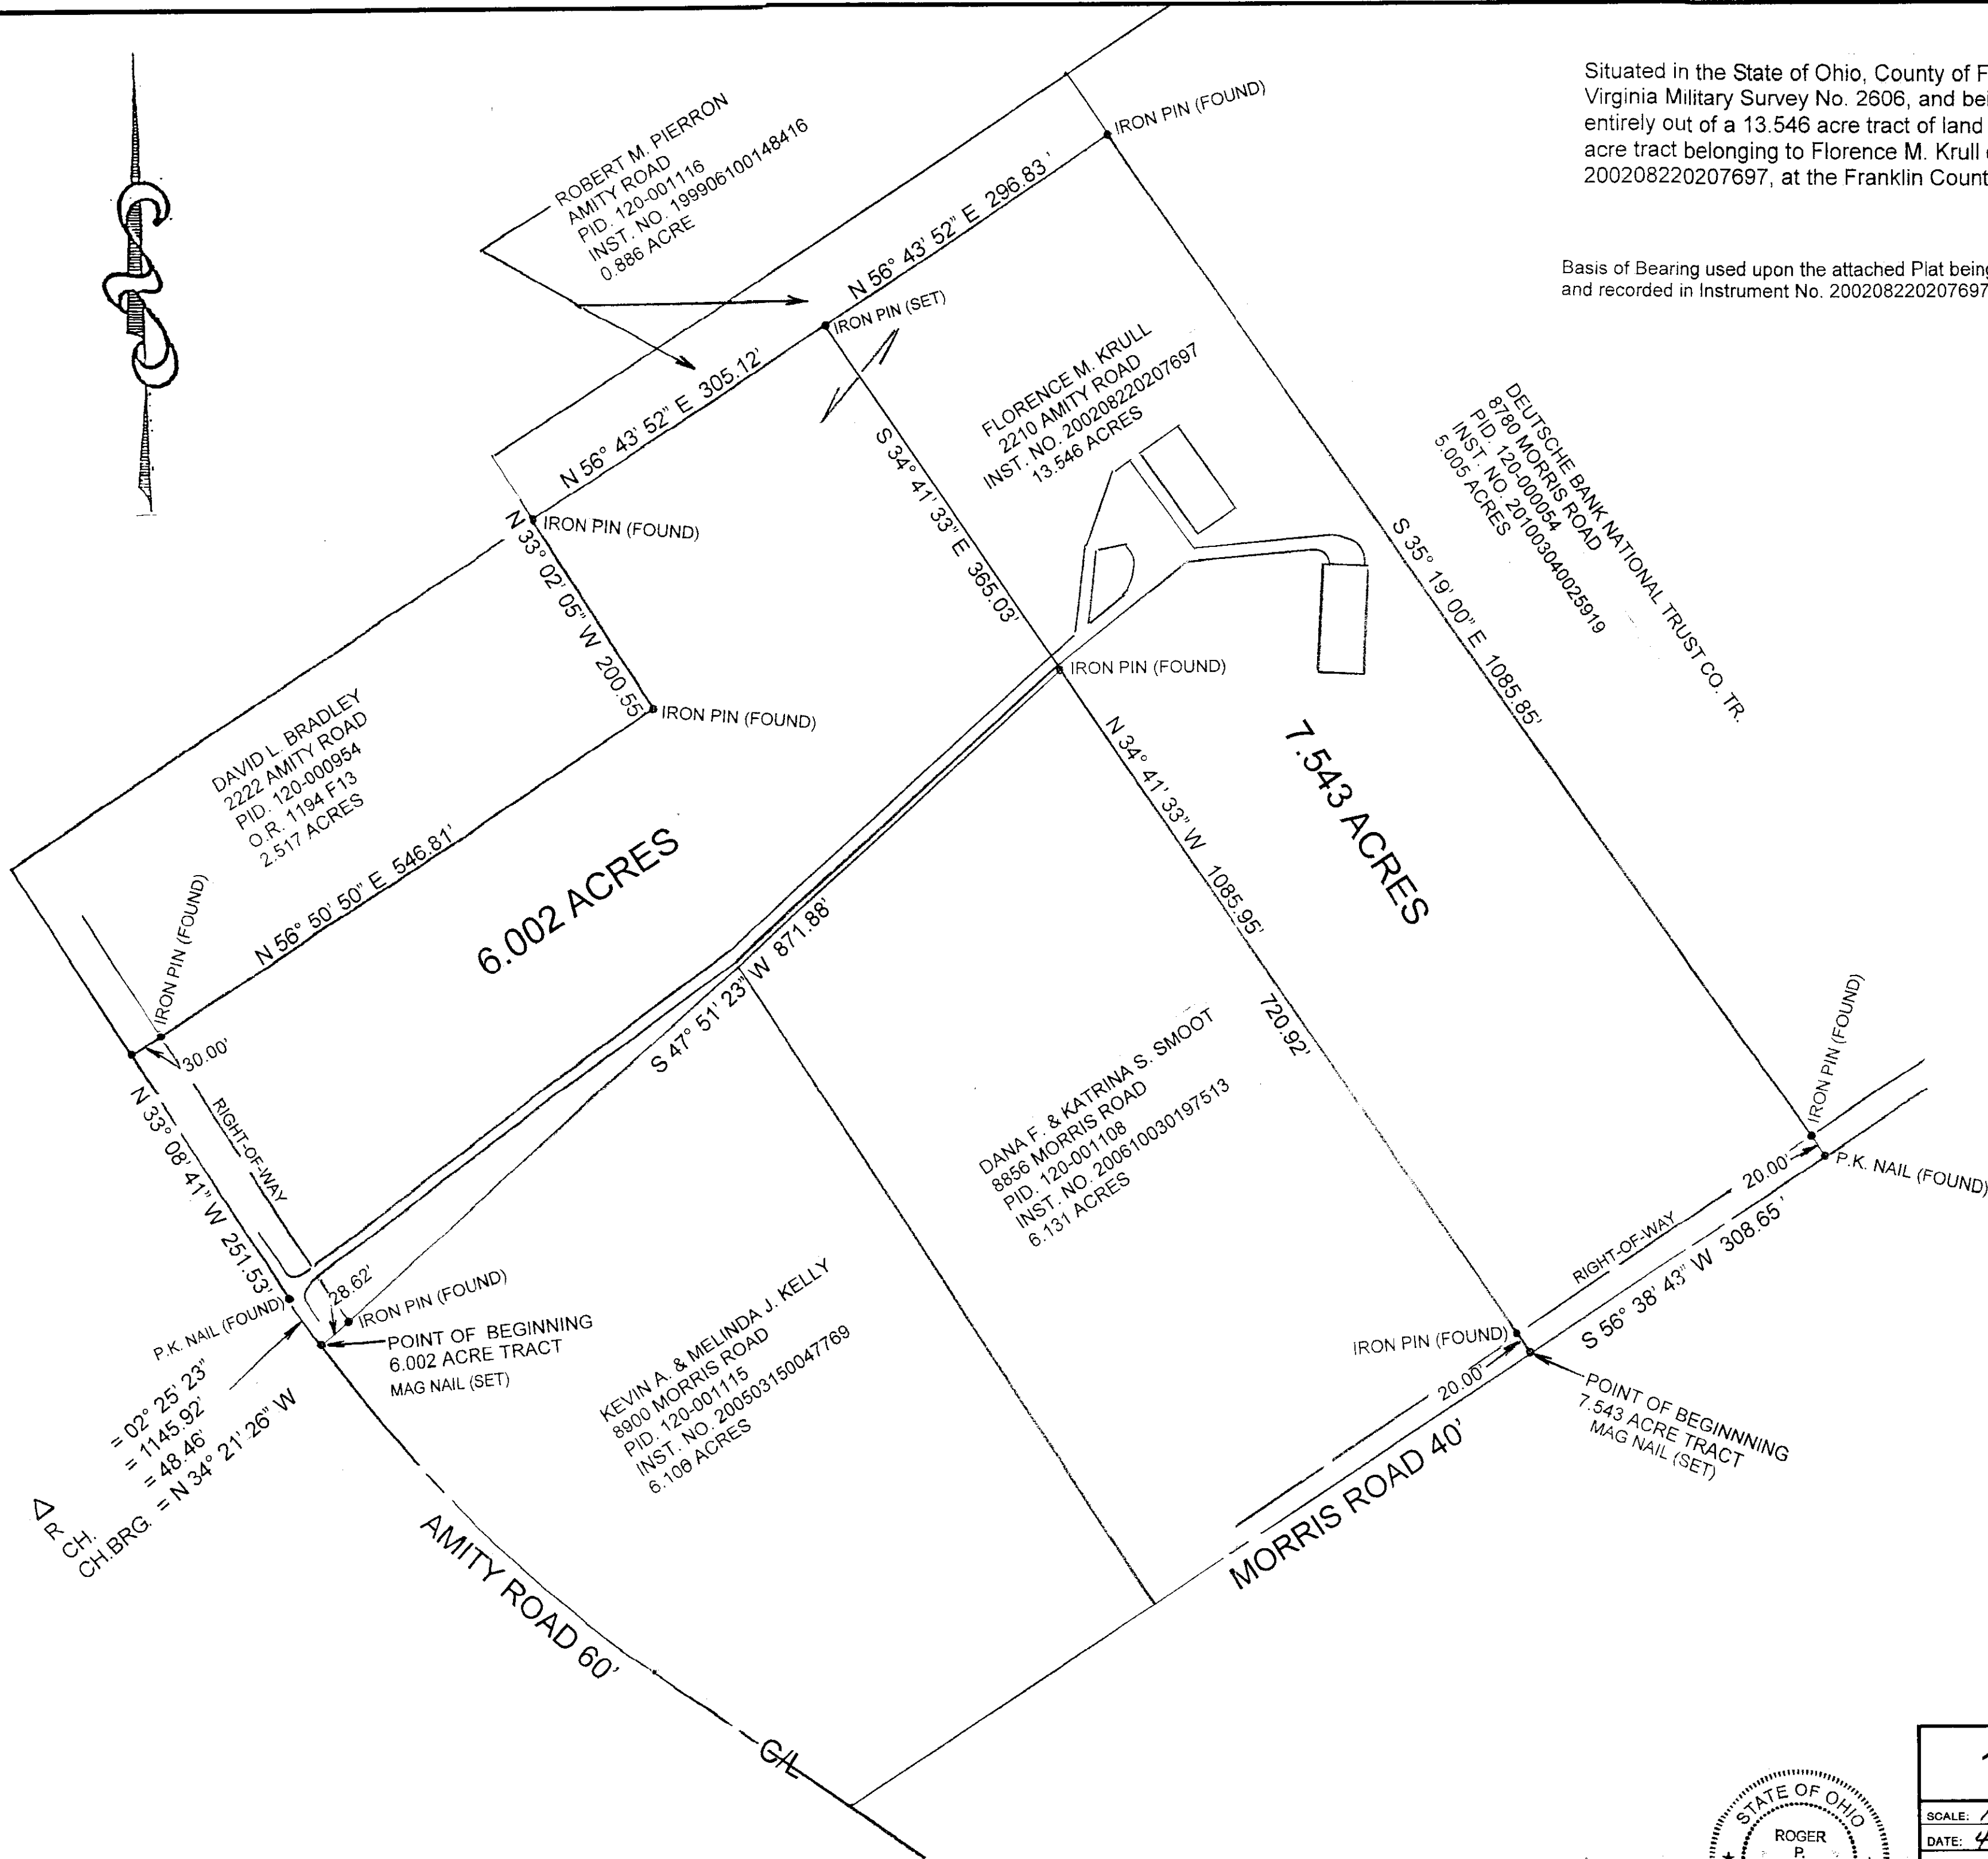


RECEIVED

Professional Engineer
Dean C. Pugh, A.E., P.S.

ARNOLD SURVEY COMPANY
3911 BROADWAY STREET, GROVE CITY, OHIO 43123
TELEPHONE (614) 875-7684 FAX: (614) 875-9017

NOTE: IRON PINS SET ARE 30" X 1" O.D. WITH YELLOW PLASTIC CAPS INSCRIBED 6065.

PROFESSIONAL SURVEYOR NO. 6065

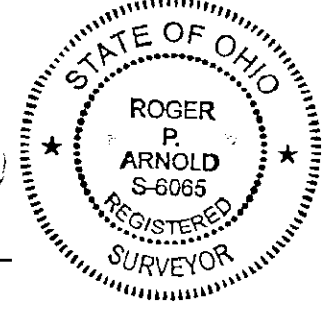

13.546 ACRE LOT SPLIT		
SCALE: 1" = 100'	APPROVED BY	DRAWN BY
DATE: 4-9-2010		R.P. ARNOLD
TOWNSHIP OF BROWN		
FRANKLIN COUNTY, OHIO		DRAWING NUMBER
		1041