

Myers Surveying Company, Inc.

2740 East Main Street, Columbus 43209 (Bexley), Ohio

614-235-8677

FAX:614-235-4559

A Boundary Survey prepared for and certified to:

Edith Waugh


Legal Description: Situated in The State of Ohio, County of Franklin, City of Columbus Being Lot 125 Opportunity Farms, Plat Book 15, Page 28

Posted Address: 2774 Fairwood Avenue, Columbus, Ohio

RECEIVED

JUN 14 2010


Franklin County Engineer
Dean C. Ringle, P.E., P.S.

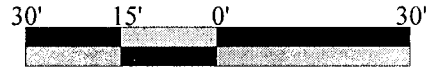

Scale 1" = 30'

Date: 04/15/2010

16' ALLEY (UNIMPROVED)

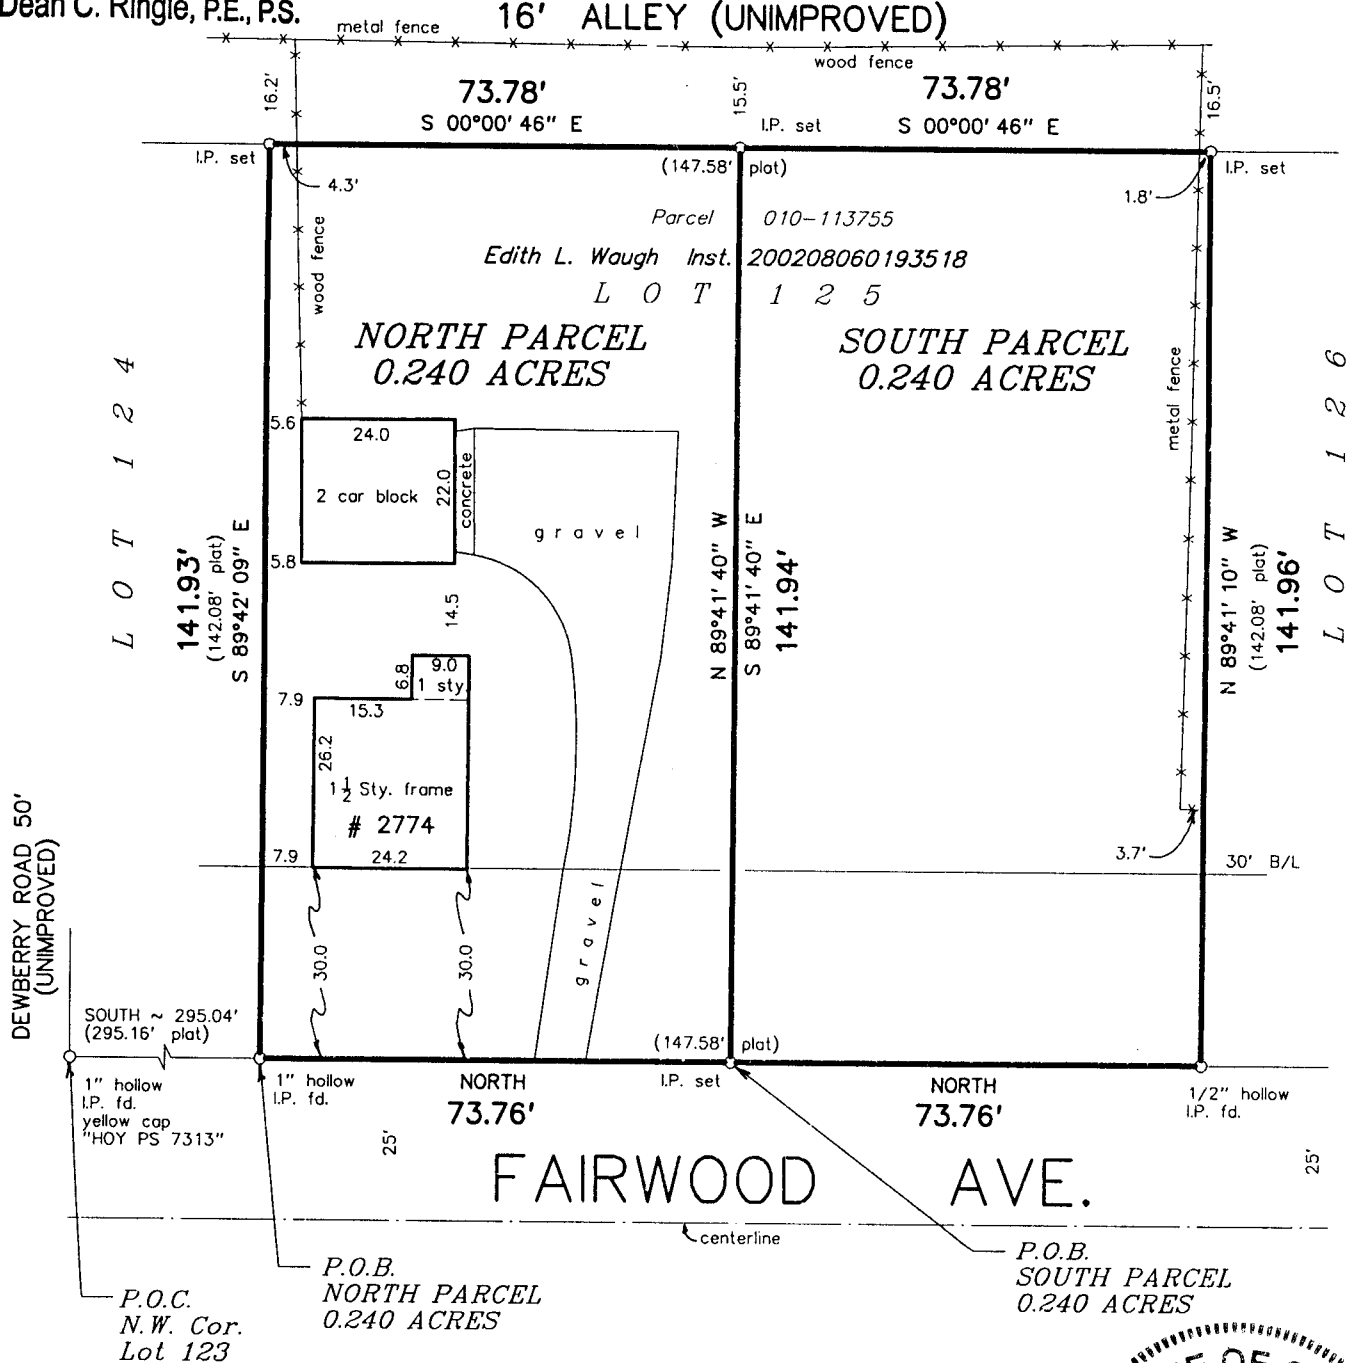

We hereby certify that the foregoing Boundary Survey was prepared from actual field measurements in accordance with Chapter 4733-37 Ohio Administrative Code. Iron pipes set are 30"x1" O.D. with an orange plastic plug inscribed "P.S. 6579", unless otherwise noted. Basis of bearings is the East R/W line of Fairwood Avenue held as NORTH as per Plat Book 15, Page 28.

By *Albert J. Myers*
Professional Surveyor

Myers Order No. - 12-04/06/2010



Rec. Field DWG Ltr. Ck.