

BAUER, DAVIDSON & MERCHANT, INC.


CONSULTING ENGINEERS

255 GREEN MEADOWS DRIVE SOUTH LEWIS CENTER, OHIO 43035

PHONE: 614-846-3393

FAX: 614-846-4575

BOUNDARY SURVEY MAP OF 0.670 ACRE AND 0.689 ACRE TRACTS OF LAND LOCATED ON THE WEST SIDE OF LINWORTH ROAD AND SOUTH OF SNOUFFER ROAD, IN THE CITY OF WORTHINGTON, COUNTY OF FRANKLIN, STATE OF OHIO

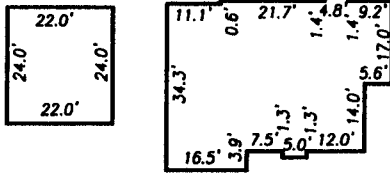


HOUSE/BLDG DETAIL
(Not to Scale)

GRAPHIC SCALE



(IN FEET)

1 inch = 60 ft.

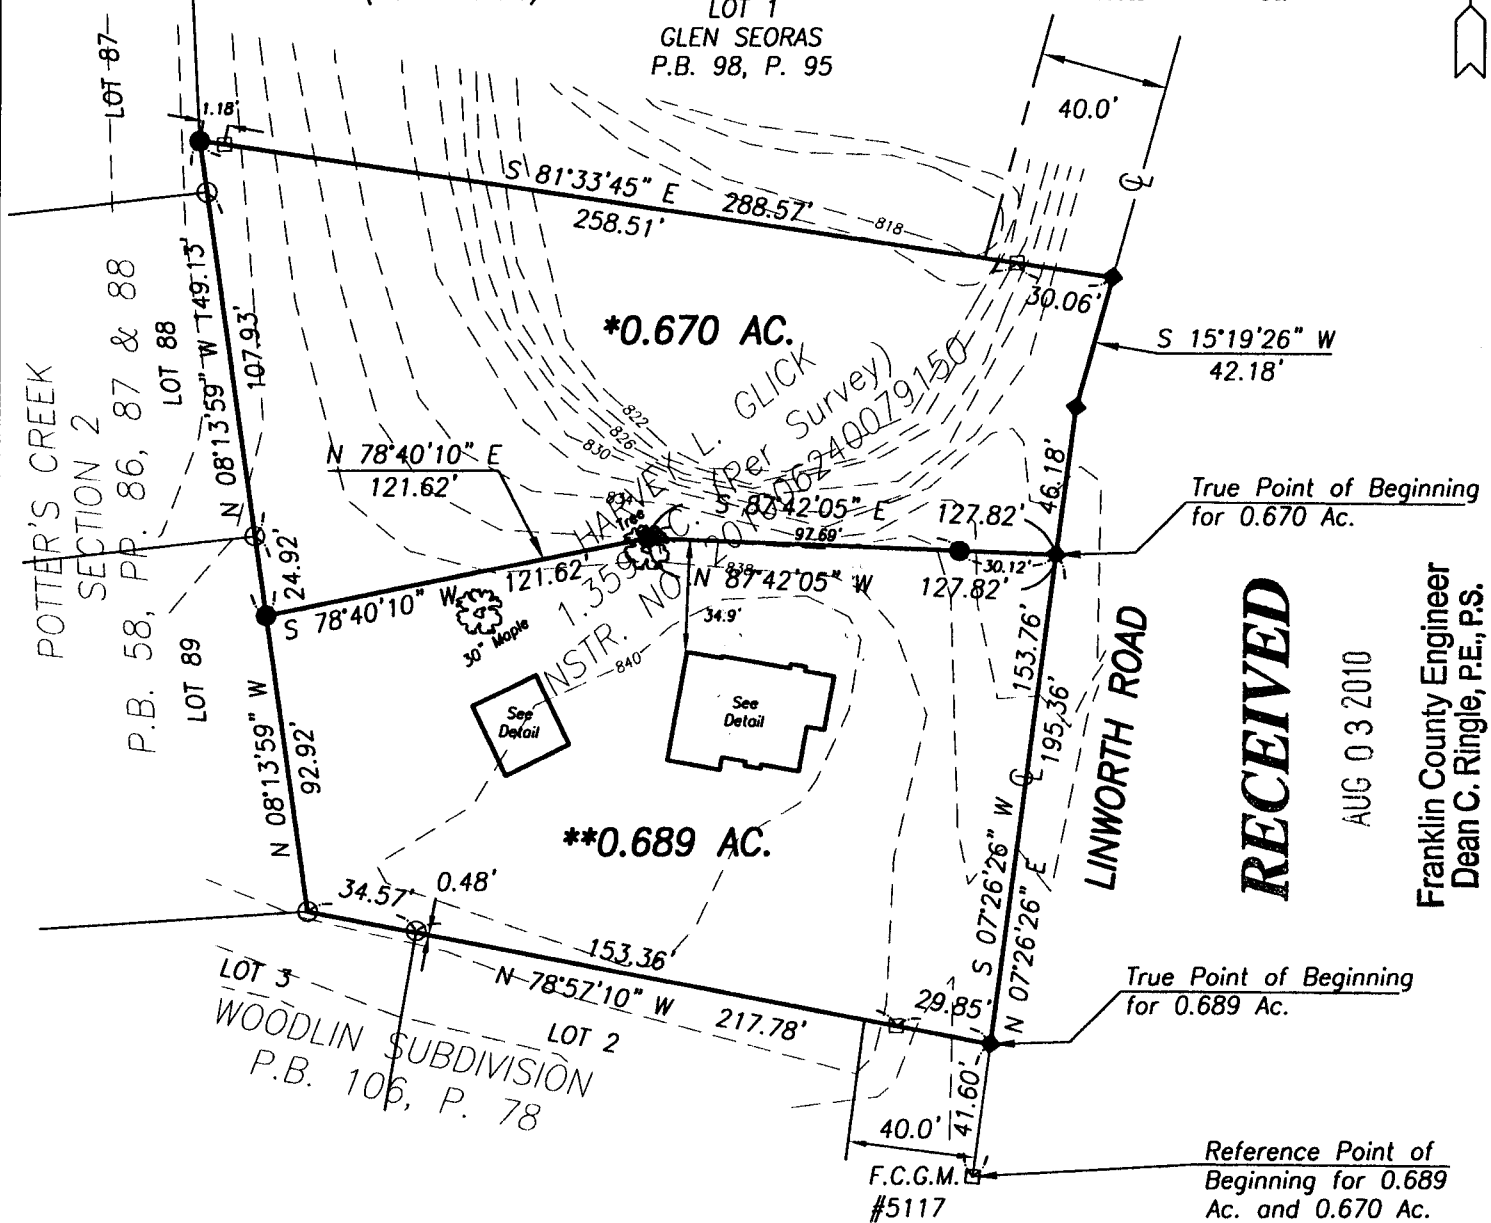

RECEIVED

AUG 03 2010

Franklin County Engineer
Dean C. Ringle, P.E., P.S.

*Sited in the State of Ohio, County of Franklin, City of Worthington, being in Section 4, Township 2, Range 19, United States Military Lands and being a 0.670 acre area of land, more or less, said 0.670 acre being a part of that tract of land (1.359 acres of land according to a survey conducted by Bauer, Davidson & Merchant, Inc.) described in Exhibit A in the deed to Harvey L. Glick, of record in Instrument No. 201006240079150, Recorder's Office, Franklin County, Ohio.

**Sited in the State of Ohio, County of Franklin, City of Worthington, being in Section 4, Township 2, Range 19, United States Military Lands and being a 0.689 acre area of land, more or less, said 0.689 acre being a part of that tract of land (1.359 acres of land according to a survey conducted by Bauer, Davidson & Merchant, Inc.) described in Exhibit A in the deed to Harvey L. Glick, of record in Instrument No. 201006240079150, Recorder's Office, Franklin County, Ohio.

We hereby state that the above map was prepared from information obtained from an actual field survey conducted by Bauer, Davidson & Merchant, Inc. in July of 2010.

The bearings shown on this map are based on the bearing of N 07°26'26" E as shown for the centerline of Linworth Road on the recorded plat of Woodlin Subdivision, of record in Plat Book 106, Page 78, Recorder's Office, Franklin County, Ohio.

LEGEND

- IPF = 3/4" iron pipe found
- IPS = 3/4" iron pipe set, 30" inches in length with a plastic cap in top marked "B.D.M. #5"
- ◆ PKF = Concrete nail Set
- PTF = Pinch Top iron pipe found

SCALE: 1"=60'
JULY 27, 2010
ORDER NO. 586-10

