



PLAT OF MONUMENTED PROPERTY LINE  
 Located In  
 Virginia Military Survey Nos. 1472, 2601 & 7281  
 Pleasant Township, Franklin County, Ohio

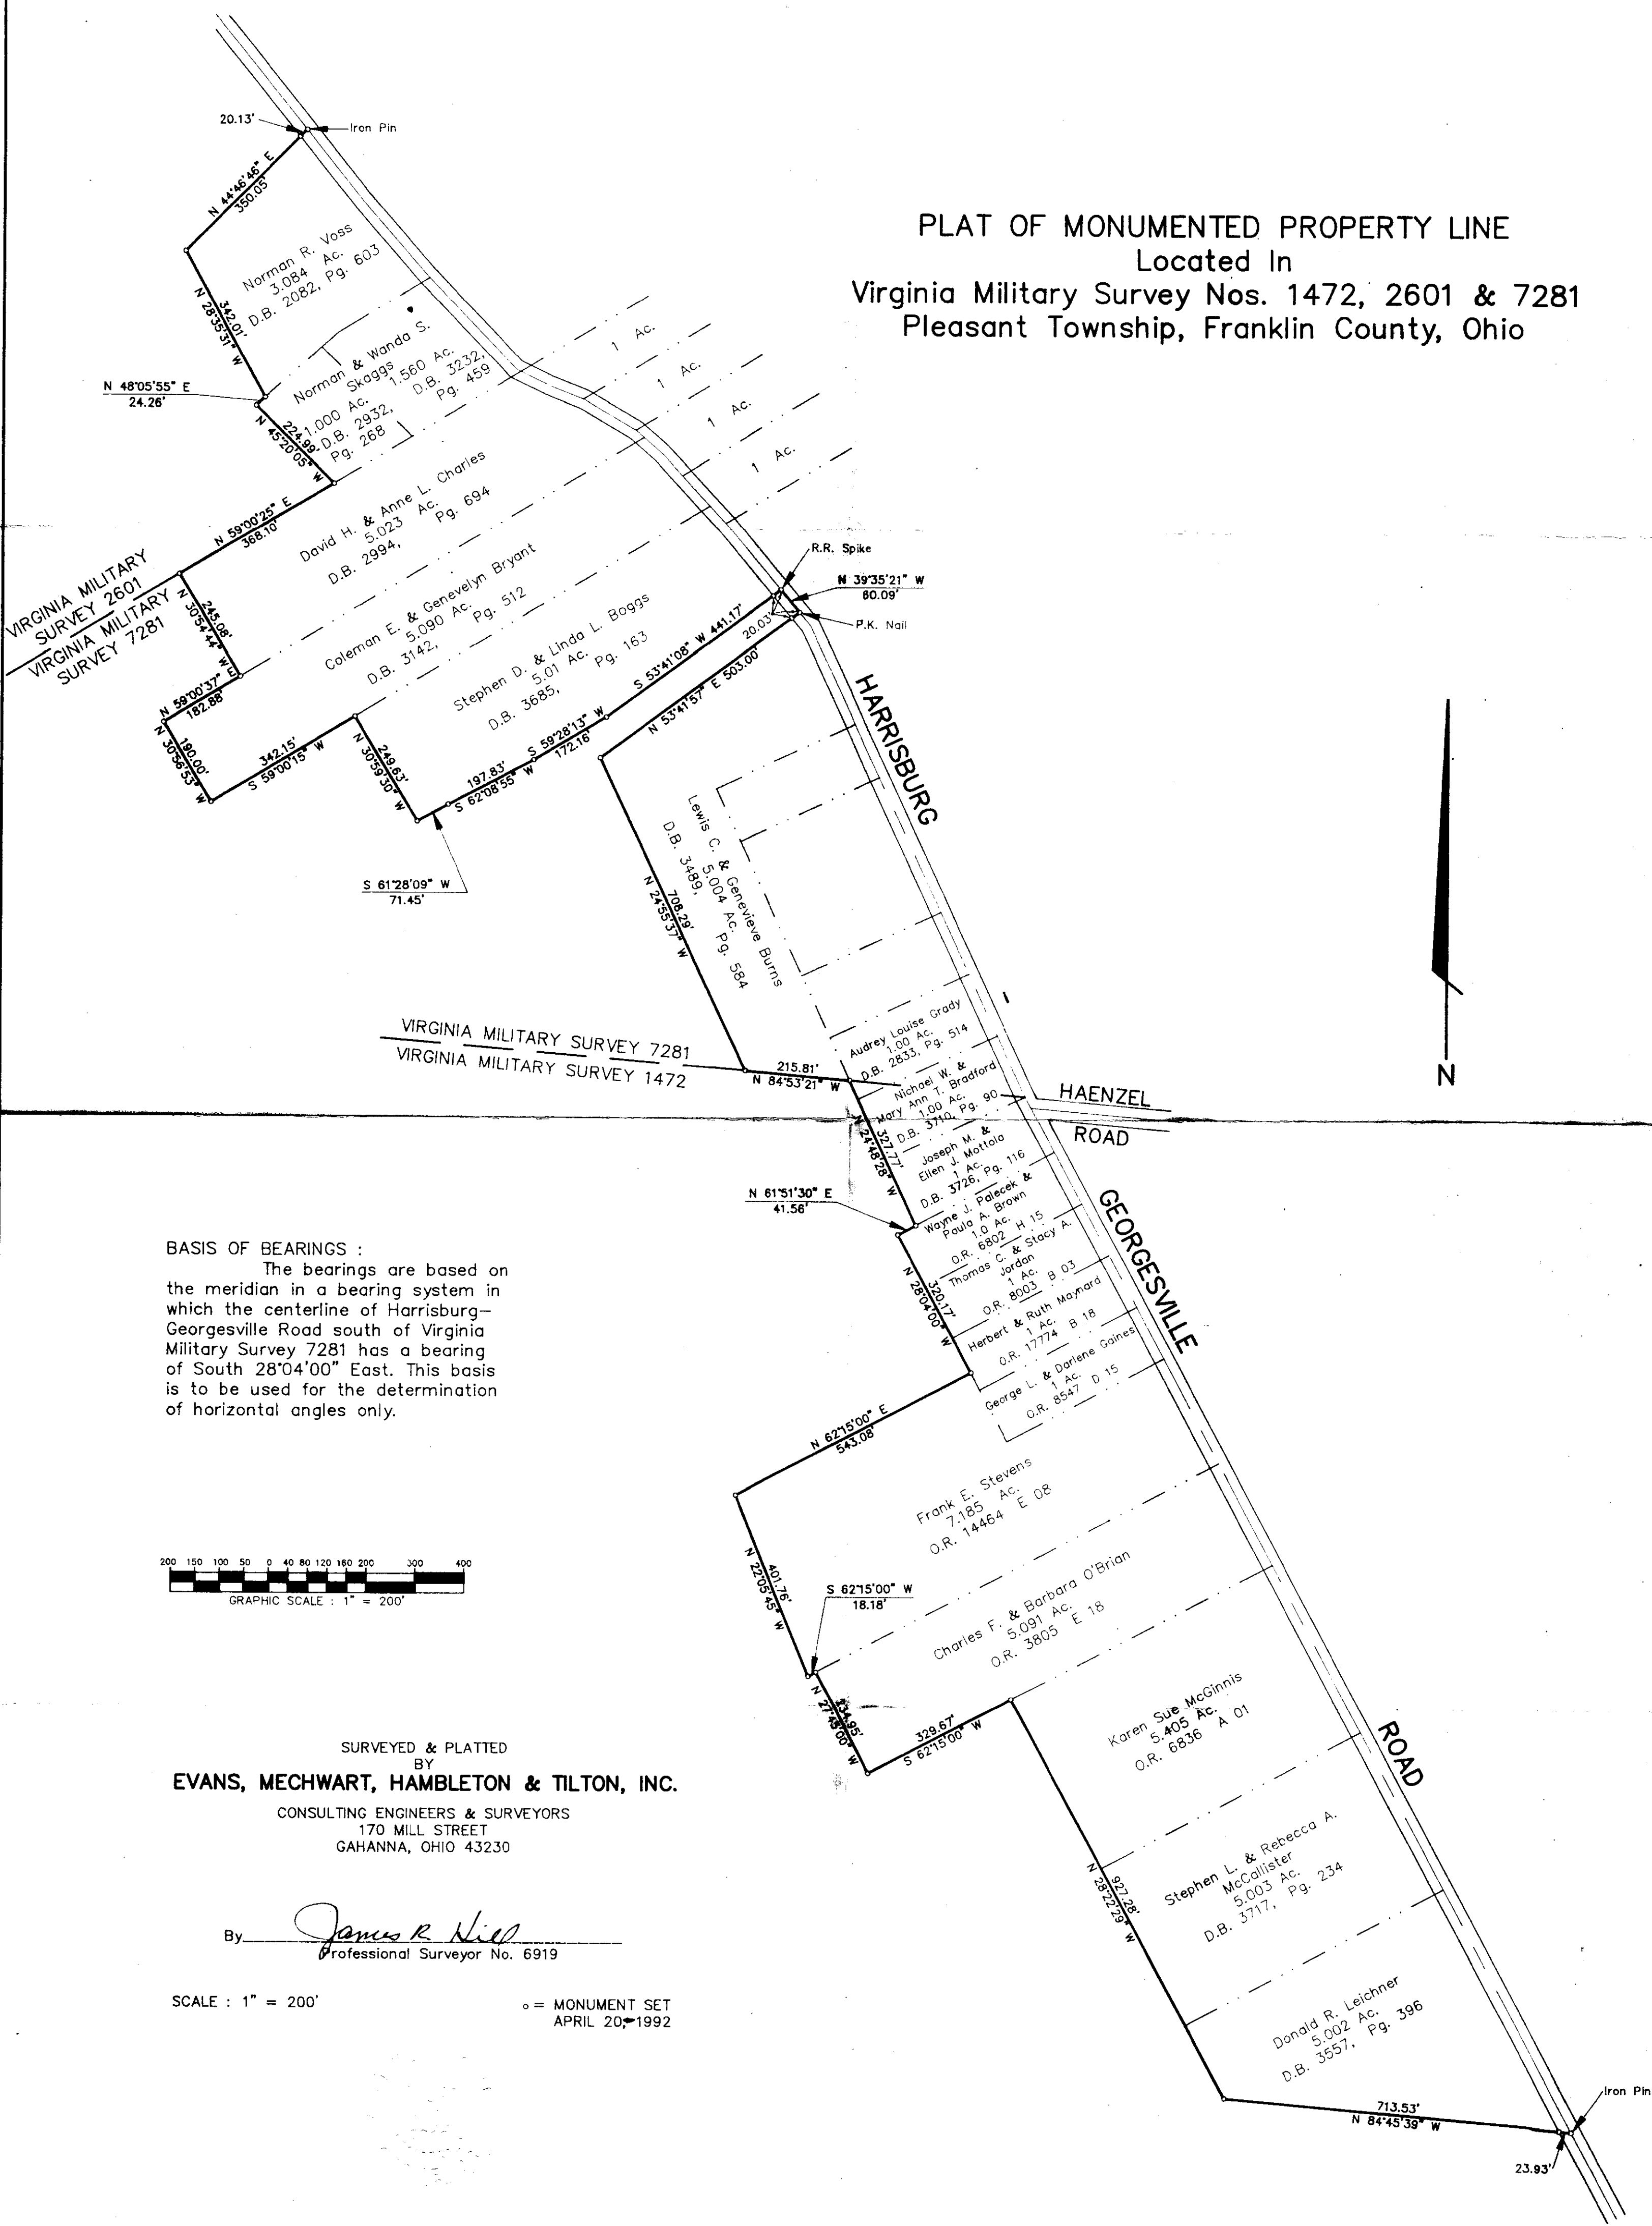

BASIS OF BEARINGS :

The bearings are based on the meridian in a bearing system in which the centerline of Harrisburg-Georgesville Road south of Virginia Military Survey 7281 has a bearing of South 28°04'00" East. This basis is to be used for the determination of horizontal angles only.

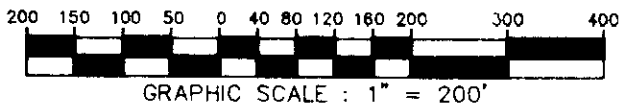

SURVEYED & PLATTED  
 BY  
**EVANS, MECHWART, HAMBLETON & TILTON, INC.**

CONSULTING ENGINEERS & SURVEYORS  
 170 MILL STREET  
 GAHANNA, OHIO 43230

By James R. Hill  
 Professional Surveyor No. 6919

SCALE : 1" = 200'

o = MONUMENT SET  
 APRIL 20, 1992

