

# HARRY L. GREENE, ENGINEERING & SURVEYING


2122 Tremont Center, Columbus, OH. 43221

PLAT OF SURVEY FOR TOM STEWART:

BEING LOT NO. 343, INDIANOLA HIGHLANDS, AS SHOWN OF RECORD IN PLAT BOOK 9, PAGE 32, RECORDER'S OFFICE  
CITY OF COLUMBUS, FRANKLIN COUNTY, OHIO.

SCALE, 1"=20'

May 31, 1994

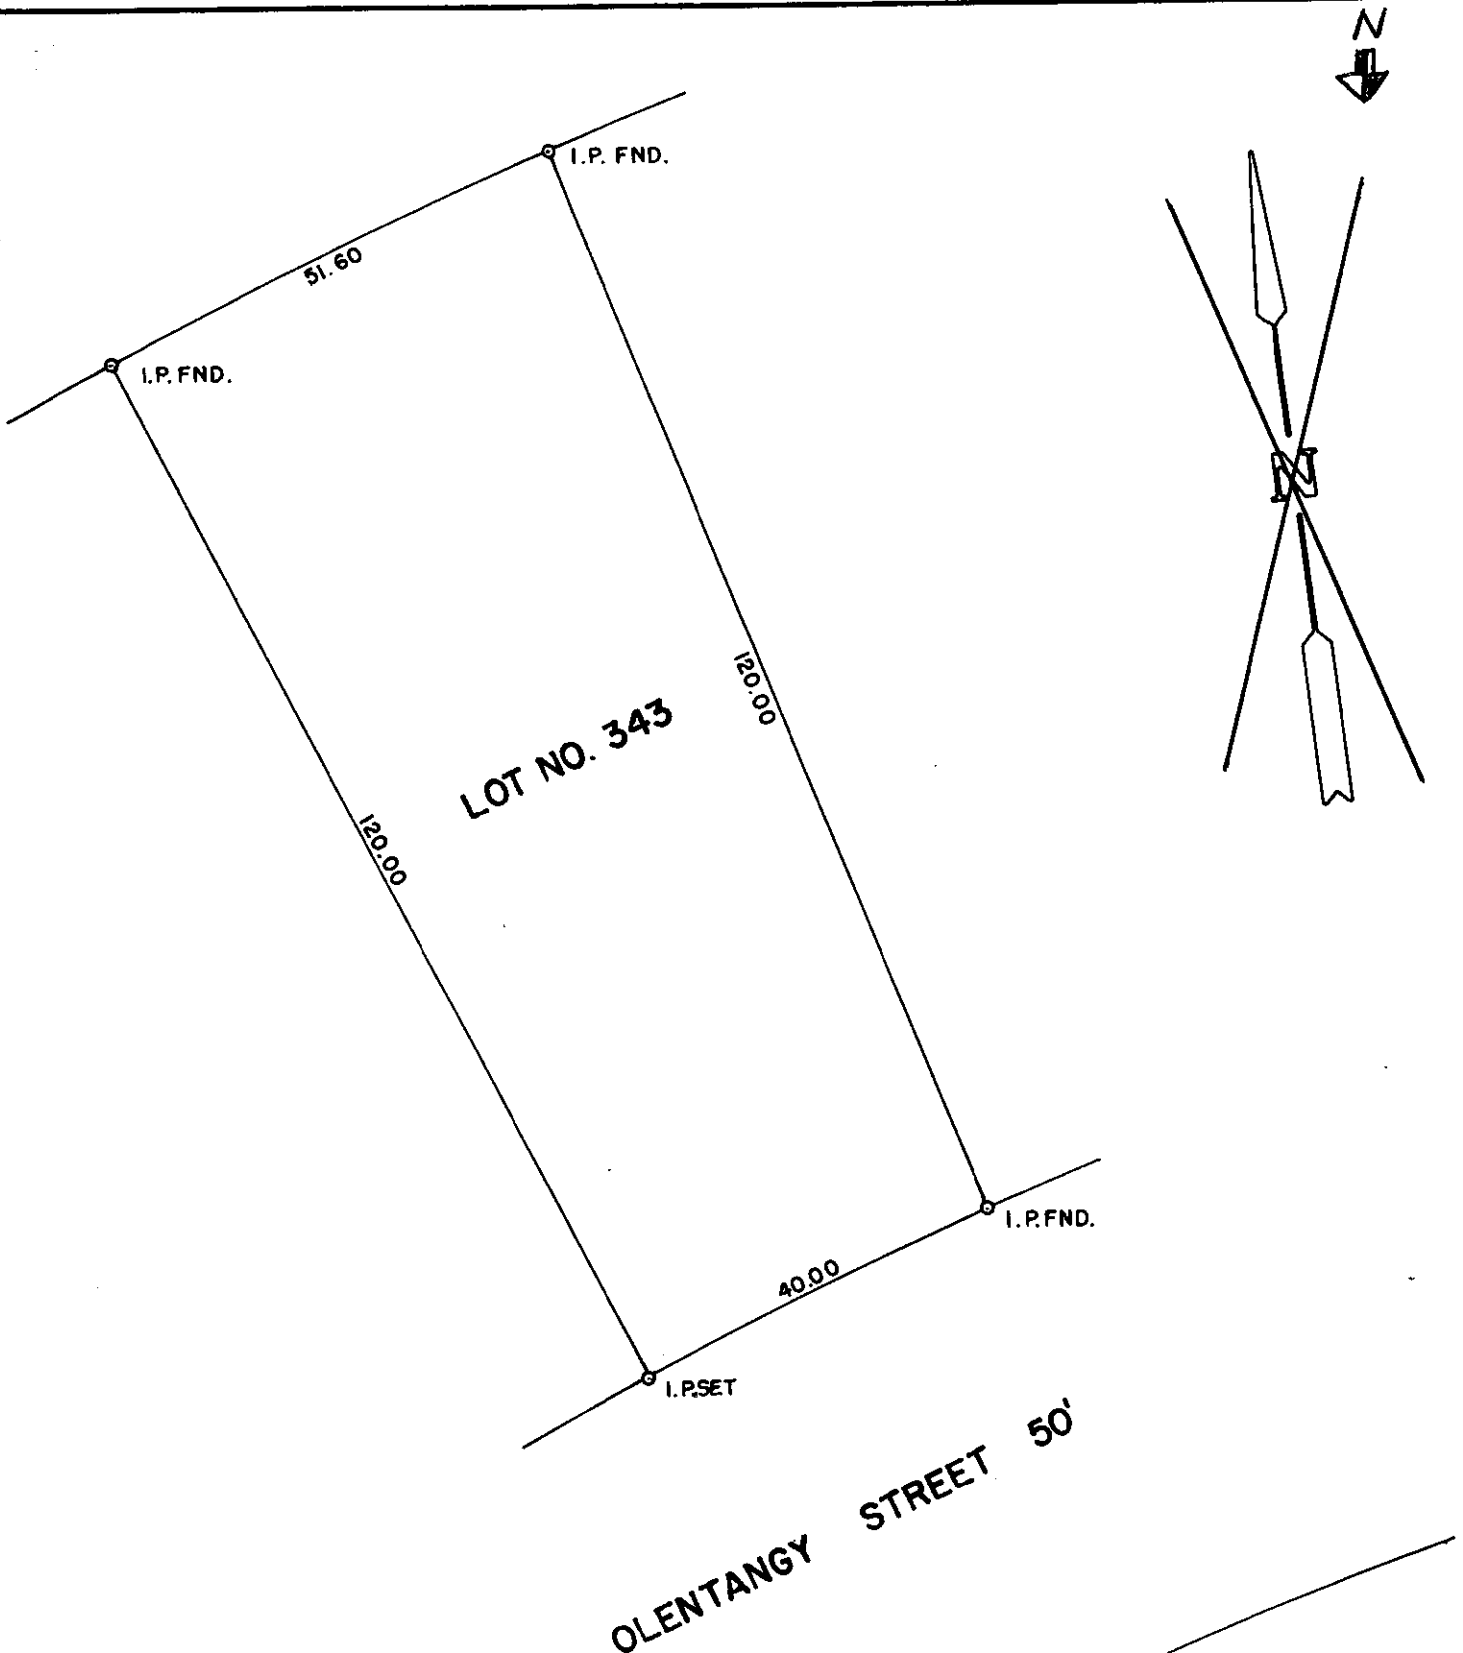

THIS PLAT WAS PREPARED BY HARRY L. GREENE,  
ENGINEERING AND SURVEYING, AND IS A TRUE AND  
ACCURATE REPRESENTATION, TO THE BEST OF MY  
KNOWLEDGE AND BELIEF, OF A SURVEY MADE BY SAME  
IN MAY 1994.

*William E. Chaffin*

WILLIAM E. CHAFFIN,  
REG. SURVEYOR, NO. 7559