


Harry L. Greene, ENGINEERS & SURVEYORS
2160 Tremont Center, Columbus, Ohio 43221


PLAT OF SURVEY
BEING LOT 241, CROSS CREEK VILLAGE, SECTION NO.3,
PLAT BOOK 70, PAGE 33, CITY OF COLUMBUS, FRANKLIN COUNTY, OHIO

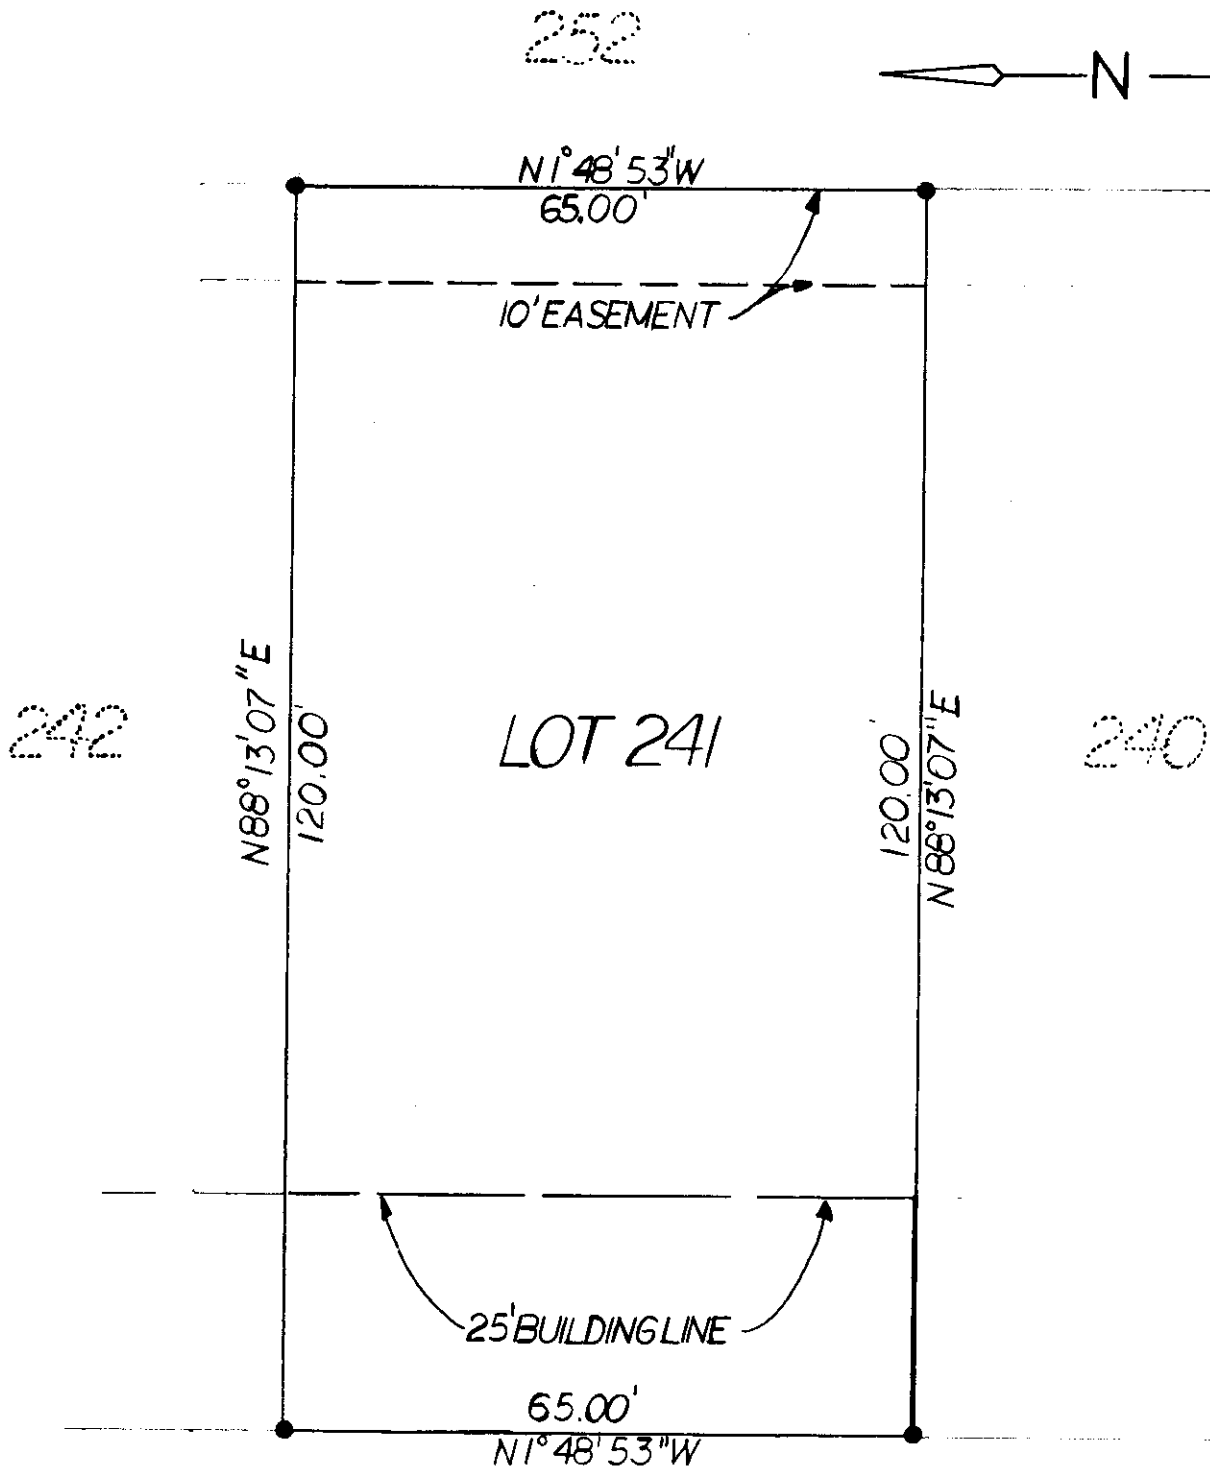

LEGEND

● IRON PIN SET
SCALE 1"=20'

BADGER DRIVE ~ 50'

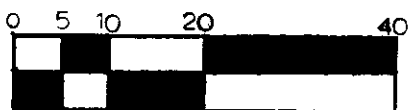

SEPT. 30, 1992

Charles A. Rolfe

Registered Surveyor, No.