31-96

PLAT OF SURVEY

FOR
DONALD SCHLEGEL
3554 ROCHFORT BRIDGE DRIVE
LOT 197
THE GLEN # 3
P.B. 52, PG. 25
COLUMBUS, OHIO

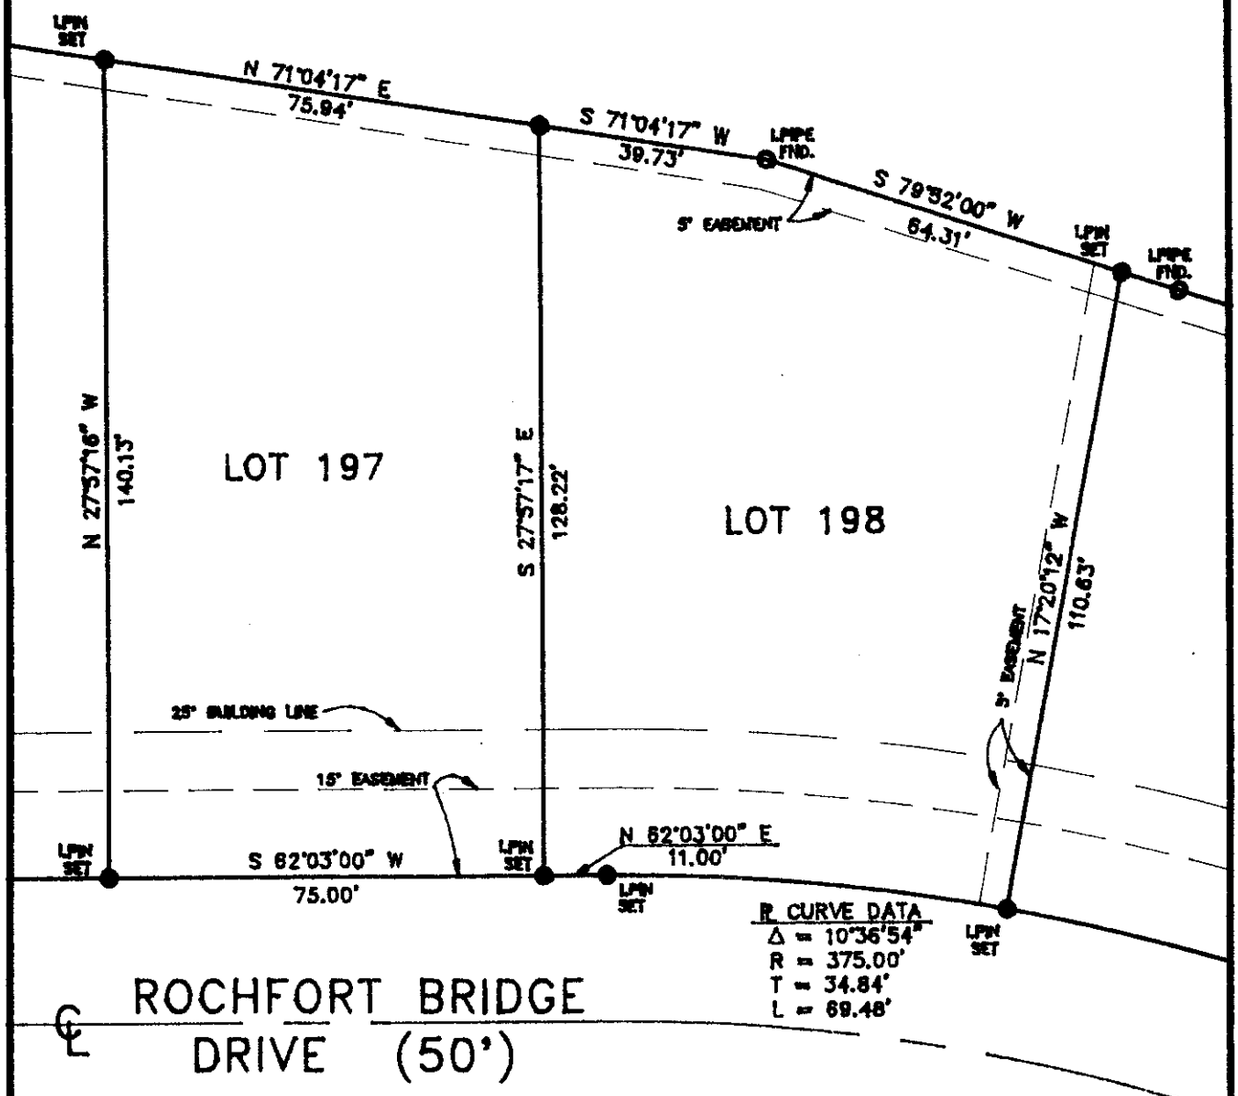

THIS PLAT WAS PREPARED BY HARRY L. GREENE, ENGINEERING AND SURVEYING, AND IS A TRUE AND ACCURATE REPRESENTATION, TO THE BEST OF MY KNOWLEDGE AND BELIEF, OF A SURVEY MADE BY SAME IN APRIL 1996.

1 inch = 30 ft.

William Edward Chaffin

WILLIAM EDWARD CHAFFIN
REGISTERED SURVEYOR NO. 7559

STATE OF OHIO
WILLIAM EDWARD CHAFFIN
7559
REGISTERED
SURVEYOR

DRAWN BY R. CHAFFIN	DATE APRIL 15, 1996
CHECKED BY W. CHAFFIN	DRAWING NO. 31-96.DWG
JOB NO. 31-96	SHEET 1 OF 1

— PLAN PREPARED BY —

HARRY L. GREENE, ENGINEERING AND SURVEYING

2122 TREMONT CENTER
COLUMBUS, OHIO 43221
(614) 486-0714