

**PLAT OF SURVEY  
FOR  
CARROLL W. HUFF, TRUSTEE**

1143 WALNUT STREET  
1.738 ACRE TRACT  
O.R. 32873 G-11  
SECT. 1, TWP. 2, RNG. 17  
UNITED STATES MILITARY LANDS  
CITY OF WESTERVILLE  
COUNTY OF FRANKLIN  
STATE OF OHIO


**GRAPHIC SCALE**




( IN FEET )  
1 inch = 60 ft.

BASIS OF BEARINGS IS THE CENTERLINE OF WALNUT STREET  
BEING S 54°35'00" E AS RECORDED IN OFFICIAL RECORD 32873  
G-11, RECORDER'S OFFICE, FRANKLIN COUNTY, OHIO.

THIS PLAT WAS PREPARED BY HLG ENGINEERING AND SURVEYING, INC.,  
AND IS A TRUE AND ACCURATE REPRESENTATION, TO THE BEST OF MY  
KNOWLEDGE AND BELIEF, OF A SURVEY MADE BY SAME IN JUNE 1998.

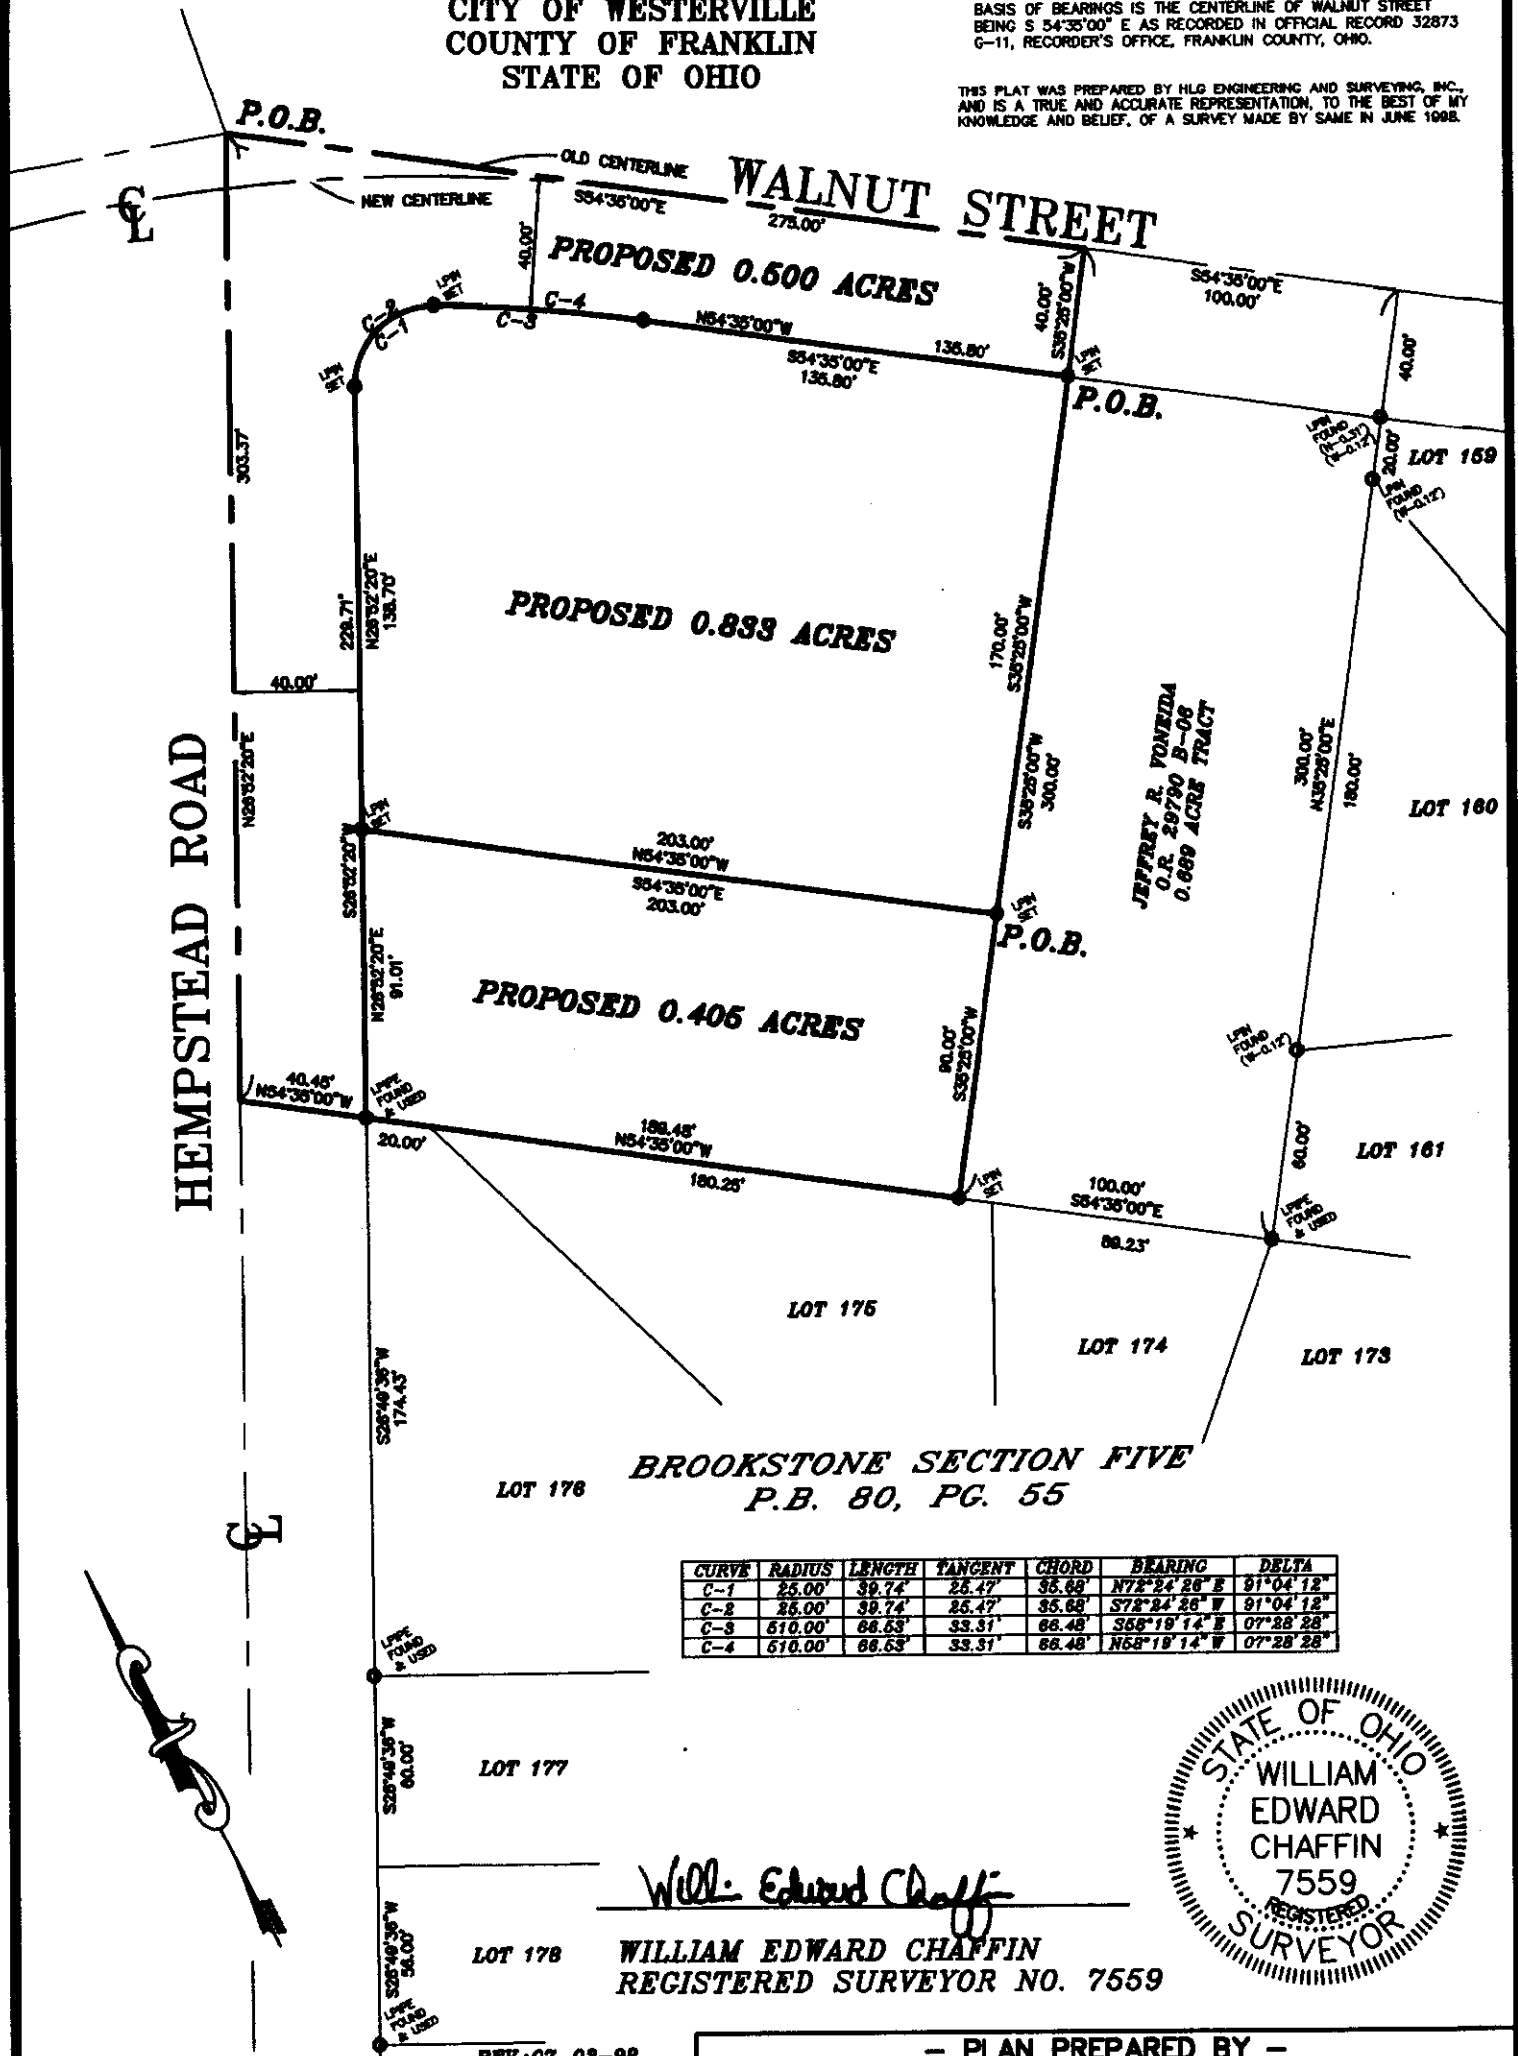

CURVE	RADIUS	LENGTH	TANGENT	CHORD	BEARING	DELTA
C-1	25.00'	39.74'	25.47'	35.68'	N72°24'26" E	91°04'12"
C-2	25.00'	39.74'	25.47'	35.68'	S72°24'26" W	91°04'12"
C-3	610.00'	66.63'	33.31'	66.48'	S58°19'14" E	07°28'28"
C-4	610.00'	66.63'	33.31'	66.48'	N58°19'14" W	07°28'28"

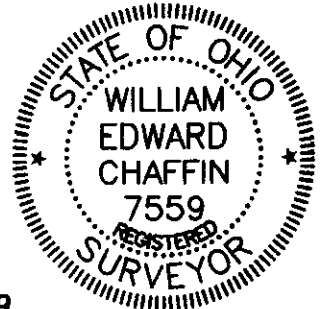

*William Edward Chaffin*  
**WILLIAM EDWARD CHAFFIN**  
REGISTERED SURVEYOR NO. 7559

REV.: 07-02-98		- PLAN PREPARED BY -	
DRAWN BY: R. CHAFFIN		<b>HLG ENGINEERING &amp; SURVEYING, INC.</b>	
DATE: 06/26/98	CHECKED BY: W. CHAFFIN	705-F LAKEVIEW PLAZA BLVD. WORTHINGTON, OHIO 43085 (614) 841-0053	
DRAWING NO.: 30307H	SHEET 1 of 1		