



Harry L. Greene

ENGINEERING & SURVEYING

2122 Tremont Center, Columbus, OH 43221

Property Owner: DENNIS VACOBOZZI Address: 992 ELLIFF DR.
City: WESTERVILLE County: FRANKLIN
Lot No.: 616 Subdivision: SPRING GROVE EXT.# 5 Block No.: _____
Plat Book: 55 Page: 53

Scale: 1"=20' Date: 10-19-93 Job No.: 124-10-93

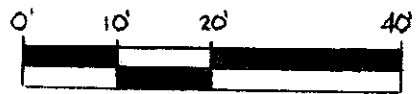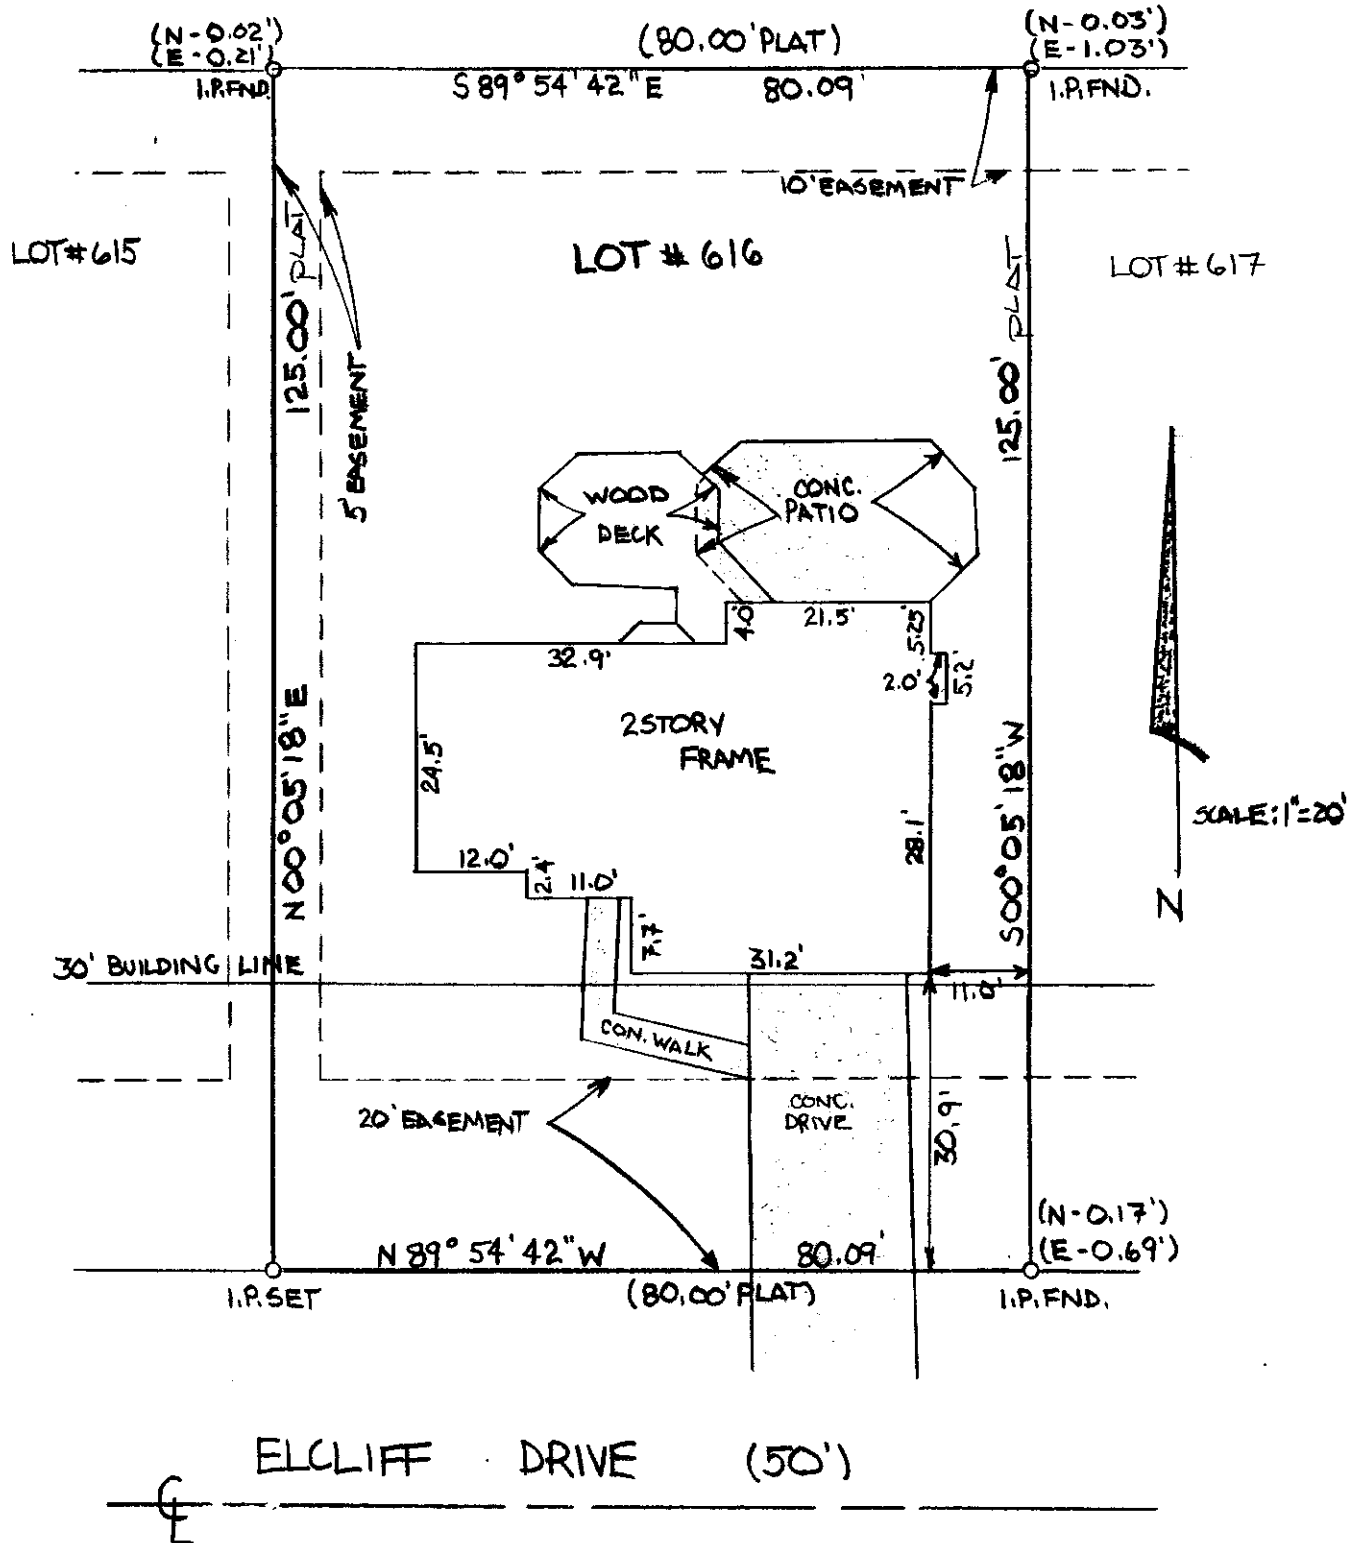

Don Galano
Registered Surveyor
No. 7169

I hereby certify the above plat has been prepared from an actual survey of the premises on Oct 15, 1993