


Harry L. Greene, ENGINEERS & SURVEYORS


2160 Tremont Center, Columbus, Ohio 43221

PLAT OF SURVEY, BEING LOT NUMBER 7, HASTINGS PLACE,
UPPER ARLINGTON, OHIO

PB. 34 Page 75 Recorders Office, Franklin County, Ohio.
Scale 1" = 30' Date November 4, 1992 Job No. 128-10-92

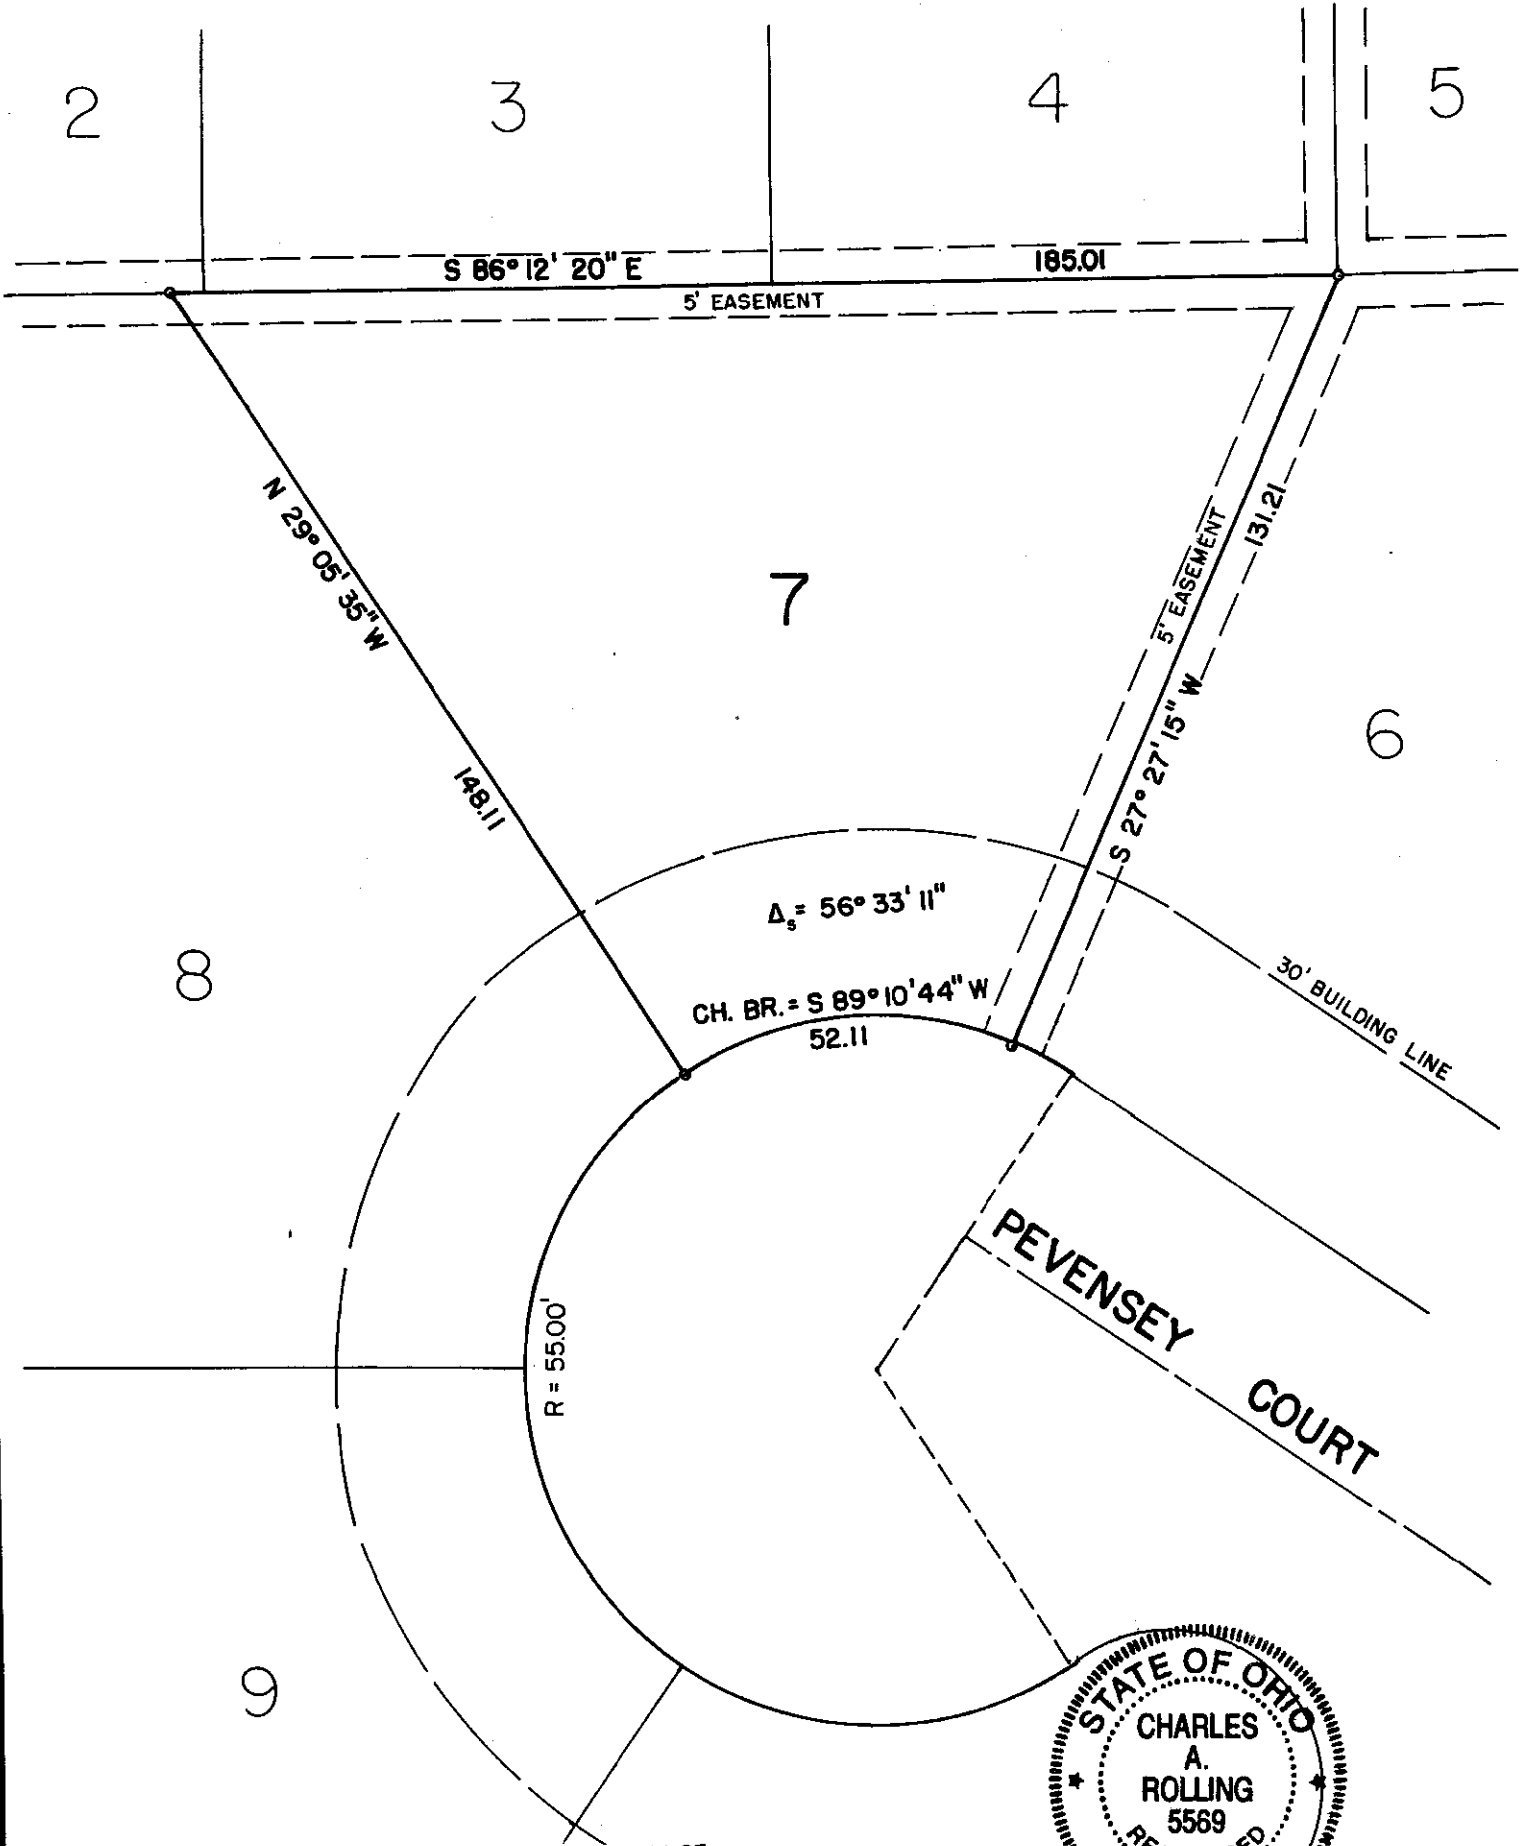

THIS PLAT WAS PREPARED FROM AN ACTUAL SURVEY OF
THE PREMISES AND IS A TRUE AND ACCURATE REPRESENTATION
OF THE SURVEY, TO THE BEST OF MY KNOWLEDGE & BELIEF.
ALL IRON PINS ARE FOUND.

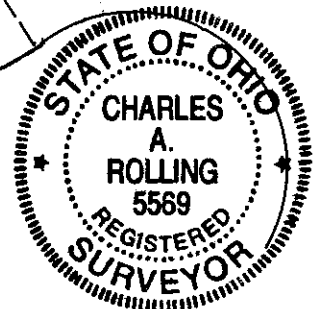

Charles A. Rolling

CHARLES A. ROLLING, Registered Surveyor, No. 5569