


Harry L. Greene

ENGINEERING & SURVEYING

2122 Tremont Center, Columbus, OH 43221

Property Owner : _____ Address : 1737 CAMBRIDGE BOULEVARD
 City : UPPER ARLINGTON County : FRANKLIN
 Lot No. : 14 Subdivision : UPPER ARLINGTON BLK. 1-23 Block No. : 16
 Plat Book : 12 Page : 23 & 24

Scale : 1" = 20' Date : 11-26-93 REV. 01-21-94 Job No. : 138-10-93

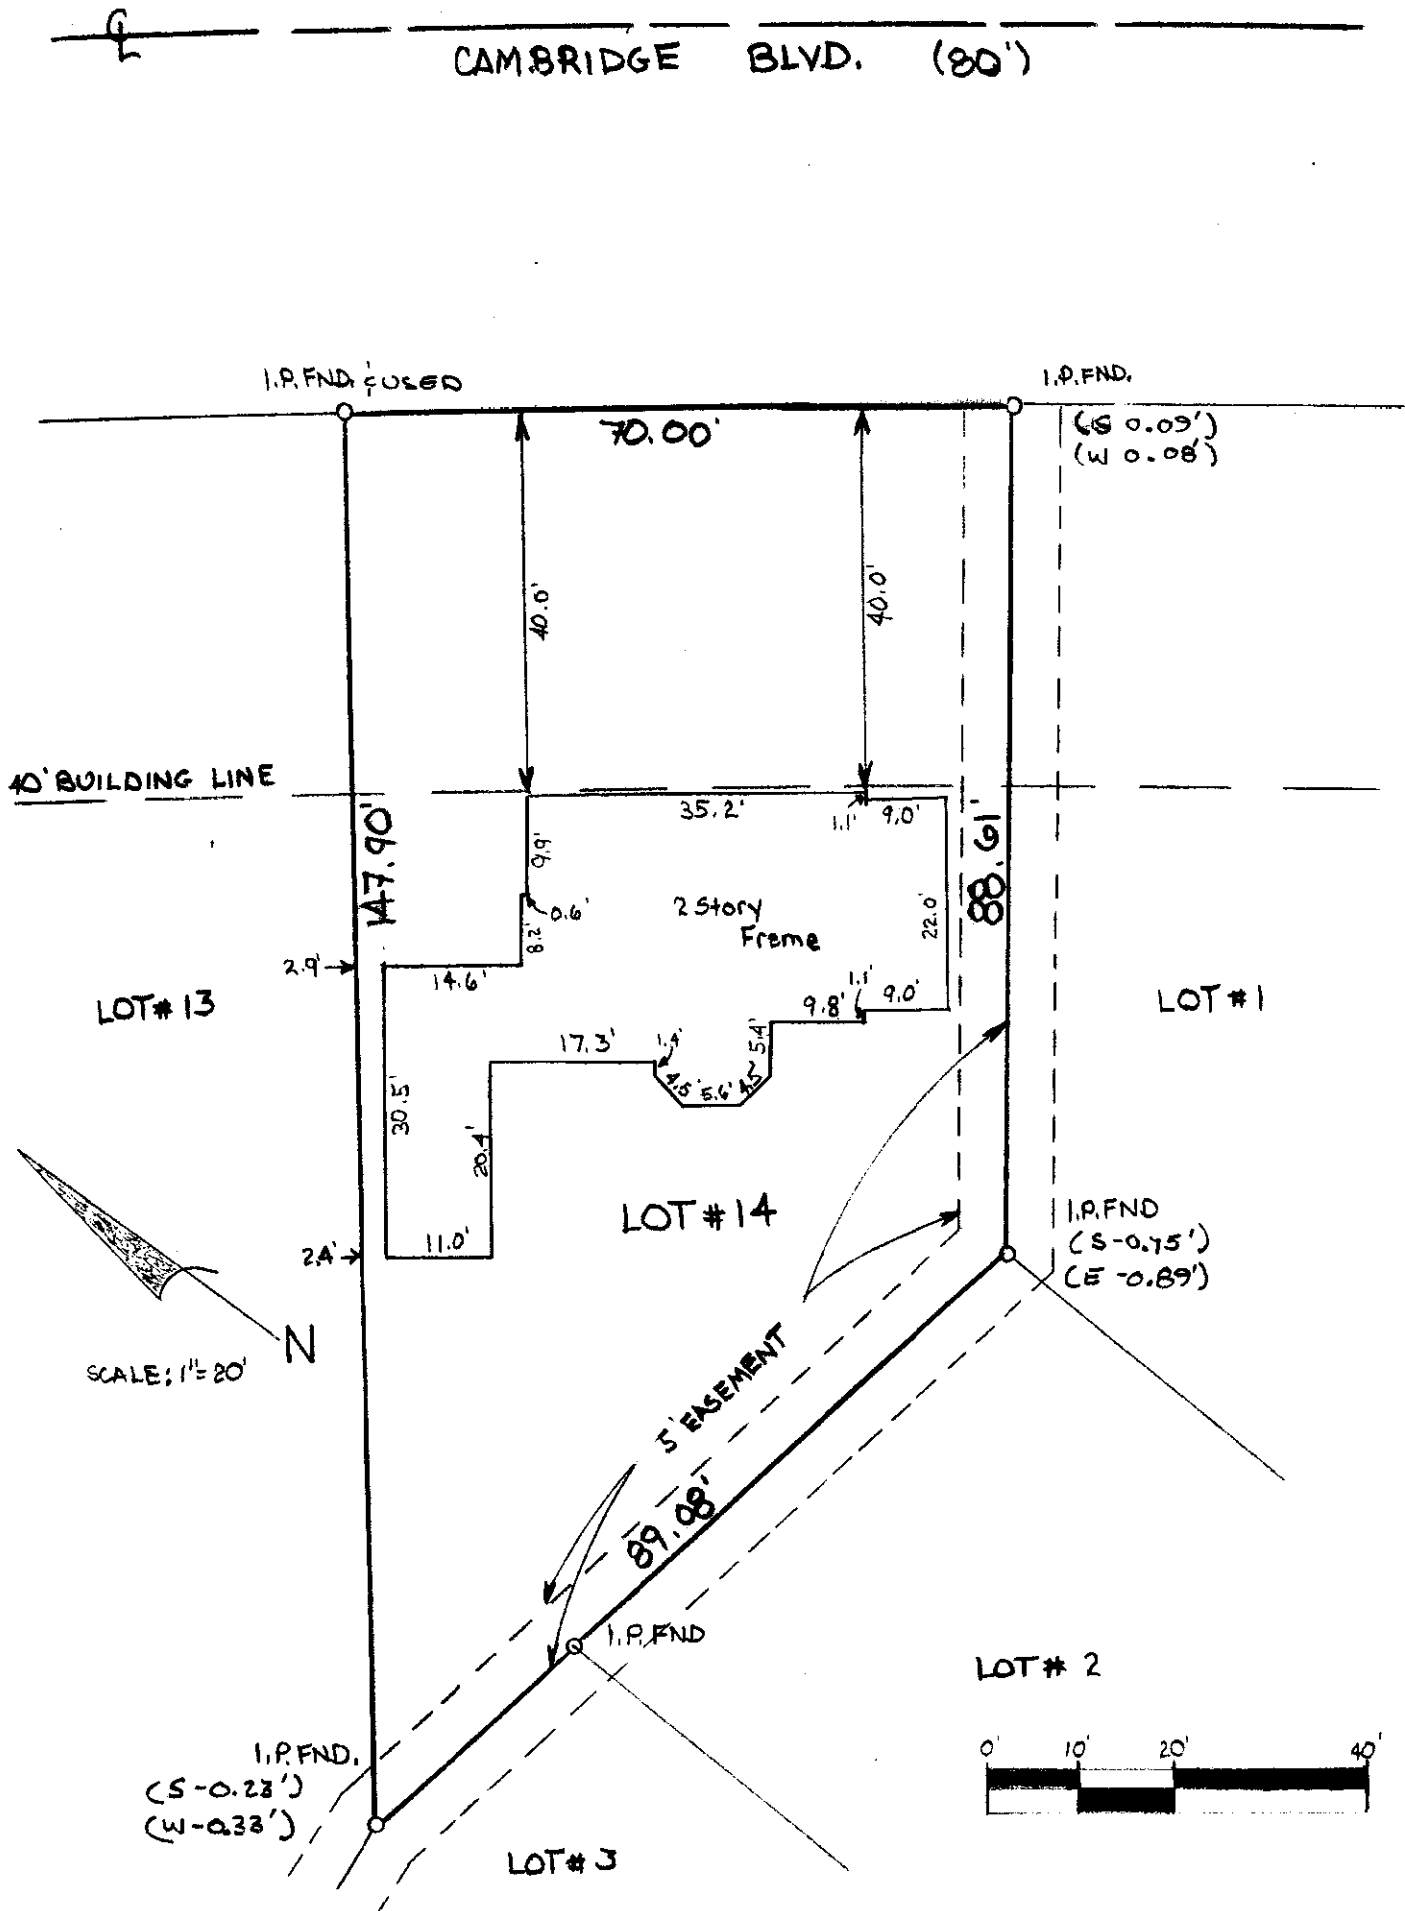

Pen Yalman
 Registered Surveyor
 No. 7169

I hereby certify the above plat has been prepared from an actual survey of the premises on _____