HARRY L. GREENE, ENGINEERING & SURVEYING

2122 Tremont Center, Columbus, OH. 43221

PLAT OF SURVEY OF 1524 BERKSHIRE ROAD, UPPER ARLINGTON, OHIO
BEING LOT 11, OF BLOCK 2, UNIVERSITY ADDITION, P.B. 16, PG. 39
FRANKLIN COUNTY RECORDER'S OFFICE, FRANKLIN COUNTY, OHIO.

NOTE: THE STONE WALK ADDED TO THE BLACKTOP DRIVE OF LOT 11 ENCROACHES UPON LOT 12. THE BLACKTOP IS ENTIRELY UPON LOT 11.

August 11, 1993 87-07-93

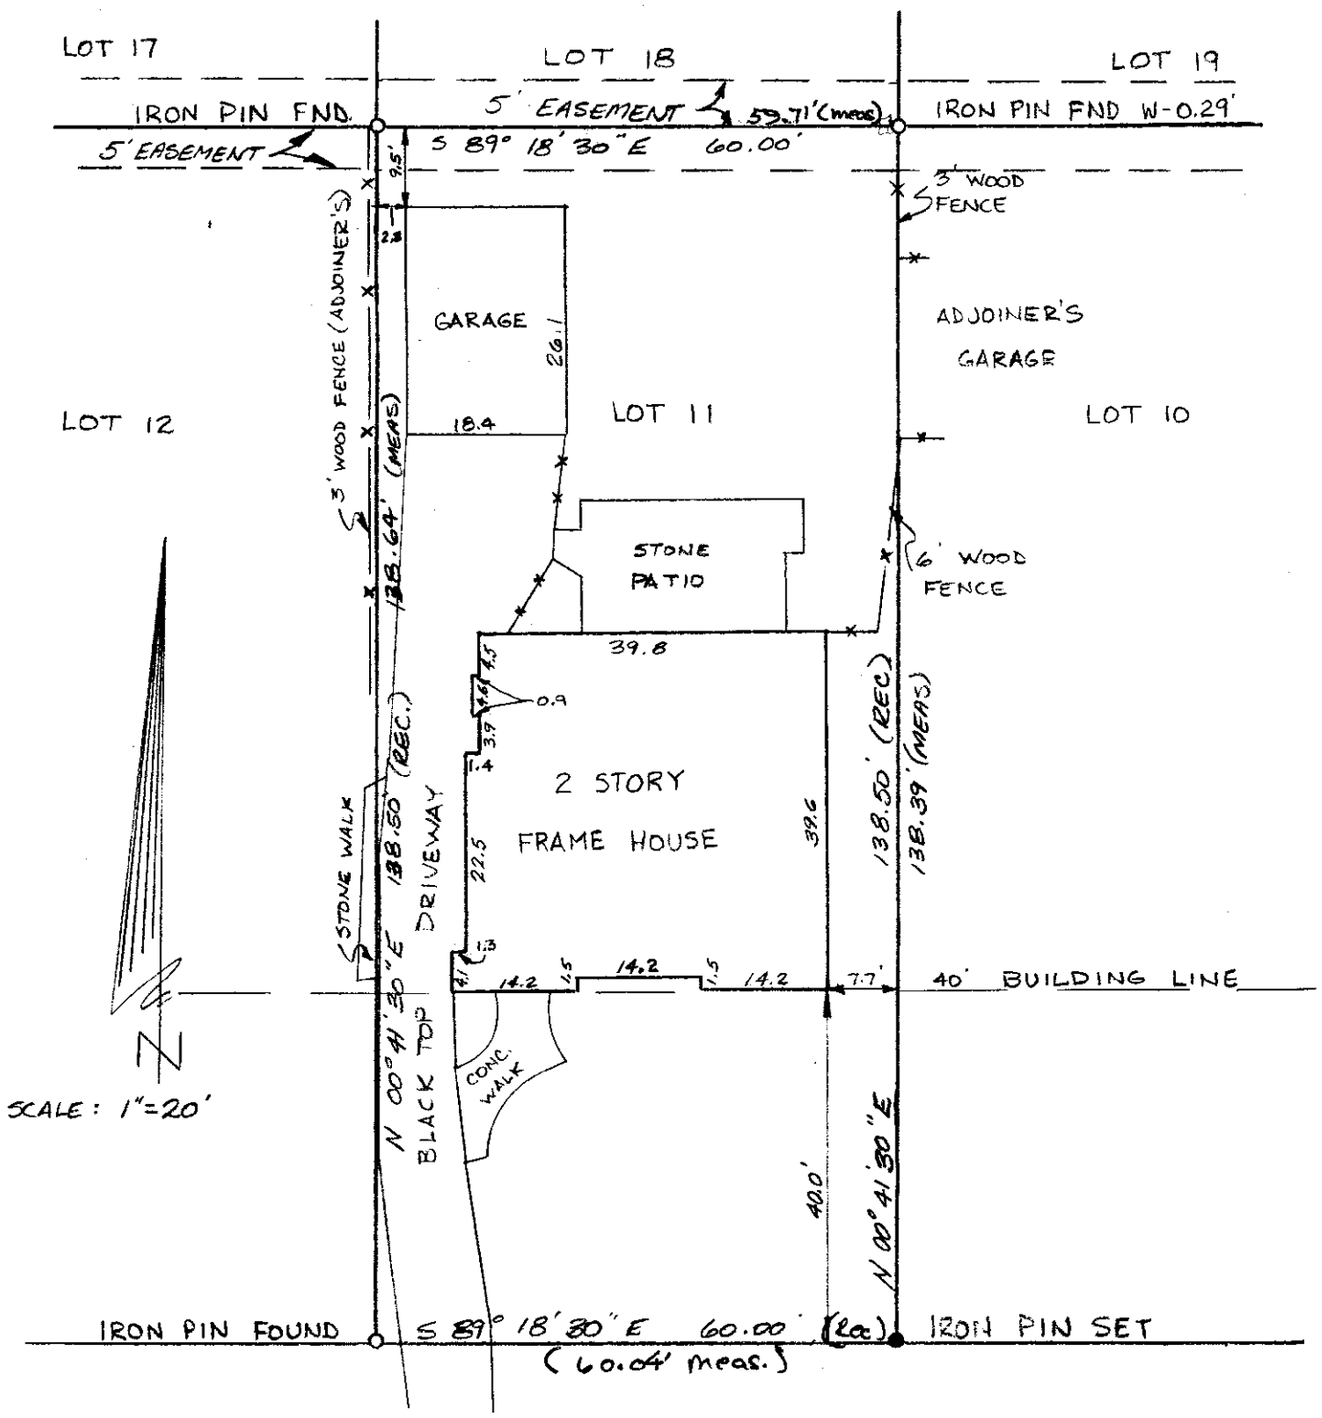

All iron pins set are 5/8" x 30" rebar with yellow identification cap marked "ROLLING S-5569"

THIS PLAT WAS PREPARED BY HARRY L. GREENE, ENGINEERING & SURVEYING, AND IS A TRUE AND ACCURATE REPRESENTATION, TO THE BEST OF MY KNOWLEDGE AND BELIEF, OF A SURVEY MADE BY SAME IN AUGUST 1993.

STATE OF OHIO
RONALD JOHN YARANO 7169
REGISTERED PROFESSIONAL SURVEYOR

Ronald J. Yarano

Ronald J. Yarano
REG. SURVEYOR NO. S - 7169