

HARRY L. GREENE, ENGINEERING & SURVEYING


2122 Tremont Center, Columbus, OH. 43221

PLAT SHOWING BOUNDARY AND HOUSE LOCATION OF LOT 109, GREENFIELD ESTATES, CITY OF COLUMBUS, OHIO.

FOR : BARBARA SOBALA

SCALE: 1" = 20'

JULY 8, 1993

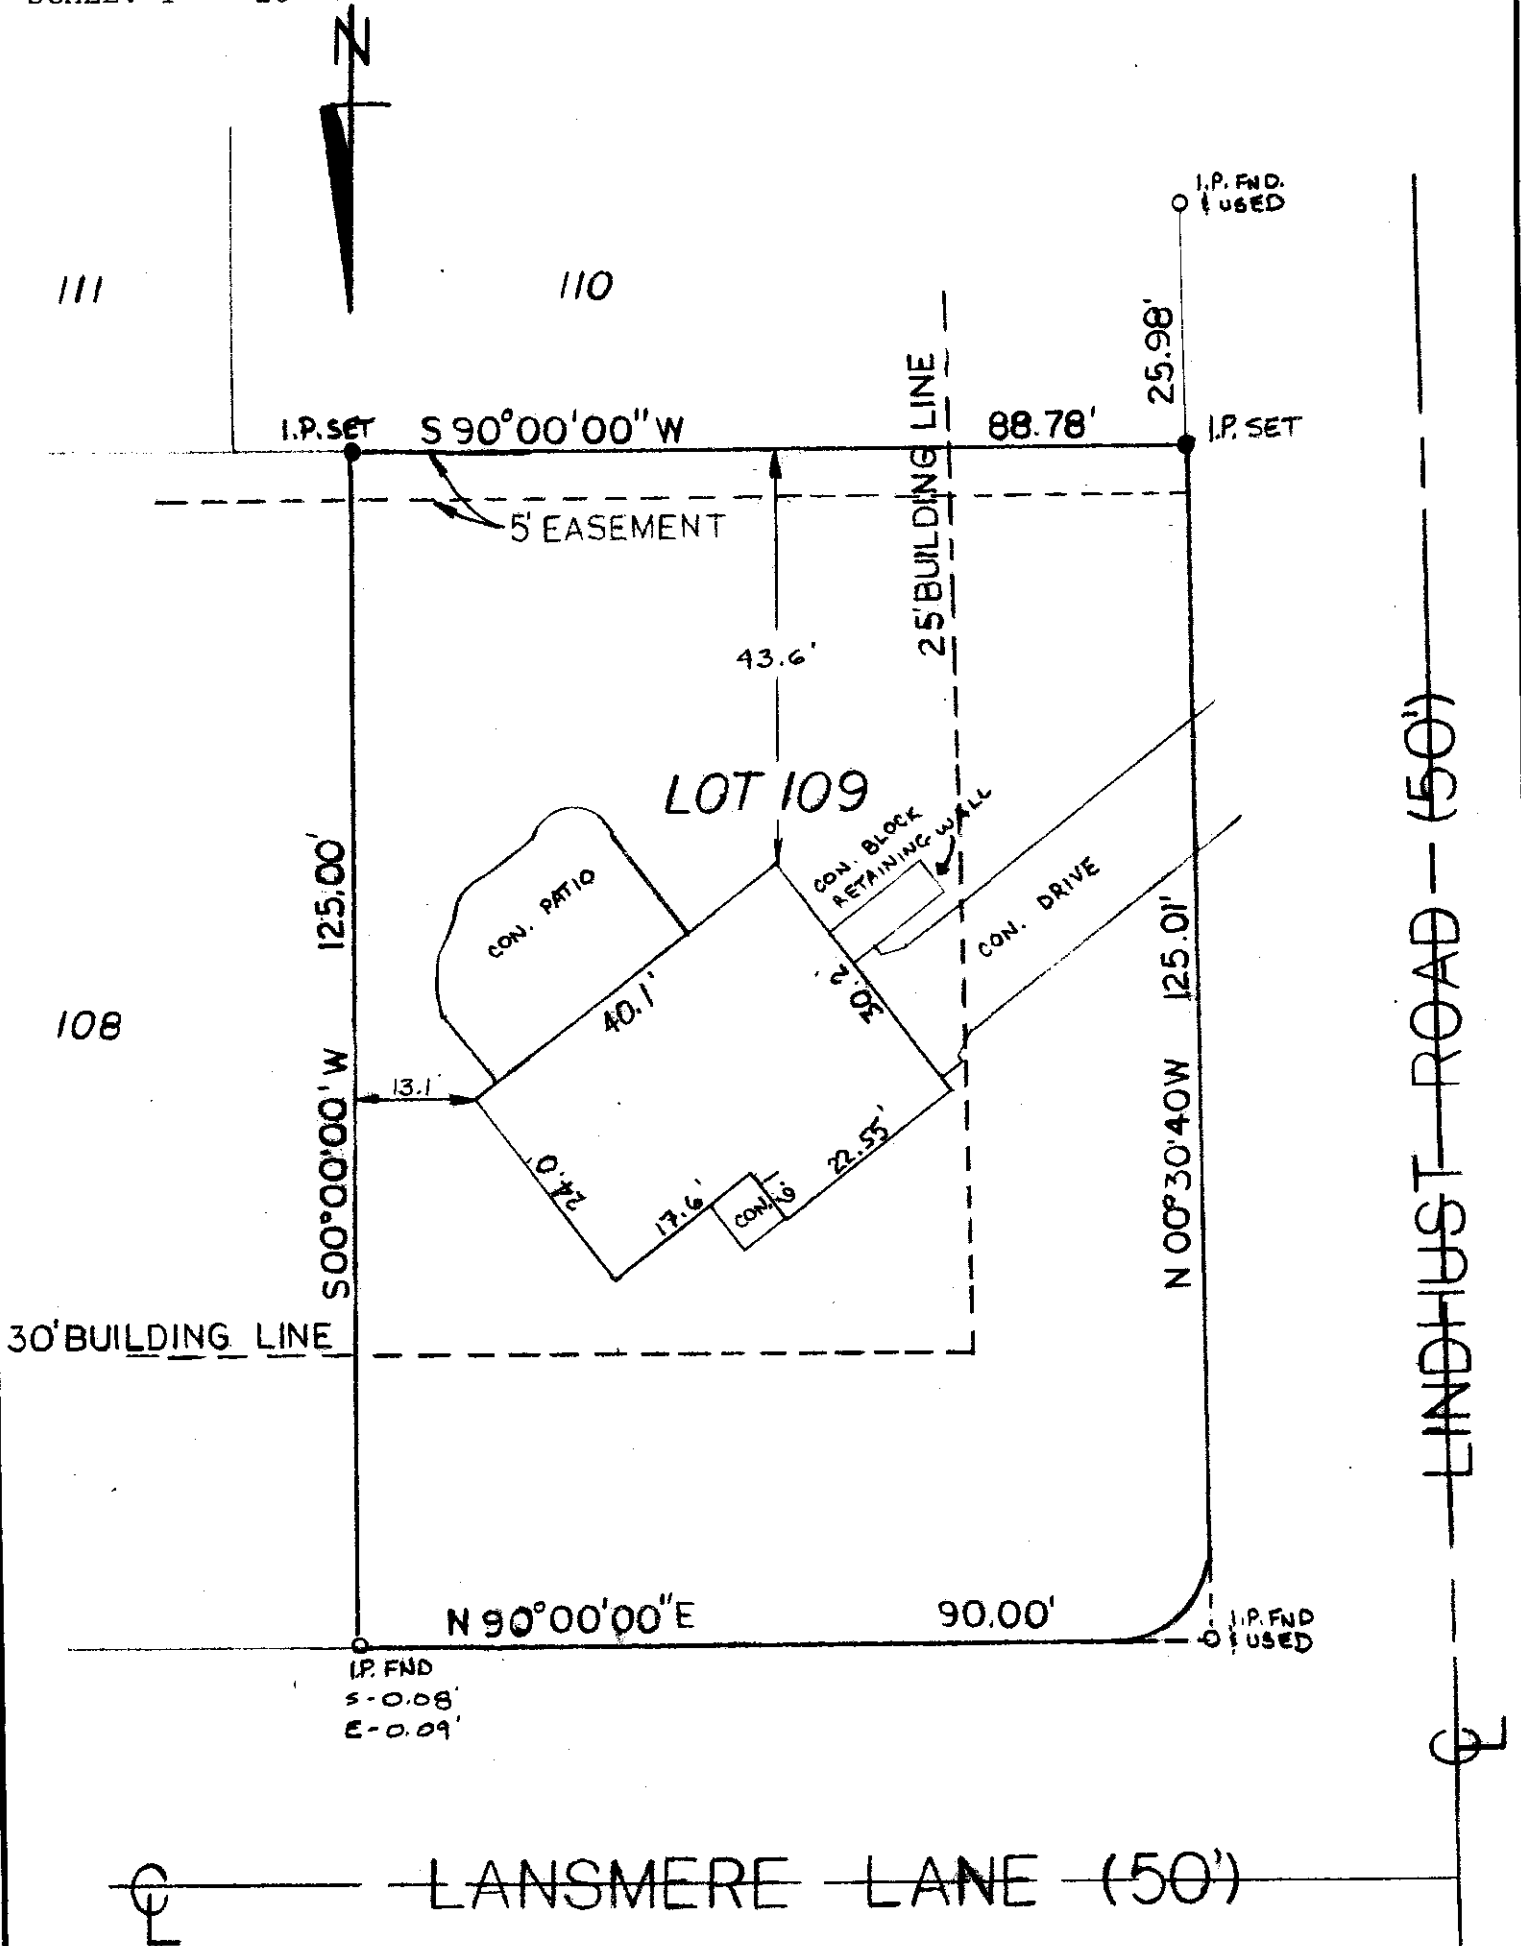

Charles A. Rolling
 CHARLES A. ROLLING
 REG. SURVEYOR NO. 5569