


# HARRY L. GREENE, ENGINEERING & SURVEYING

2122 Tremont Center, Columbus, OH. 43221

PLAT SHOWING SURVEY OF LOT NO. 1, BLOCK 85, CITY OF UPPER ARLINGTON OHIO, AS SHOWN OF RECORD IN PLAT BOOK 14, PAGE 31, RECORDERS OFFICE FRANKLIN COUNTY, OHIO.

Scale 1"=20' May 14, 1993

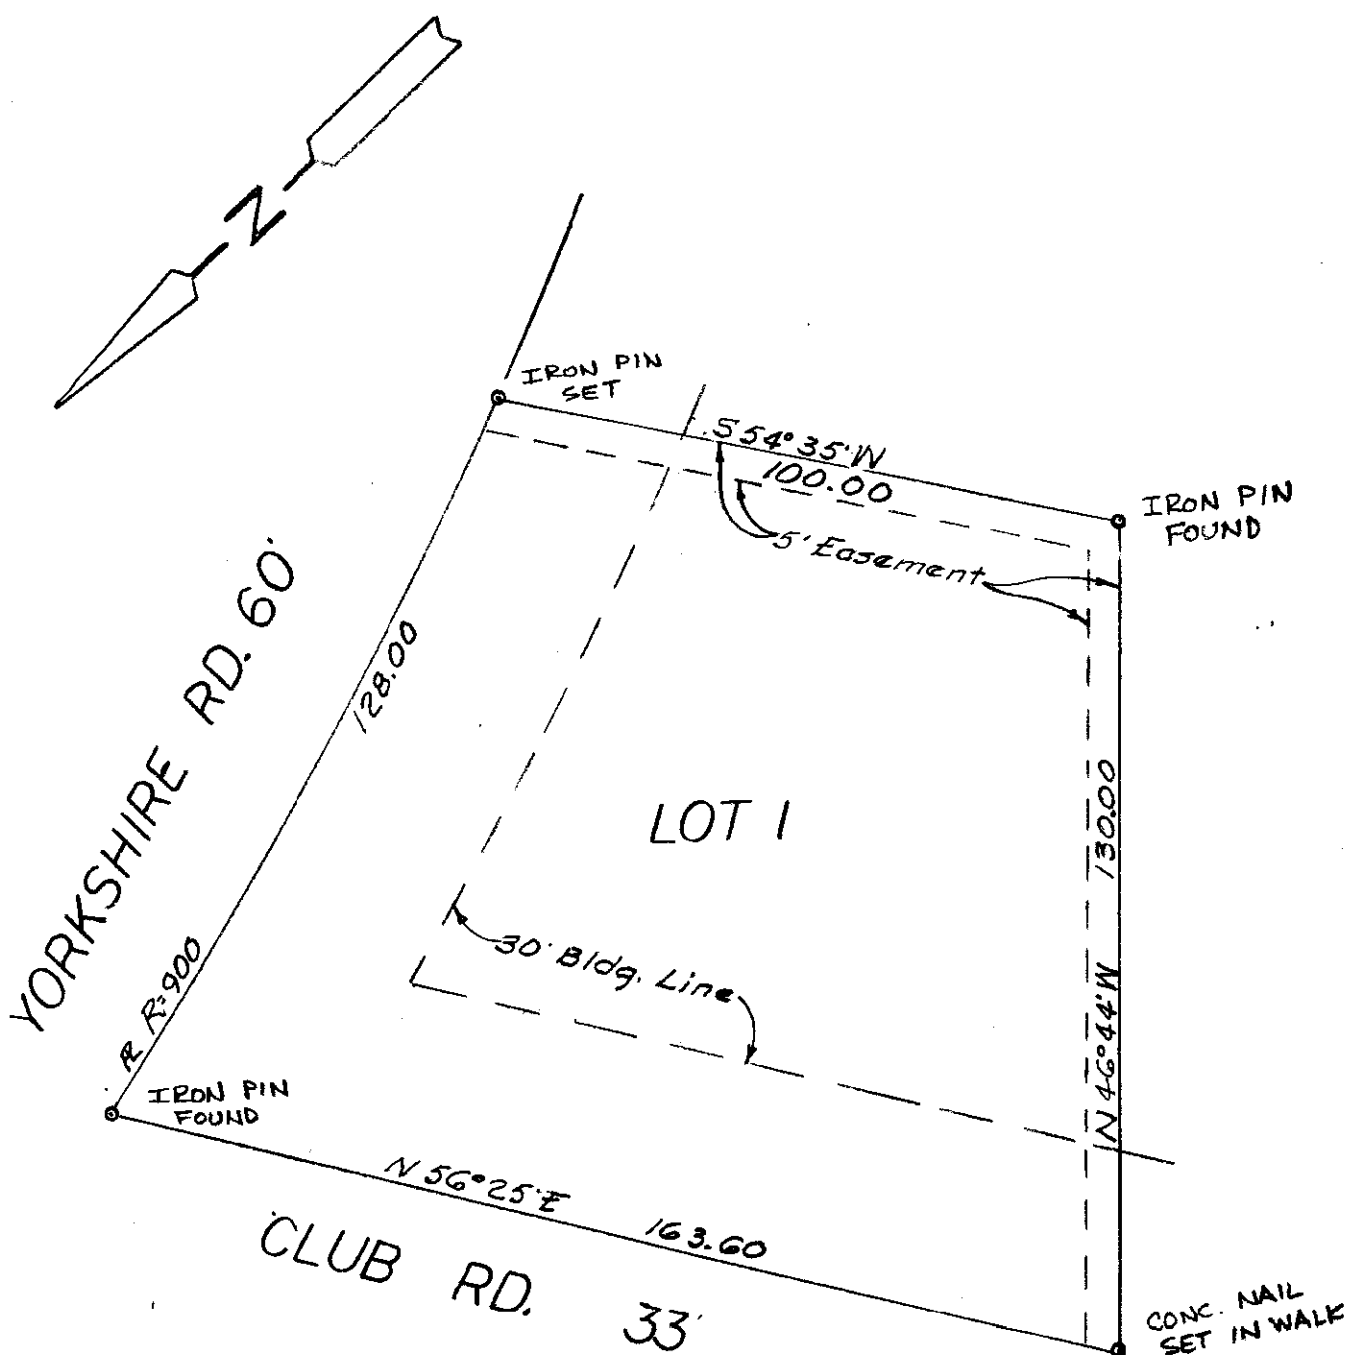

*Charles A. Rolling*  
CHARLES A. ROLLING  
REG. SURVEYOR NO. 5569