

# HARRY L. GREENE, ENGINEERING & SURVEYING


2122 Tremont Center, Columbus, OH. 43221

PLAT SHOWING SURVEY OF LOT 7, NORTHRIDGE INDIANOLA ADDITION,  
P.B. 21, PG. 5, RECORDER'S OFFICE, FRANKLIN COUNTY, OHIO.

FOR: MR. & MRS. ALBERT KOSHIBA

MAY 28, 1993

JOB # 38-04-93

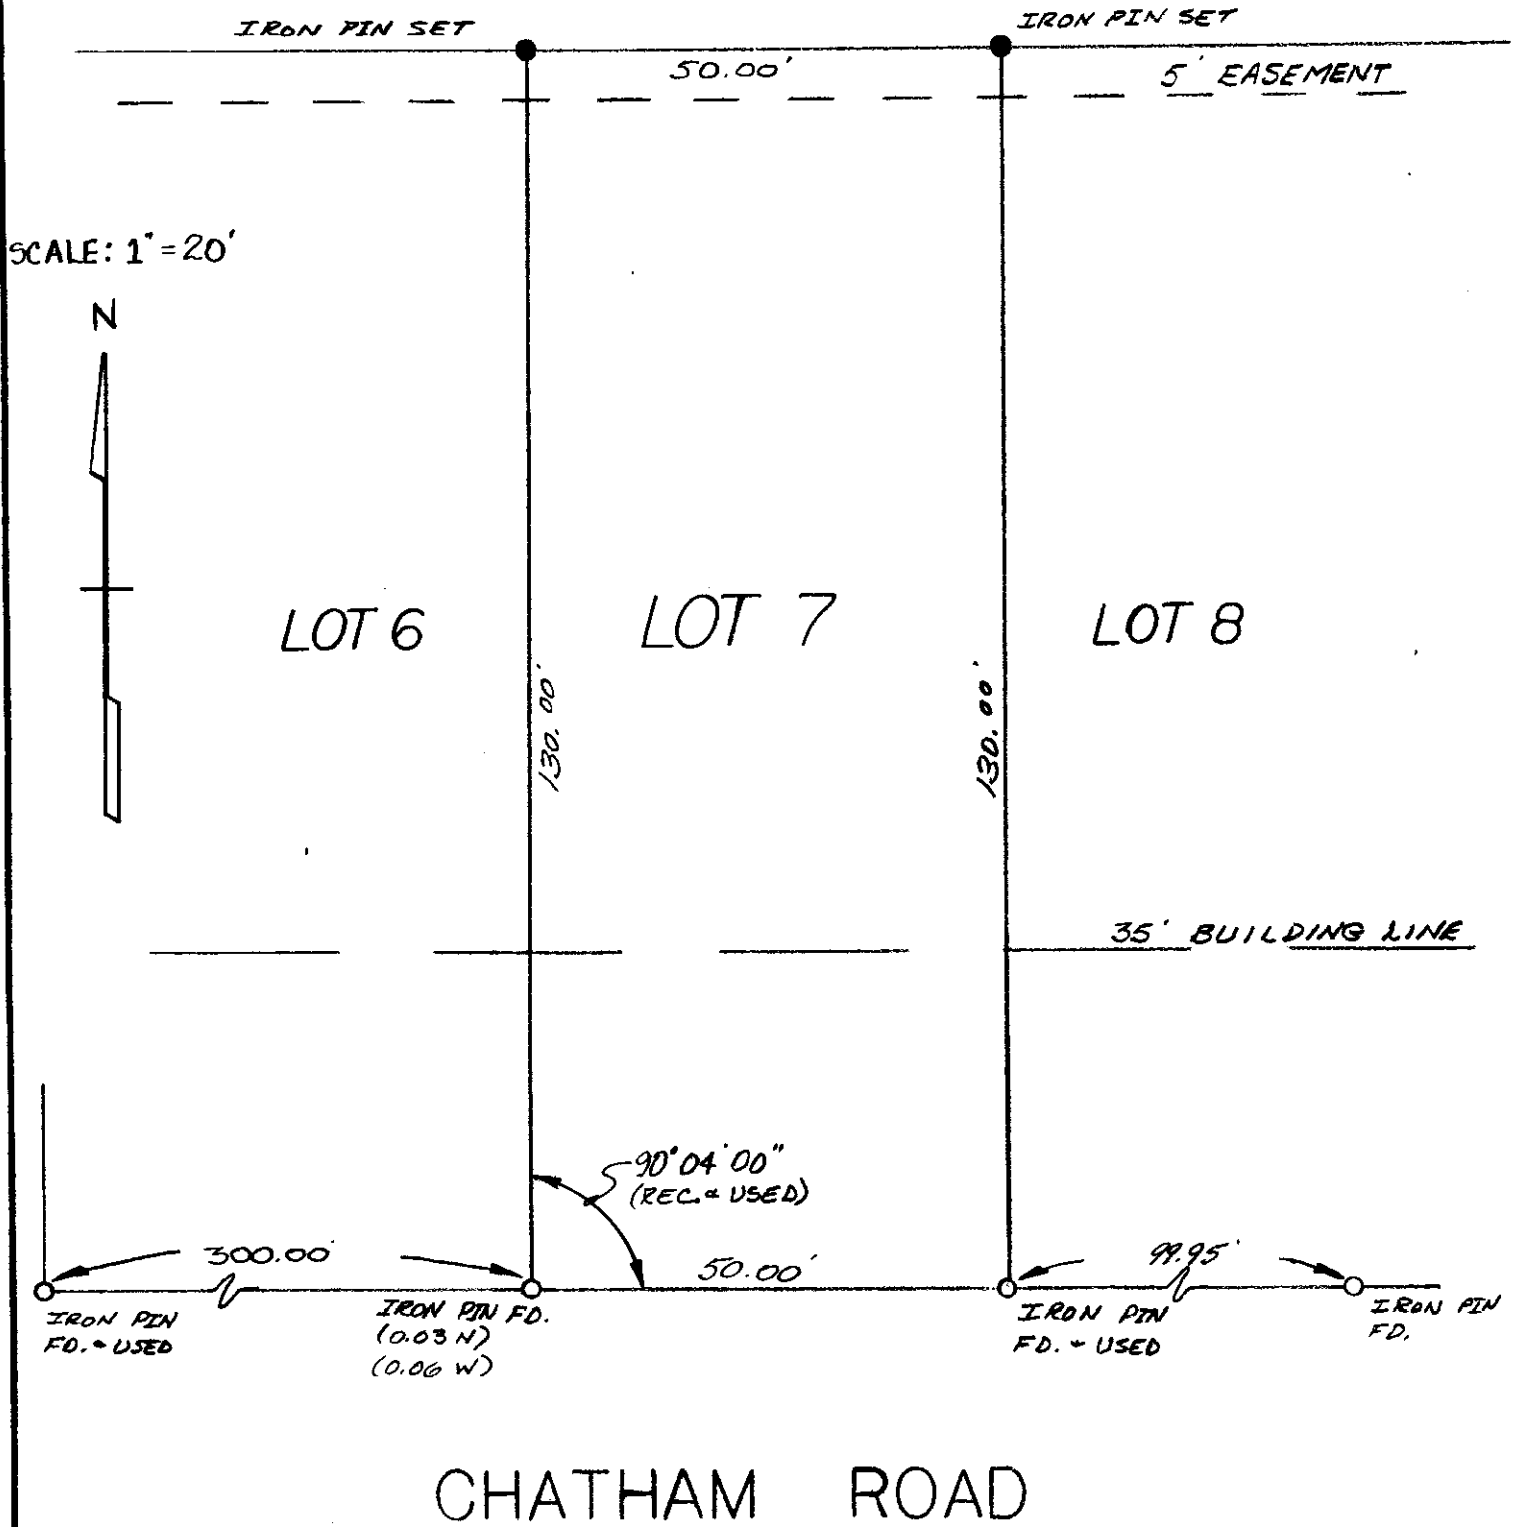

*Charles A. Rolling*  
CHARLES A. ROLLING  
REG. SURVEYOR NO. 5569