


PLAT OF SURVEY  
 FOR  
 FELICIA BERNARDINI  
 3083 WOODBINE PLACE  
 LOT NO. 46  
 WOODBINE PLACE  
 P.B. 18, PG. 42  
 CITY OF COLUMBUS  
 COUNTY OF FRANKLIN  
 STATE OF OHIO

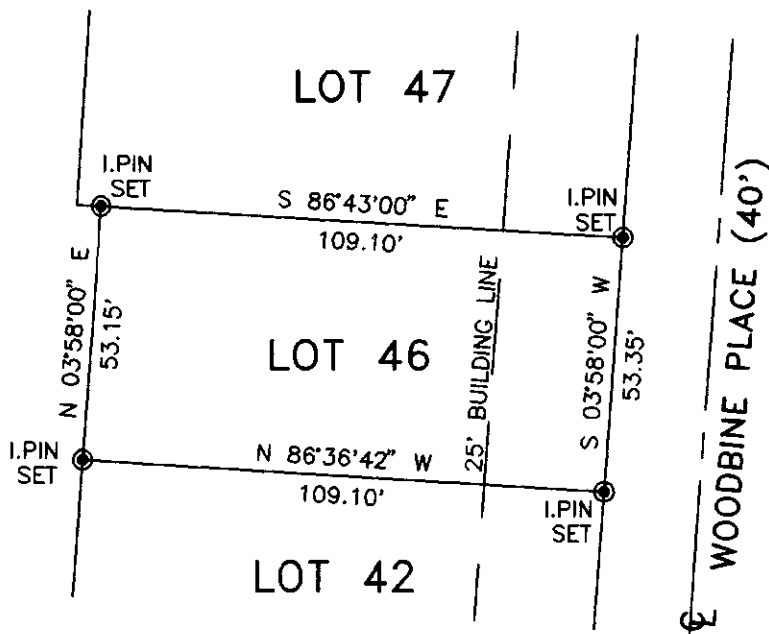


THIS PLAT WAS PREPARED BY HARRY L. GREENE, ENGINEERING AND SURVEYING, AND IS A TRUE AND ACCURATE REPRESENTATION, TO THE BEST OF MY KNOWLEDGE AND BELIEF, OF A SURVEY MADE BY SAME IN MAY 1996.



1 inch = 40 ft.

*William Edward Chaffin*

WILLIAM EDWARD CHAFFIN  
 REGISTERED SURVEYOR NO. 7559

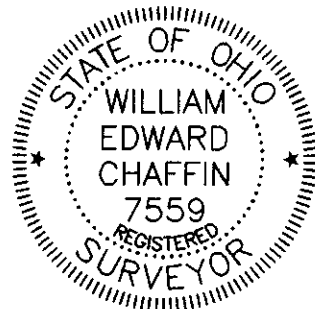

- PLAN PREPARED BY -

*HARRY L. GREENE, ENGINEERING AND SURVEYING*

DRAWN BY: R. CHAFFIN

DATE: MAY 27, 1996

CHECKED BY: W. CHAFFIN

DRAWING NO.: 60-96.DWG

JOB NO.: 60-96

SHEET 1 OF 1



2122 TREMONT CENTER  
 COLUMBUS, OHIO 43221  
 (614) 486-0714