


PLAT OF SURVEY
 FOR
 KEVIN RUSSELL
 3363 ABBEY ROAD
 CITY OF COLUMBUS
 COUNTY OF FRANKLIN
 STATE OF OHIO

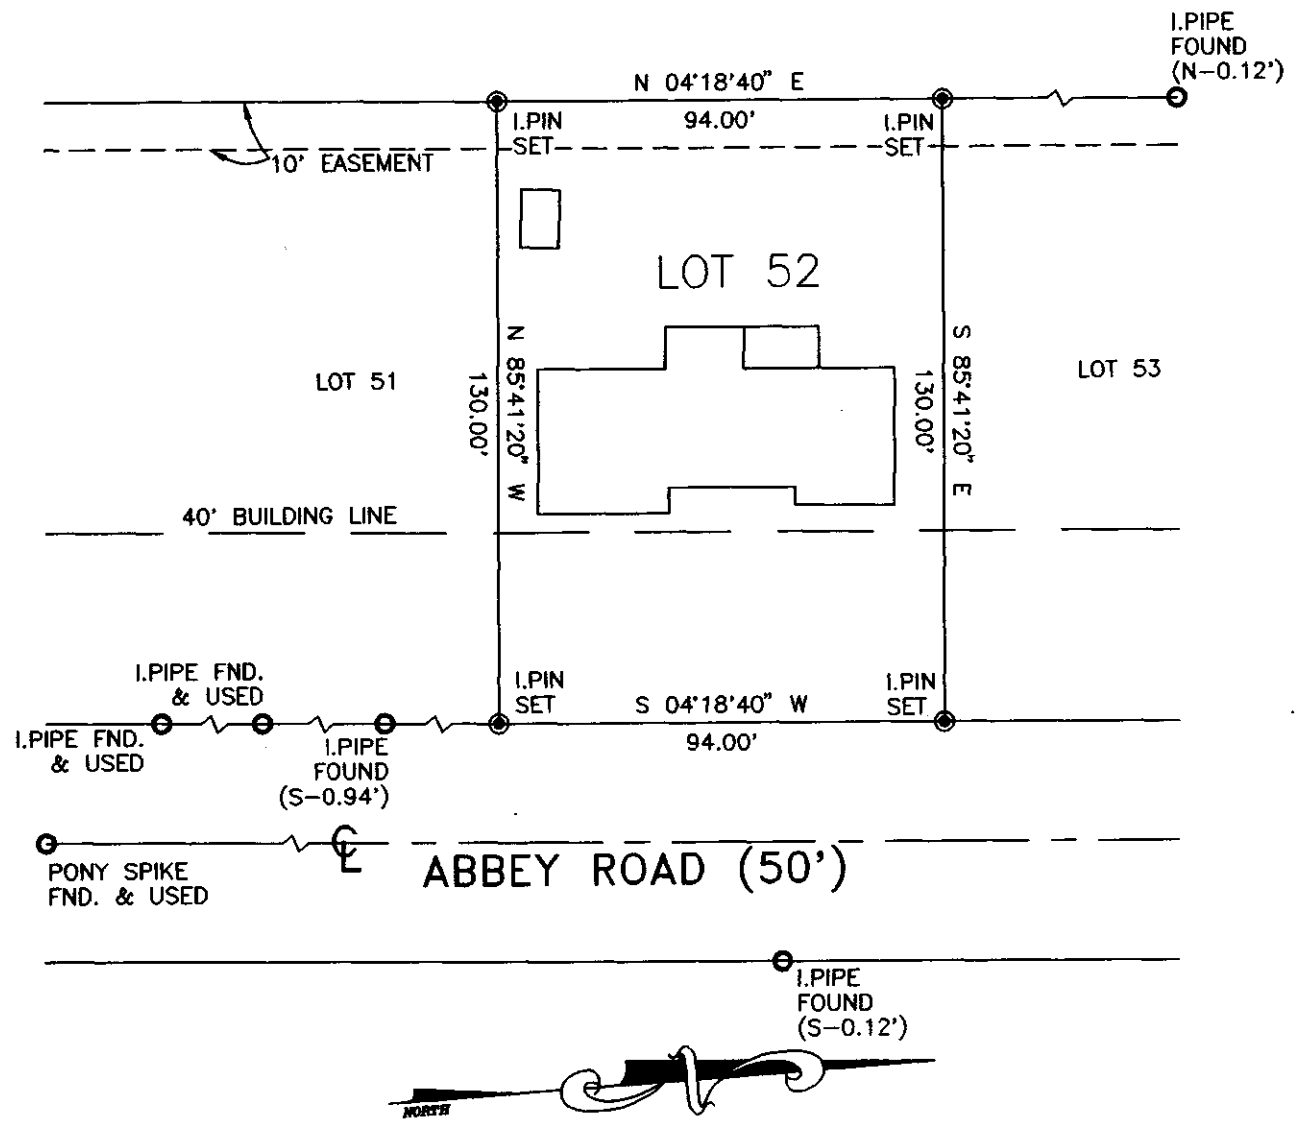



THIS PLAT WAS PREPARED BY HARRY L. GREENE, ENGINEERING AND SURVEYING, AND IS A TRUE AND ACCURATE REPRESENTATION, TO THE BEST OF MY KNOWLEDGE AND BELIEF, OF A SURVEY MADE BY SAME IN MAY 1996.



1 inch = 40 ft.

William Edward Chaffin
 WILLIAM EDWARD CHAFFIN
 REGISTERED SURVEYOR NO. 7559

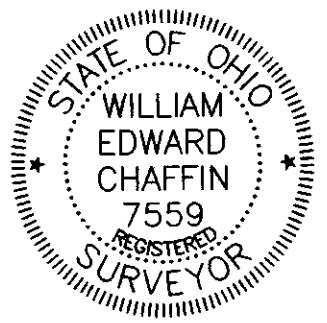

- PLAN PREPARED BY -	
HARRY L. GREENE, ENGINEERING AND SURVEYING	
DRAWN BY: R.CHAFFIN CHECKED BY: W.CHAFFIN JOB NO.: 56-96	DATE: MAY 27, 1996 DRAWING NO.: 56-96.DWG SHEET 1 OF 1
	2122 TREMONT CENTER COLUMBUS, OHIO 43221 (614) 486-0714