


RECEIVED

FEB 14 2011

Franklin County Engineer
Dean C. Ringle, P.E., P.S.

TRACT ONE
9.9575 ACRES

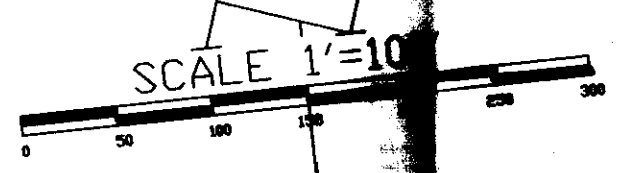

BASIS OF BEARING: THE WEST LINE OF THE SCITTO VALLEY TRACTION COMPANY RIGHT-OF-WAY AS S 05°47'00" W FROM INST.#200902250025698.

PRIOR DEED REFERENCE:
JODY E. SLOANE UNDIVIDED 3/18 INTEREST
MATHEW J. DILL UNDIVIDED 3/18 INTEREST
HEATHER J. DILL UNDIVIDED 3/18 INTEREST
ANDREW J. DILL UNDIVIDED 2/18 INTEREST
JONATHAN DILL UNDIVIDED 2/18 INTEREST
DAVID DILL UNDIVIDED 2/18 INTEREST
STEPHANIE DILL-FARRELL UNDIVIDED 2/18 INTEREST
INST.#200902250025698

CHARLES C. HANN TRS. 1/2 INTEREST
ALICE L. HANN TRS. 1/2 INTEREST
1330 ACRES
INST. 200811070163943

CHARLES C. HANN TRS. 1/2 INTEREST
ALICE L. HANN TRS. 1/2 INTEREST
1330 ACRES
INST. 200811070163943

TRACT TWO
56.1840 ACRES
(TAX DUP. = 60.34 ACRES)
A PORTION OF 150-000132

RAILROAD
C/L INTERSECTION
STA. = 159+30.4

3/4" IRON PIPE SET

3/4" IRON PIPE SET

3/4" IRON PIPE SET @ 44.44'

3/4" IRON PIPE SET

3/4" IRON PIPE SET

CARRIE A. SMITH, TRS.
1.897 ACRES
DB-30896-J-10

CARRIE A. SMITH, TOD.
3.144 ACRES
INST. 200505310104353

DONALD S. CRUZ
3.065 ACRES
INST. 200908260125137

YOUNG MENS CHRISTIAN ASSOCIATION OF COLUMBUS
27.09 ACRES DB-2339 PG-561


YOUNG MENS CHRISTIAN ASSOCIATION OF COLUMBUS
30.0 ACRES DB-1408 PG-191

BOUNDARY SURVEY
OF TRACT TWO 56.1840 ACRES IN
SEC-26, TWP-04, RGE-22,
HAMILTON TOWNSHIP, FRANKLIN COUNTY,
STATE OF OHIO:

FOR
JODY E. SLOANE et.al. (7)
AND OR
KENNETH E. ZWAYER

Louis Haines

354 Kessler Street
Groveport, Ohio 43125
Phone 837-2181

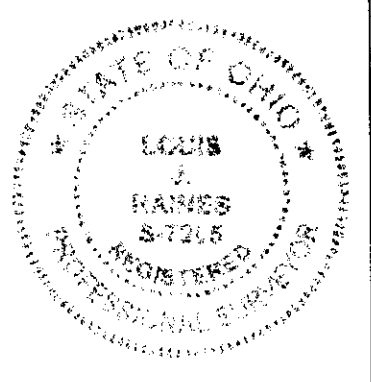

HEREBY CERTIFY THE PLAT SHOWN HEREON IS CORRECT AS SURVEYED BY US.
DATE: FEB 14 2011
SIGNED: [Signature]

ALL 3/4" IRON PIPE SET ARE 3/4" GALVANIZED IRON PIPE CUT TO 30' LENGTHS WITH AN ORANGE PLASTIC ID CAP INSCRIBED "HAINES SURV."
ALL DEED, SURVEY, PLAN AND OTHER INFORMATION NOTED HEREON IS AVAILABLE FROM THE COUNTY AND STATE IN WHICH THIS SURVEY WAS PERFORMED.