RECEIVED

JUN 07 2011

Franklin County Engineer
Dean C. Ringle, P.E., P.S.

F-8-3

EMH&T
Evans, Mechwart, Hambleton & Tilton, Inc.
Engineers • Surveyors • Planners • Scientists
5500 New Albany Road, Columbus, OH 43054
Phone: 614.775.4500 Toll Free: 888.775.3648
emht.com

SURVEY OF ACREAGE PARCEL

SECTION 6, TOWNSHIP 5, RANGE 22
REFUGEE LANDS
CITY OF CLOUMBUS, COUNTY OF FRANKLIN, STATE OF OHIO

Date: May 23, 2011 | Job No. 2011-0687 | Scale: 1" = 100'

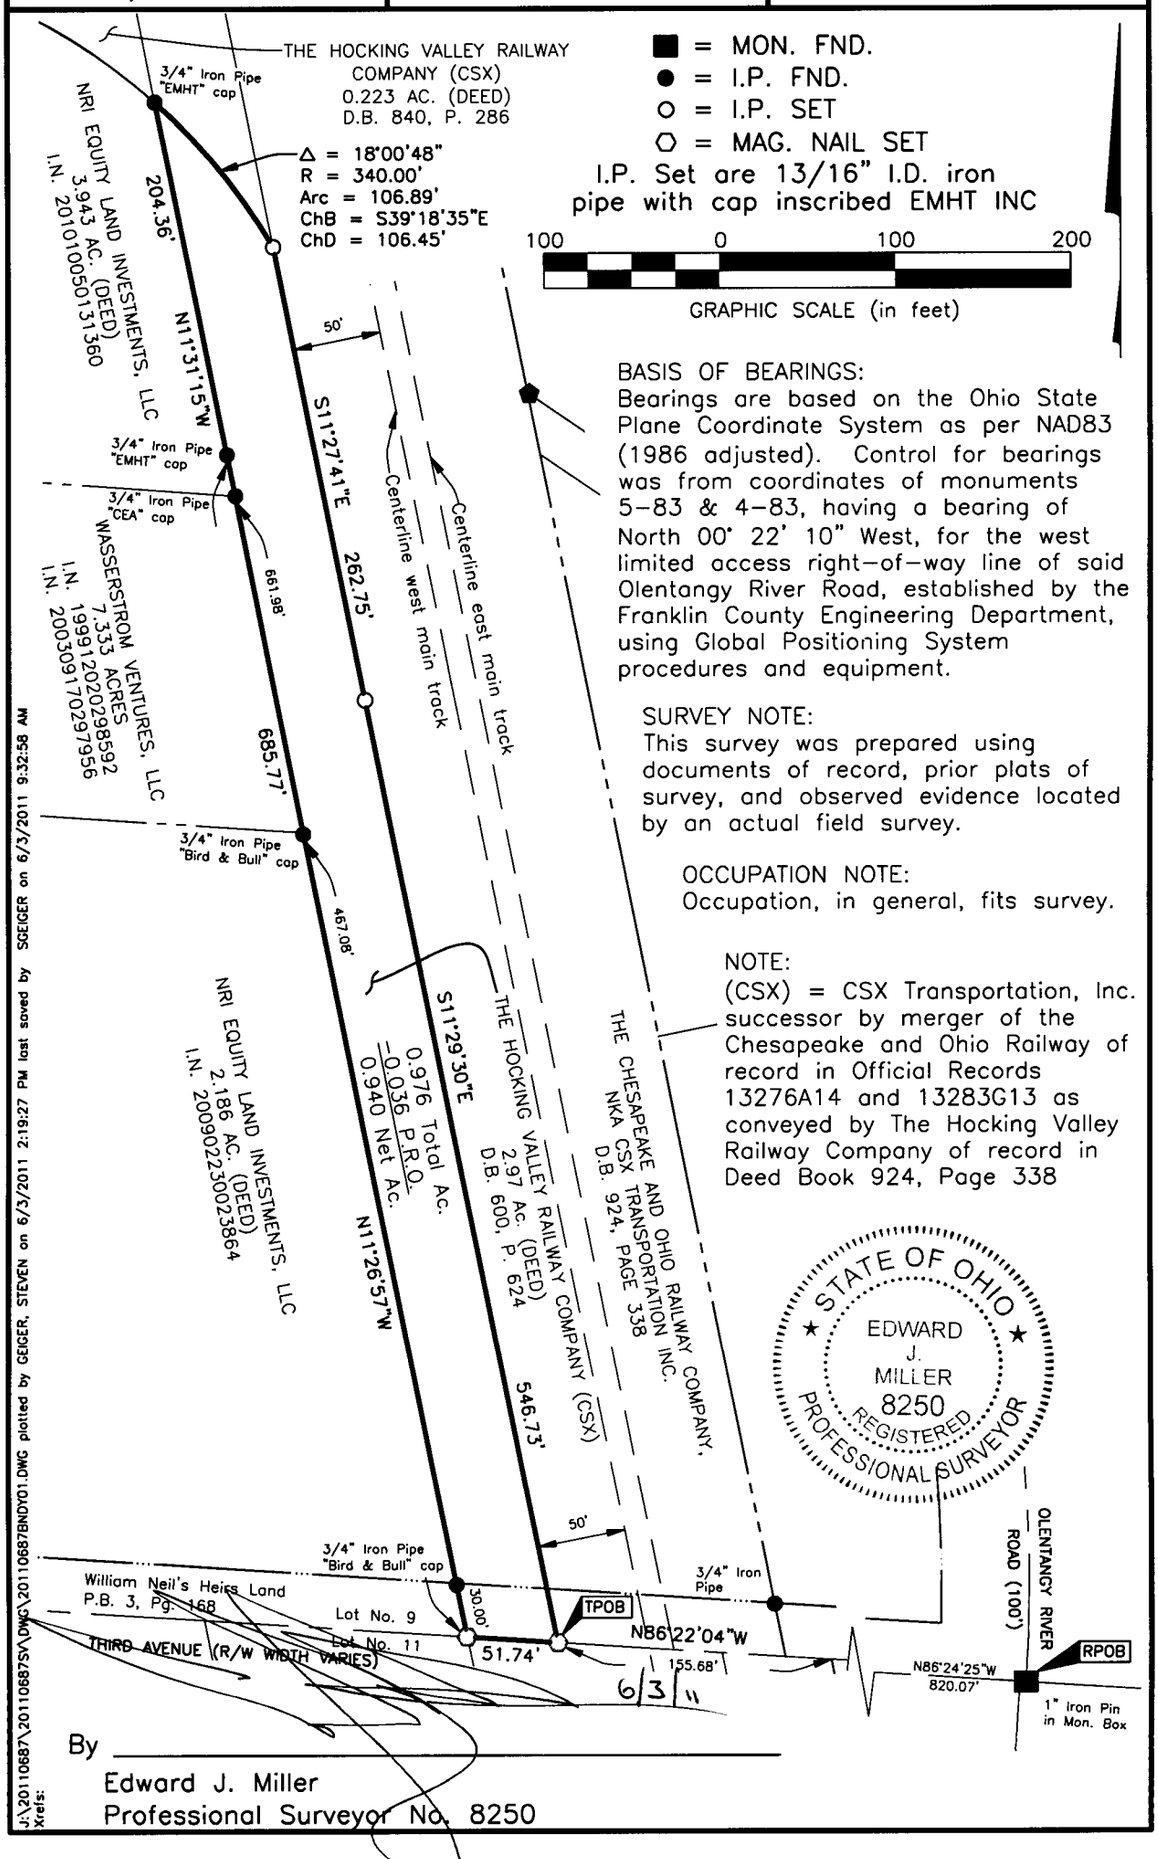

BASIS OF BEARINGS:
Bearings are based on the Ohio State Plane Coordinate System as per NAD83 (1986 adjusted). Control for bearings was from coordinates of monuments 5-83 & 4-83, having a bearing of North 00° 22' 10" West, for the west limited access right-of-way line of said Olentangy River Road, established by the Franklin County Engineering Department, using Global Positioning System procedures and equipment.

SURVEY NOTE:
This survey was prepared using documents of record, prior plats of survey, and observed evidence located by an actual field survey.

OCCUPATION NOTE:
Occupation, in general, fits survey.

NOTE:
(CSX) = CSX Transportation, Inc. successor by merger of the Chesapeake and Ohio Railway of record in Official Records 13276A14 and 13283G13 as conveyed by The Hocking Valley Railway Company of record in Deed Book 924, Page 338

STATE OF OHIO
EDWARD J. MILLER
8250
REGISTERED PROFESSIONAL SURVEYOR

6/3/11

By _____
Edward J. Miller
Professional Surveyor No. 8250

J:\20110687\20110687SVY\DWG\20110687BNDY01.DWG plotted by GEIGER, STEVEN on 6/3/2011 2:19:27 PM last saved by SGEIGER on 6/3/2011 9:32:58 AM
Xrefs: