


# SURVEY OF ACREAGE PARCELS

SITUATE  
VIRGINIA MILITARY SURVEY NUMBERS 3012 AND 3453  
CITY OF DUBLIN, COUNTY OF FRANKLIN, STATE OF OHIO

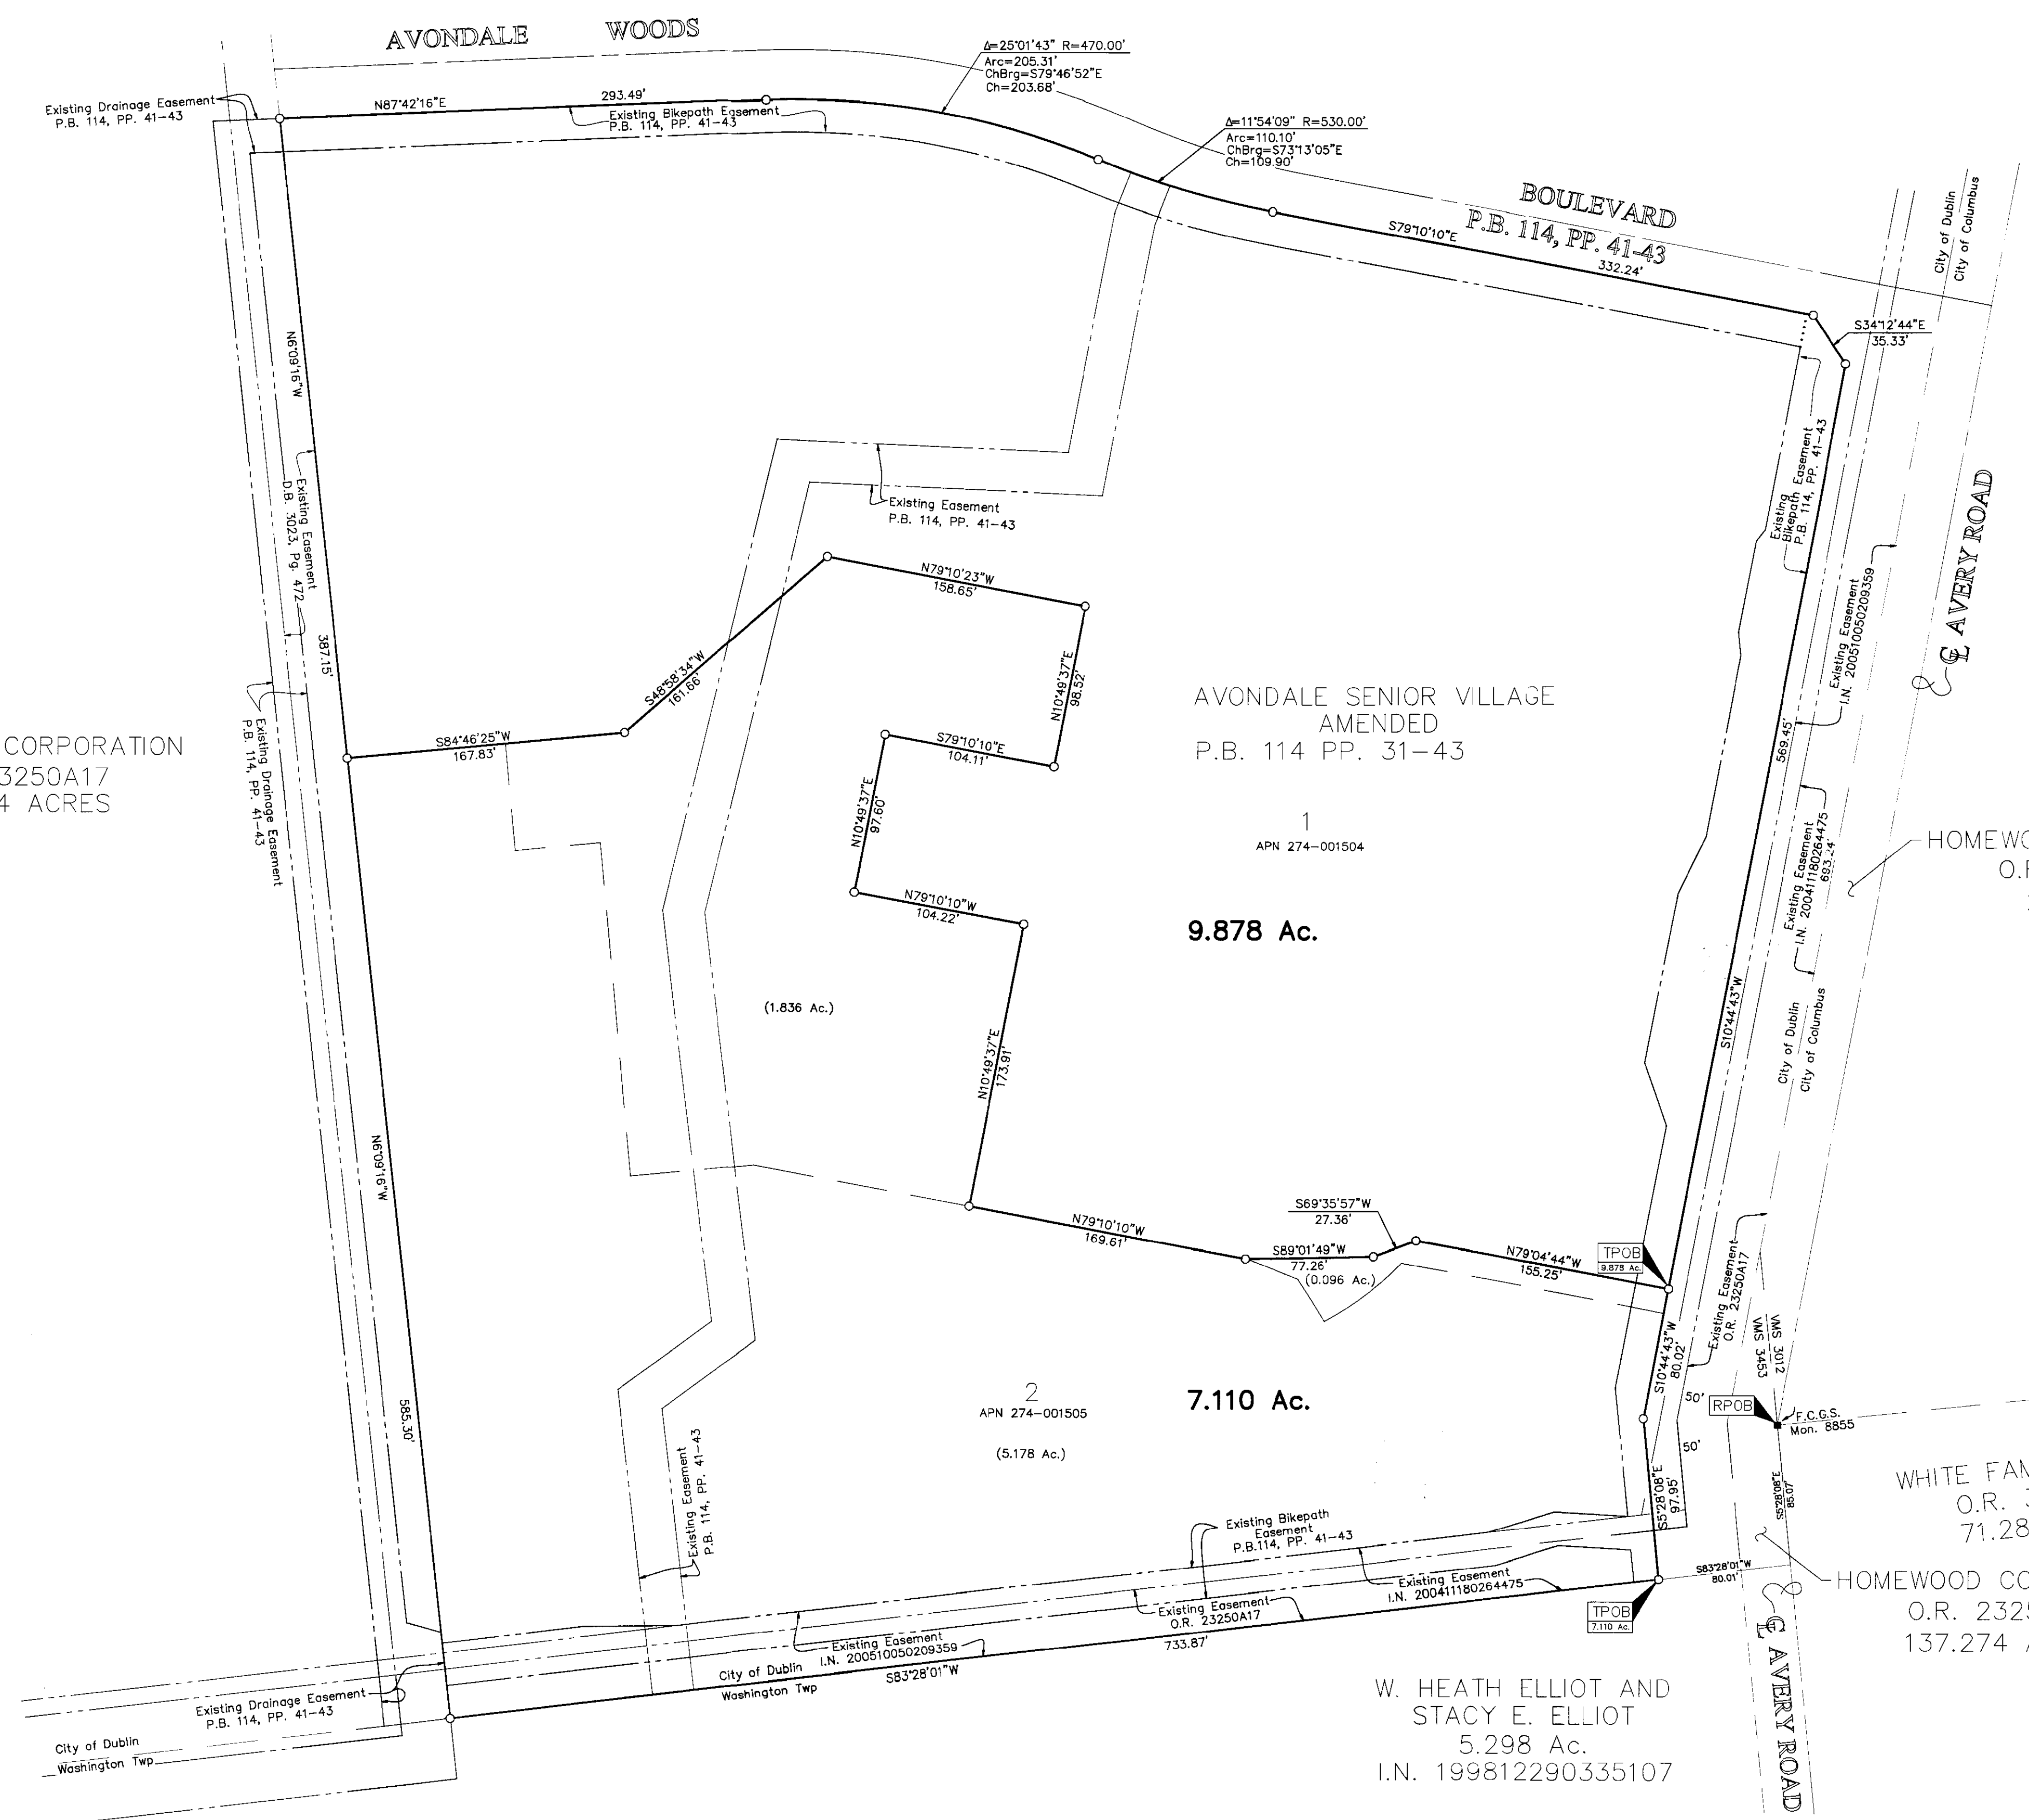

HOMEWOOD CORPORATION  
O.R. 23250A17  
137.274 ACRES

AVONDALE SENIOR VILLAGE  
AMENDED  
P.B. 114 PP. 31-43

K. & P. PARTNERSHIP  
D.B. 3745 P. 266  
28.000 ACRES

HOMEWOOD CORPORATION  
O.R. 23250A17  
2.6 ACRES

WHITE FAMILY FARM LTD.  
O.R. 34301G18  
71.282 ACRES

HOMEWOOD CORPORATION  
O.R. 23250A17  
137.274 ACRES


W. HEATH ELLIOT AND  
STACY E. ELLIOT  
5.298 Ac.  
I.N. 199812290335107

**BASIS OF BEARINGS:** The bearings shown hereon are based on the Ohio State Plane Coordinate System (South Zone) as per NAD83. Control for bearings was from coordinates of Monuments FCGS 8876 and FCGS 2221, having a bearing of North 83°53'20" East, established by the Franklin County Engineering Department, using Global Positioning System procedures and equipment.

**SURVEY NOTE:**  
This survey was prepared using documents of record, prior plats of survey, and observed evidence located by an actual field survey.

**FEMA NOTE:**  
According to the Federal Emergency Management Agency's Flood Insurance Map (dated June 17, 2008), the subject tract shown hereon lies within Zone X (areas determined to be outside of the 0.2% annual chance floodplain), Community Panel No. 39049C0133K.

- = STONE FND.
  - = MON. FND.
  - = I.P. FND.
  - = I.P. SET
  - = MAG. NAIL FND.
  - = MAG. NAIL SET
  - ▲ = R.R. SPK. FND.
  - △ = R.R. SPK. SET
  - = P.K. NAIL FND.
- I.P. Set are 13/16" I.D. iron pipe with cap inscribed EMHT INC

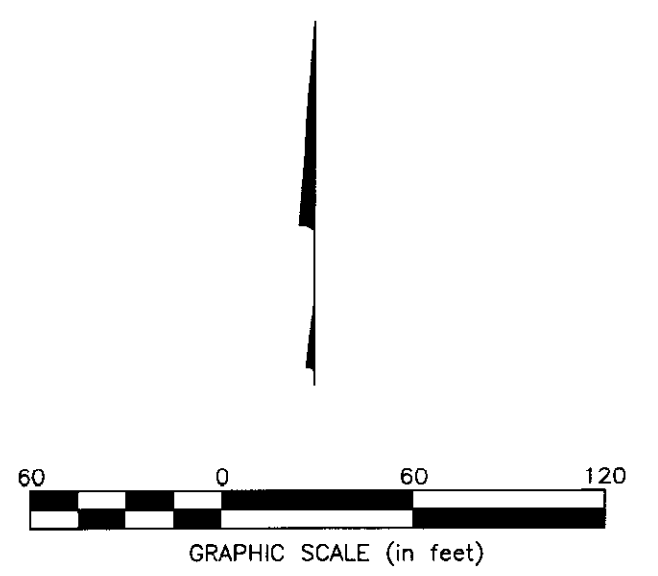

**RECEIVED**

JUN 10 2011  
Franklin County Engineer  
Dawn C. Ringle, P.E., P.S.



By Professional Surveyor No. 8250 Date 6/7/11

<b>EMHT</b>		Date: May 11, 2011
Evans, Mechwart, Hambleton & Titon, Inc. Engineers - Surveyors - Planners - Scientists 5500 New Albany Road, Columbus, OH 43054 Phone: 614.775.4500 Toll Free: 888.775.3648 emht.com		Scale: 1" = 60
		Job No: 20100907
		Sheet: 1 of 1
REVISIONS		
MARK	DATE	DESCRIPTION